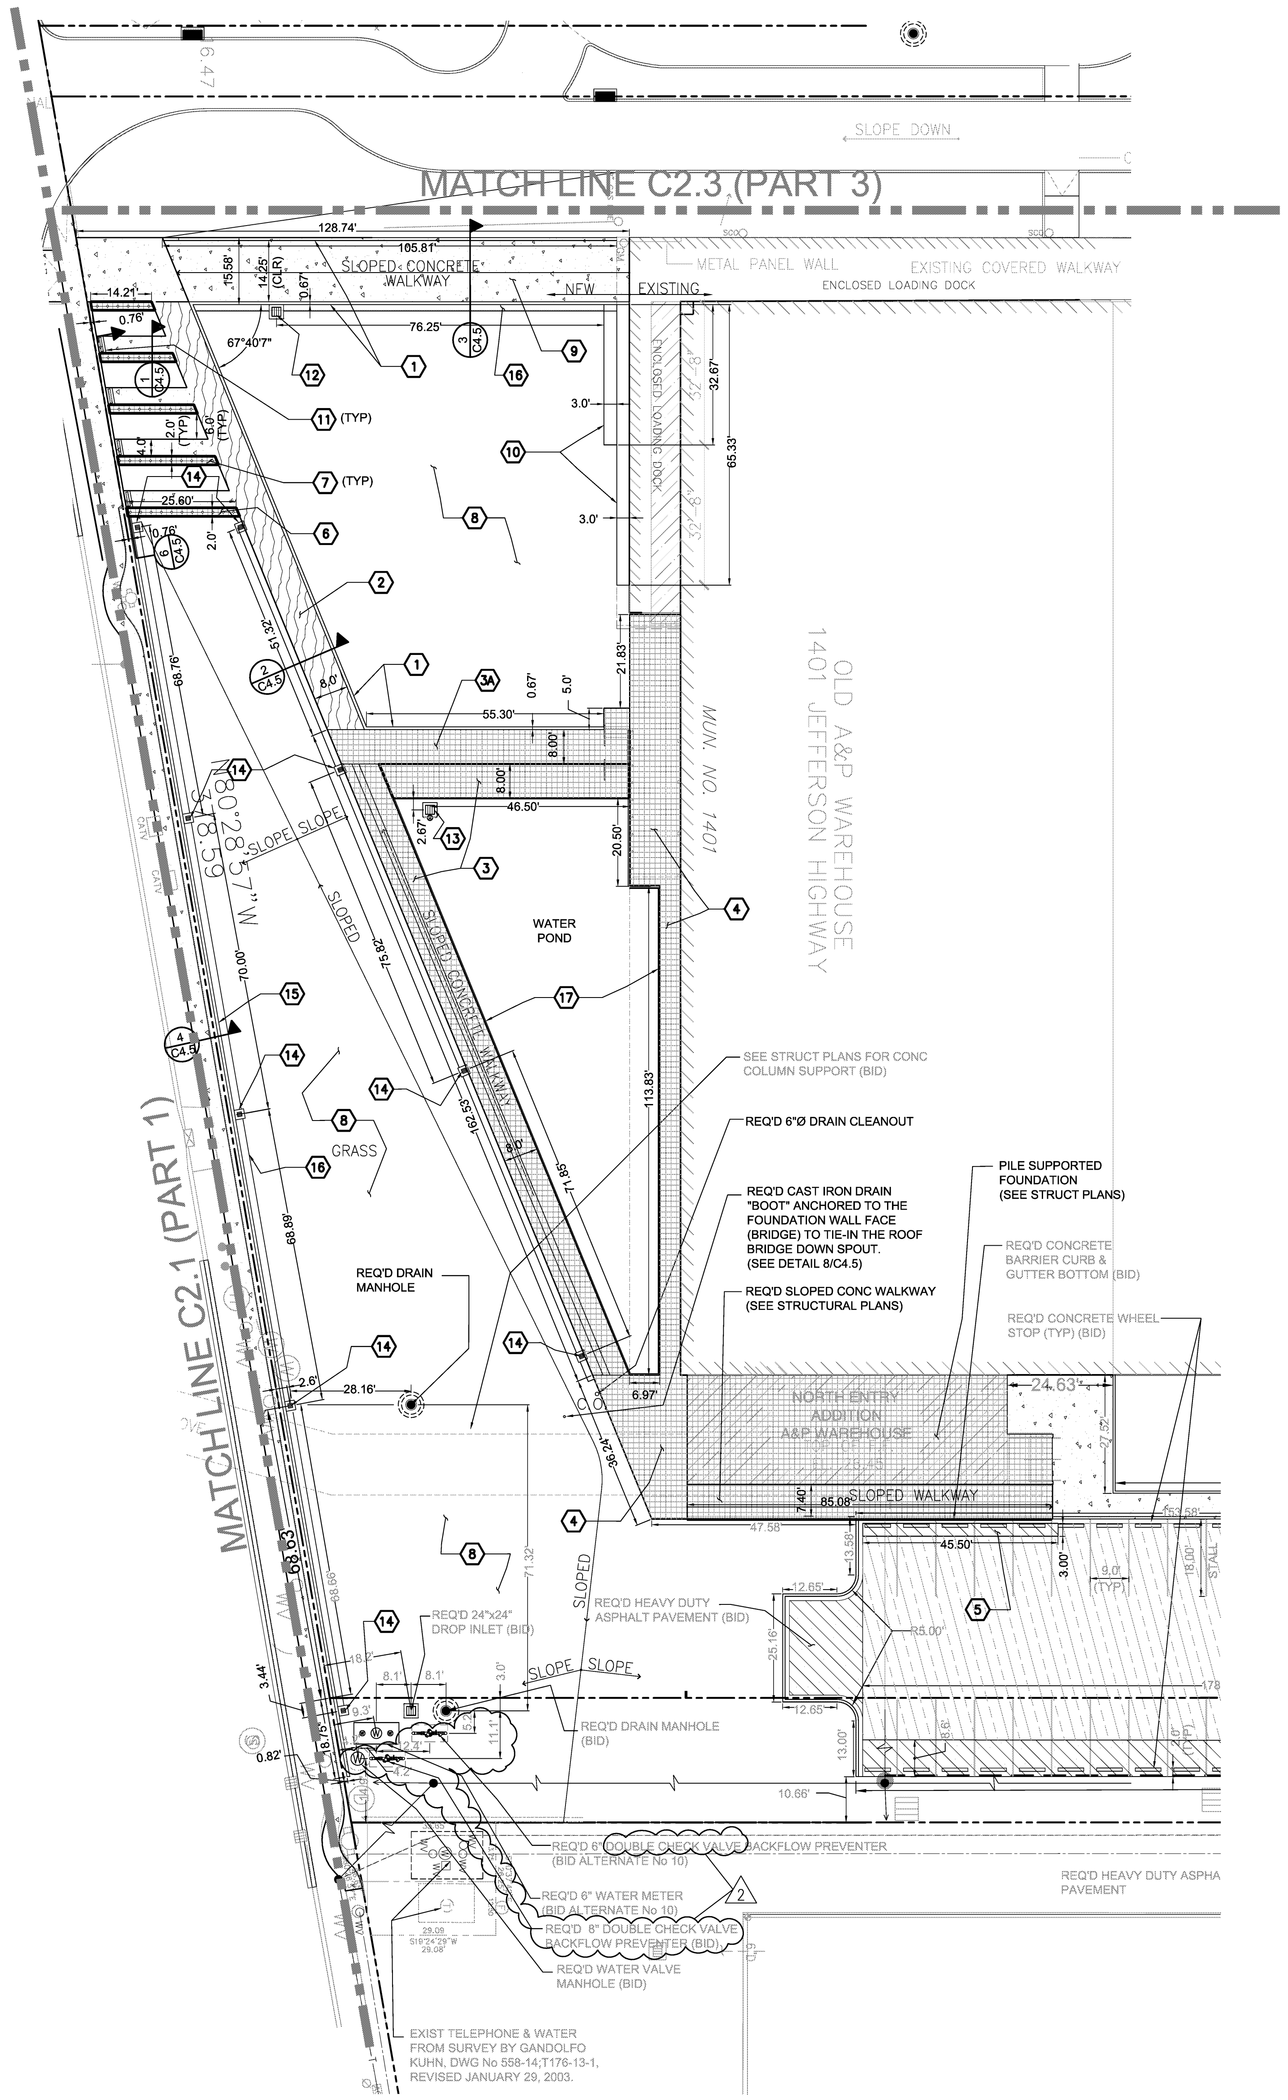

1 C2.2 CIVIL SITE PLAN (PART 2)

1" = 20'

LEGEND

- REQ'D HEAVY-DUTY ASPHALT PAVEMENT SEE DETAIL 2A/C4.1
- REQ'D 2" ASPHALT MILL & OVERLAY SEE DETAIL 2C/C4.1
- REQ'D CONCRETE SIDEWALK SEE DETAIL 6/C4.1
- PILE SUPPORTED FOUNDATION-CONCRETE. SEE STRUCTURAL PLANS
- WALKWAY SEE SECTION 2/C4.5
- REQ'D CONCRETE BENCH SEE SECTION 1/C4.5 & 6/C4.5
- REQ'D CONCRETE BARRIER CURB & GUTTER BOTTOM. SEE DETAIL 4/C4.1
- APPARENT PROPERTY LINE
- REQ'D DRAIN MANHOLE (BID) SEE DETAIL 1/C4.2
- REQ'D 24"x24" DROP INLET SEE DETAIL 2/C4.2
- REQ'D OVERFLOW CONTROL INLET W/ STAINLESS STEEL SLUICE GATE SEE DETAIL 7/C4.5
- REQ'D CATCH BASIN TYPE 1 (BID) SEE DETAIL 1/C4.4
- REQ'D DROP INLET W/ 24"x30" GRATED CASTING (BID) SEE DETAIL 4/C4.2
- REQ'D YARD DRAIN SEE DETAIL 3/C4.2
- REQ'D PRECAST TRENCH DRAIN SEE SECTION 6/C4.5
- REQ'D DRAIN CLEANOUT (BID) SEE DETAIL 7/C4.2
- REQ'D WATER VALVE MANHOLE (BID)
- REQ'D CONCRETE WHEEL STOP (BID) SEE DETAIL 7/C4.1
- REQ'D DOUBLE CHECK VALVE BACKFLOW PREVENTER
- REQ'D 6" WATER METER (BID ALTERNATE No 10). SEE DETAIL 7/C4.4

NOTE:
THIS ENTIRE SHEET IN REGARDS TO CIVIL SCOPE INDICATES WORK TO BE INCLUDED IN ALTERNATE No. 3.

SITE NOTES - ALT

1. REQ'D CONCRETE CURB (SEE SECTION 3/C4.5)
2. WALKWAY (SEE SECTION 2/C4.5)
3. WALKWAY (SEE STRUCTURAL PLANS)
3A. WALKWAY (SEE STRUCTURAL PLANS)
4. CONCRETE PAVEMENT (SEE STRUCTURAL PLANS)
5. REQ'D HEAVY DUTY ASPHALT PAVEMENT (REQ'D PORTION OF EXIST ASPHALT- OVER-CONCRETE TO BE SAW-CUT & REMOVED) (SEE DETAILS 2A/C4.1 & 2B/C4.1)
6. REQ'D CONCRETE RETAINING WALL/BENCH (SEE DETAIL 9/C4.3)
7. REQ'D CONCRETE BENCH (SEE DETAIL 1/C4.5)
8. LANDSCAPING (SEE LANDSCAPE PLANS)
9. REQ'D SLOPED CONCRETE WALKWAY (SEE SECTION 3/C4.5)
10. 3' WIDE CONCRETE STEP (F' C=3,000 PSI) (SEE ARCH PLANS)
11. REQ'D PRECAST TRENCH DRAIN (SEE SECTION 6/C4.5)
12. REQ'D 24"x24" DROP INLET (SEE DETAIL 2/C4.2)
13. REQ'D OVERFLOW CONTROL INLET (24"x24") W/ STAINLESS STEEL SLUICE GATE (SEE DETAIL 7/C4.5)
14. REQ'D YARD DRAIN (SEE DETAIL 3/C4.2)
15. REQ'D 8" CONCRETE CURB/ RETAINING WALL (SEE SECTION 4/C4.5)
16. REQ'D GRAVEL TRENCH (@ FRENCH DRAIN) (SEE SECTION 5/C4.5)
17. METAL GUARDRAIL (SEE ARCH PLANS)

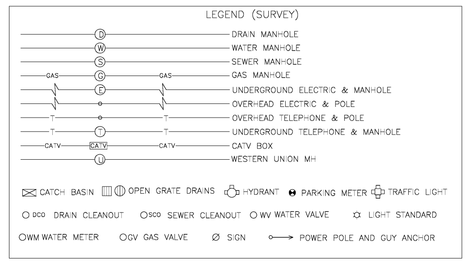

48 HOURS BEFORE DIGGING
CALL TOLL FREE
1-800-272-3020
Louisiana One Call

SCHRENK & PETERSON
CONSULTING ENGINEERS, Inc.
1424 CHURCH STREET
NEW ORLEANS, LA 70116
Phone: 504.482.7856
Fax: 504.482.7325
www.schrenkandpeterson.com

EDR
ESKEW+DUMEZ+RIPPLE
365 Canal Street, Suite 3150
New Orleans, LA 70130
T 504.561.8686
F 504.522.2253

RW
ROZAS • WARD
1100 Poydras Street, Suite 3550
New Orleans, LA 70163
T 504.524.4375
F 504.524.2493

THE ABOVE DRAWINGS AND SPECIFICATIONS AND IDEAS, DESIGNS, AND ARRANGEMENTS REPRESENTED THEREBY ARE AND SHALL REMAIN THE PROPERTY OF THE ARCHITECT, AND NO PART THEREOF SHALL BE COPIED, DISCLOSED TO OTHERS OR USED IN CONNECTION WITH ANY WORK OR PROJECT OTHER THAN THE SPECIFIC PROJECT FOR WHICH THEY HAVE BEEN PREPARED AND DEVELOPED WITHOUT THE WRITTEN CONSENT OF THE ARCHITECT. VISUAL CONTACT WITH THESE DRAWINGS OR SPECIFICATIONS SHALL CONSTITUTE CONCLUSIVE EVIDENCE OF ACCEPTANCE OF THESE RESTRICTIONS.

WRITTEN DIMENSIONS ON THESE DRAWINGS SHALL HAVE PRECEDENCE OVER SCALED DIMENSIONS; CONTRACTORS SHALL VERIFY, AND BE RESPONSIBLE FOR, ALL DIMENSIONS AND CONDITIONS ON THE JOB AND THIS OFFICE MUST BE NOTIFIED OF ANY VARIATIONS FROM THE DIMENSIONS AND CONDITIONS SHOWN BY THESE DRAWINGS. SHOP DETAILS MUST BE SUBMITTED TO THIS OFFICE FOR APPROVAL BEFORE PROCEEDING WITH FABRICATION.

OCHSNER NORTH CAMPUS INTERNAL MEDICINE RELOCATION

OCHSNER MEDICAL CENTER

1401 Jefferson Highway
Jefferson, LA 70121

Copyright © 2010
Eskew+Dumez+Ripple /
Rozas-Ward, Joint Venture

Date:	16 DECEMBER 2010
1 ADDN #2	03 JAN 2011
2 J.P. REVIEW	15 MAR 2011

CIVIL SITE PLAN

EDR No. 09023	
RWA No. 09024	
drawn:	SHU
checked:	RMF
approved:	
sheet:	1 ALT C2.2

T:\Civil\5660 Ochsner North Campus Ph II\DWGS\DWGS PH II - (Part 1,2,3)\5660-ALT C2.2.dwg
15 May 11 - 10:08am