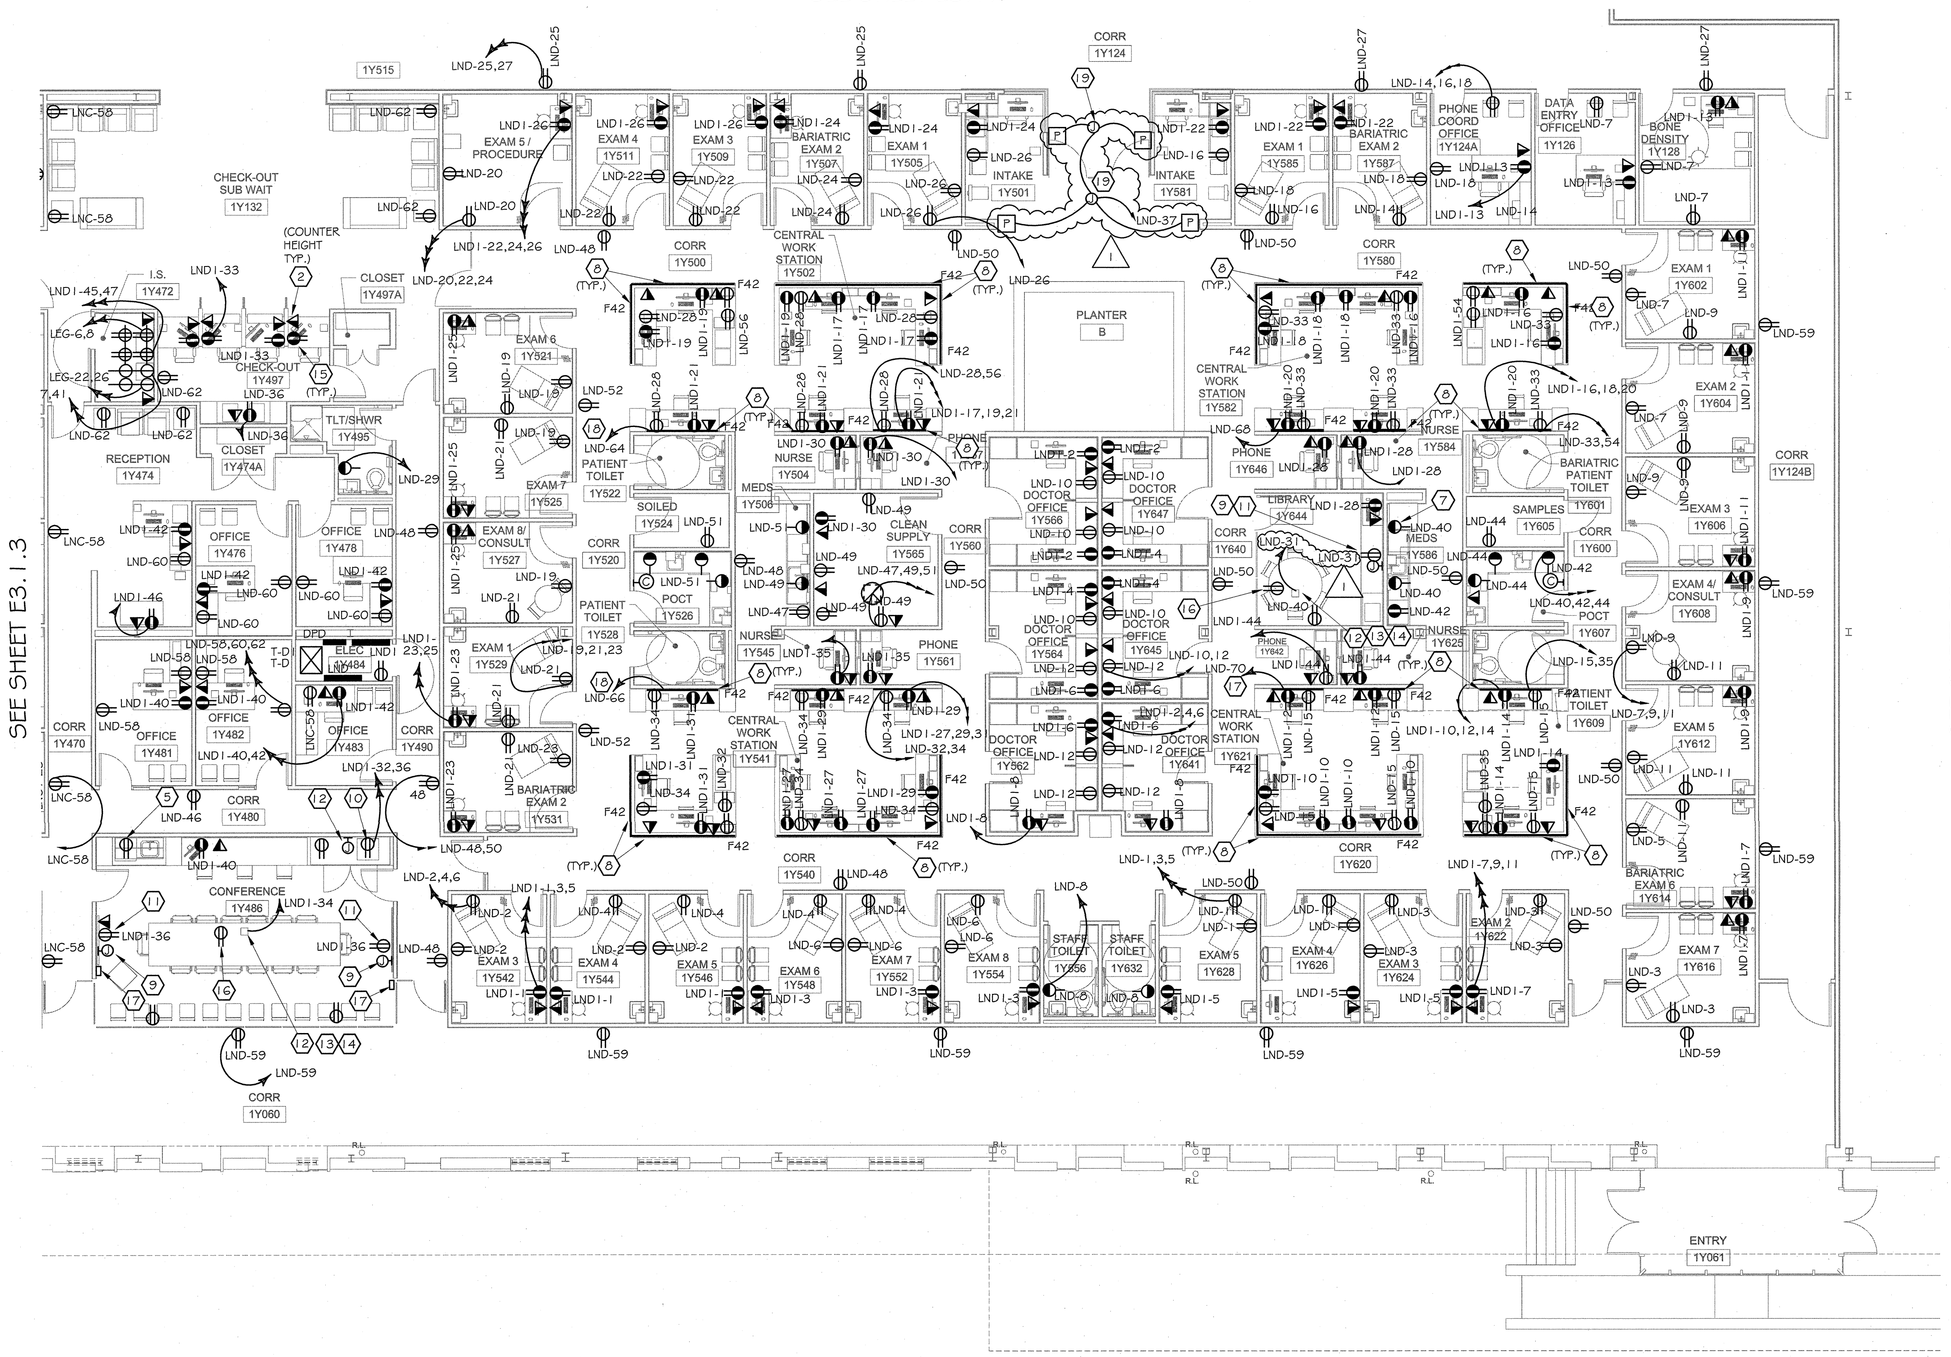

SPECIFIC ALTERNATE NOTES: (THIS SHEET)

DEDUCT ALTERNATE No.1
CENTRAL WORK STATION - ELECTRICAL CONTRACTOR TO ONLY PROVIDE ELECTRICAL AND DATA CONNECTIONS TO PRE-WIRED PARTITIONS. PARTITIONS WILL BE EQUIPPED WITH TASK LIGHTS. ELECTRICAL CONTRACTOR TO COORDINATE WITH FURNITURE MANUFACTURER TO ENSURE THE ELECTRICAL CONNECTIONS ARE AS SHOWN AND PROVIDE ADEQUATE CIRCUITING FOR EQUIPMENT.

DEDUCT ALTERNATE No.2
DOCTORS OFFICE MILLWORK - ELECTRICAL CONTRACTOR TO ONLY PROVIDE ELECTRICAL AND DATA CONNECTIONS TO PRE-WIRED PARTITIONS. PARTITIONS WILL BE EQUIPPED WITH TASK LIGHTS. ELECTRICAL CONTRACTOR TO COORDINATE WITH FURNITURE MANUFACTURER TO ENSURE THE ELECTRICAL CONNECTIONS ARE AS SHOWN AND PROVIDE ADEQUATE CIRCUITING FOR EQUIPMENT.

DEDUCT ALTERNATE No.3
DOCTORS OFFICE MILLWORK - ELECTRICAL CONTRACTOR TO ONLY PROVIDE ELECTRICAL AND DATA CONNECTIONS TO PRE-WIRED PARTITIONS. ELECTRICAL CONTRACTOR TO COORDINATE WITH FURNITURE MANUFACTURER TO ENSURE THE ELECTRICAL CONNECTIONS ARE AS SHOWN AND PROVIDE ADEQUATE CIRCUITING FOR EQUIPMENT.

1 FIRST FLOOR POWER PLAN

3.1.4 SECTION 2 – AREA D 1/8" = 1'-0"

SPECIFIC NOTES (THIS SHEET ONLY):

1. ROUTE WIRING BELOW RAISED FLOOR TO RECEPTACLE ON SAME CIRCUIT AT FULL HEIGHT PARTITION.
2. ROUTE CONDUIT WITH PULL STRING TO NEAREST FULL HEIGHT PARTITION AND THEN ROUTE OVER HEAD TO CABLE TRAY. SEE SYSTEMS PLAN FOR CABLE TRAY ROUTING.
3. NOT USED
4. NOT USED
5. NOT USED
6. NOT USED
7. FOR UNDER COUNTER REFRIGERATOR.
8. UNDERCOUNTER TASK LIGHTING. SEE LIGHTING FIXTURE SCHEDULE. (TYPICAL FOR (4) WORKSTATIONS. ALL TASK LIGHTING LIGHTING TO BE WIRED ON SAME CIRCUIT. WIRING TO BE CONCEALED, ROUTED UNDER RAISED FLOOR TO FULL HEIGHT PARTITION AND THEN OVERHEAD TO PANEL.
9. PROVIDE JUNCTION BOX IN LOCATION AS REQUIRED FOR TV. FOR DATA PROVIDE 1" CONDUIT WITH PULL STRING TO ABOVE CEILING AND BUSH. EXACT LOCATION TOP BE DETERMINED IN THE FIELD WITH THE AV SUPPLIER/ARCHITECT AND OWNER'S REPRESENTATIVE.
10. FOR EQUIPMENT RACK.
11. PROVIDE RECEPTACLE AT HEIGHT AS REQUIRED TO ACCOMMODATE TV. EXACT LOCATION TO BE DETERMINED IN THE FIELD WITH THE ARCHITECT AND OWNER'S REPRESENTATIVE.
12. ROUTE 1 1/2" CONDUIT FROM CABLE CUDDY IN TABLE, UNDER RAISED FLOOR TO JUNCTION BOX IN EQUIPMENT RACK. EXACT LOCATION TO BE DETERMINED IN THE FIELD WITH THE AV SUPPLIER/ARCHITECT AND OWNER'S REPRESENTATIVE.
13. ROUTE 2 #12'S AND 1 #12, GROUND 3/4" C UNDER RAISED FLOOR TO COMPUTER RECEPTACLE AT CONFERENCE TABLE. EXACT LOCATION TO BE DETERMINED IN THE FIELD WITH THE AV SUPPLIER/ARCHITECT AND OWNER'S REPRESENTATIVE.
14. APPROXIMATE LOCATION OF FLOOR PENETRATIONS FOR CONNECTIONS TO CABLE CUDDY. CABLE CUDDY TO BE PROVIDED BY EQUIPMENT SUPPLIER. COORDINATE EXACT LOCATION IN THE FIELD WITH THE AV SUPPLIER/ARCHITECT AND OWNER'S REPRESENTATIVE.
15. MOUNT RECEPTACLE AT COUNTER HEIGHT. WIRING TO BE CONCEALED IN WALL. ROUTE HOMERUNS UNDER RAISED STRUCTURE TO NEAREST FULL HEIGHT PARTITION AND THEN OVERHEAD TO PANEL.
16. MOUNT RECEPTACLE ON UNDERSIDE OF TABLE AND CONNECT TO POWER CONNECTIONS FOR CABLE CUDDY.
17. COORDINATE LOCATION OF WALL MOUNTED SPEAKERS. PROVIDE BACKBOX AND 1/2" CONDUIT TO CEILING AND BUSH.
18. CIRCUIT FOR TASK LIGHTING.
19. PROVIDE JUNCTION BOX IN CEILING IN AN ACCESSIBLE LOCATION AND CONNECT TO DOOR SYSTEM AS REQUIRED BY DATA SUPPLIED WITH DOOR SYSTEM. DOORS TO OPEN UPON ACTIVATION OF FIRE ALARM SYSTEM.

DEMOLITION NOTES:

1. CONTRACTOR SHALL REMOVE ALL ELECTRICAL EXISTING LIGHTING FIXTURES, DEVICES, PANELS, BOXES, CONDUIT WIRING, SPECIAL SYSTEMS AND OTHER ELECTRICAL APPARATUS IN AREAS WHERE NEW WORK IS BEING ACCOMPLISHED.
2. WHERE EXISTING LIGHTING FIXTURES ARE IN ADJACENT AREAS AND ARE SERVED THROUGH LIGHTING FIXTURES WHICH ARE IN AREAS BEING RENOVATED. CONTRACTOR SHALL CUT EXISTING CONDUITS AT BUILDING LINE OF NEW WORK AND REMOVE WIRING BACK TO SOURCE OR NEAREST OUTLET TO REMAIN. REMOVE EXISTING LIGHT FIXTURES AND PROVIDE NEW AS SHOWN ON LIGHTING PLANS.
3. WHERE OUTLETS, PANELS, ETC. IN ADJACENT AREAS ARE SERVED BY THROUGH OUTLETS, PANELS, ETC WHICH ARE IN AREAS BEING RENOVATED . CONTRACTOR SHALL CUT EXISTING CONDUITS OR EQUIPMENT AT BUILDING LINE OF NEW WORK AND REMOVE WIRING BACK TO SOURCE OR NEAREST OUTLET TO REMAIN. PROVIDE RECEPTACLES AS SHOWN ON POWER PLANS.

WDG | ARCHITECTS ENGINEERS
1100 POYDRAS ST. SUITE 1360 · NOLA 70163 · t. 504.754.5280

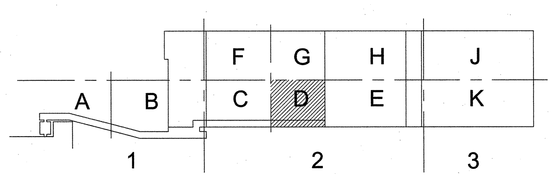

KEY PLAN

EDR
ESKEW+DUMEZ+RIPPLE
365 Canal Street, Suite 3150
New Orleans, LA 70130
T 504.561.8686
F 504.522.2253

RW
ROZAS • WARD
1100 Poydras Street, Suite 3550
New Orleans, LA 70163
T 504.524.4375
F 504.524.2460

THE ABOVE DRAWINGS AND SPECIFICATIONS AND IDEAS, DESIGNS, AND ARRANGEMENTS REPRESENTED THEREBY ARE AND SHALL REMAIN THE PROPERTY OF THE ARCHITECT; AND NO PART THEREOF SHALL BE COPIED, DISCLOSED TO OTHERS OR USED IN CONNECTION WITH ANY WORK OR PROJECT OTHER THAN THE SPECIFIC PROJECT FOR WHICH THEY HAVE BEEN PREPARED AND DEVELOPED WITHOUT THE WRITTEN CONSENT OF THE ARCHITECT. VISUAL CONTACT WITH THESE DRAWINGS OR SPECIFICATIONS SHALL CONSTITUTE CONCLUSIVE EVIDENCE OF ACCEPTANCE OF THESE RESTRICTIONS.

WRITTEN DIMENSIONS ON THESE DRAWINGS SHALL HAVE PRECEDENCE OVER SCALED DIMENSIONS; CONTRACTORS SHALL VERIFY, AND BE RESPONSIBLE FOR, ALL DIMENSIONS AND CONDITIONS ON THE JOB AND THIS OFFICE MUST BE NOTIFIED OF ANY VARIATIONS FROM THE DIMENSIONS AND CONDITIONS SHOWN BY THESE DRAWINGS. SHOP DETAILS MUST BE SUBMITTED TO THIS OFFICE FOR APPROVAL BEFORE PROCEEDING WITH FABRICATION.

OCHSNER NORTH CAMPUS INTERNAL MEDICINE RELOCATION

OCHSNER MEDICAL CENTER

1401 Jefferson Highway
Jefferson, LA 70121

Copyright © 2010
Eskew+Dumez+Ripple /
Rozas-Ward, Joint Venture

Date:	16 MAY 2011
1 ADD #3	13 JANUARY 2010

STATE OF LOUISIANA
NATHAN MCKNIGHT
REGISTERED
PROFESSIONAL ENGINEER
IN
ELECTRICAL ENGINEERING
16 MAY 2011

POWER FIRST FLOOR PLAN SECTION 2 - AREA D	
EDR No. 09023	
RWA No. 09024	
drawn:	DAB
checked:	DAB
approved:	SNM
sheet:	

E3.1.4