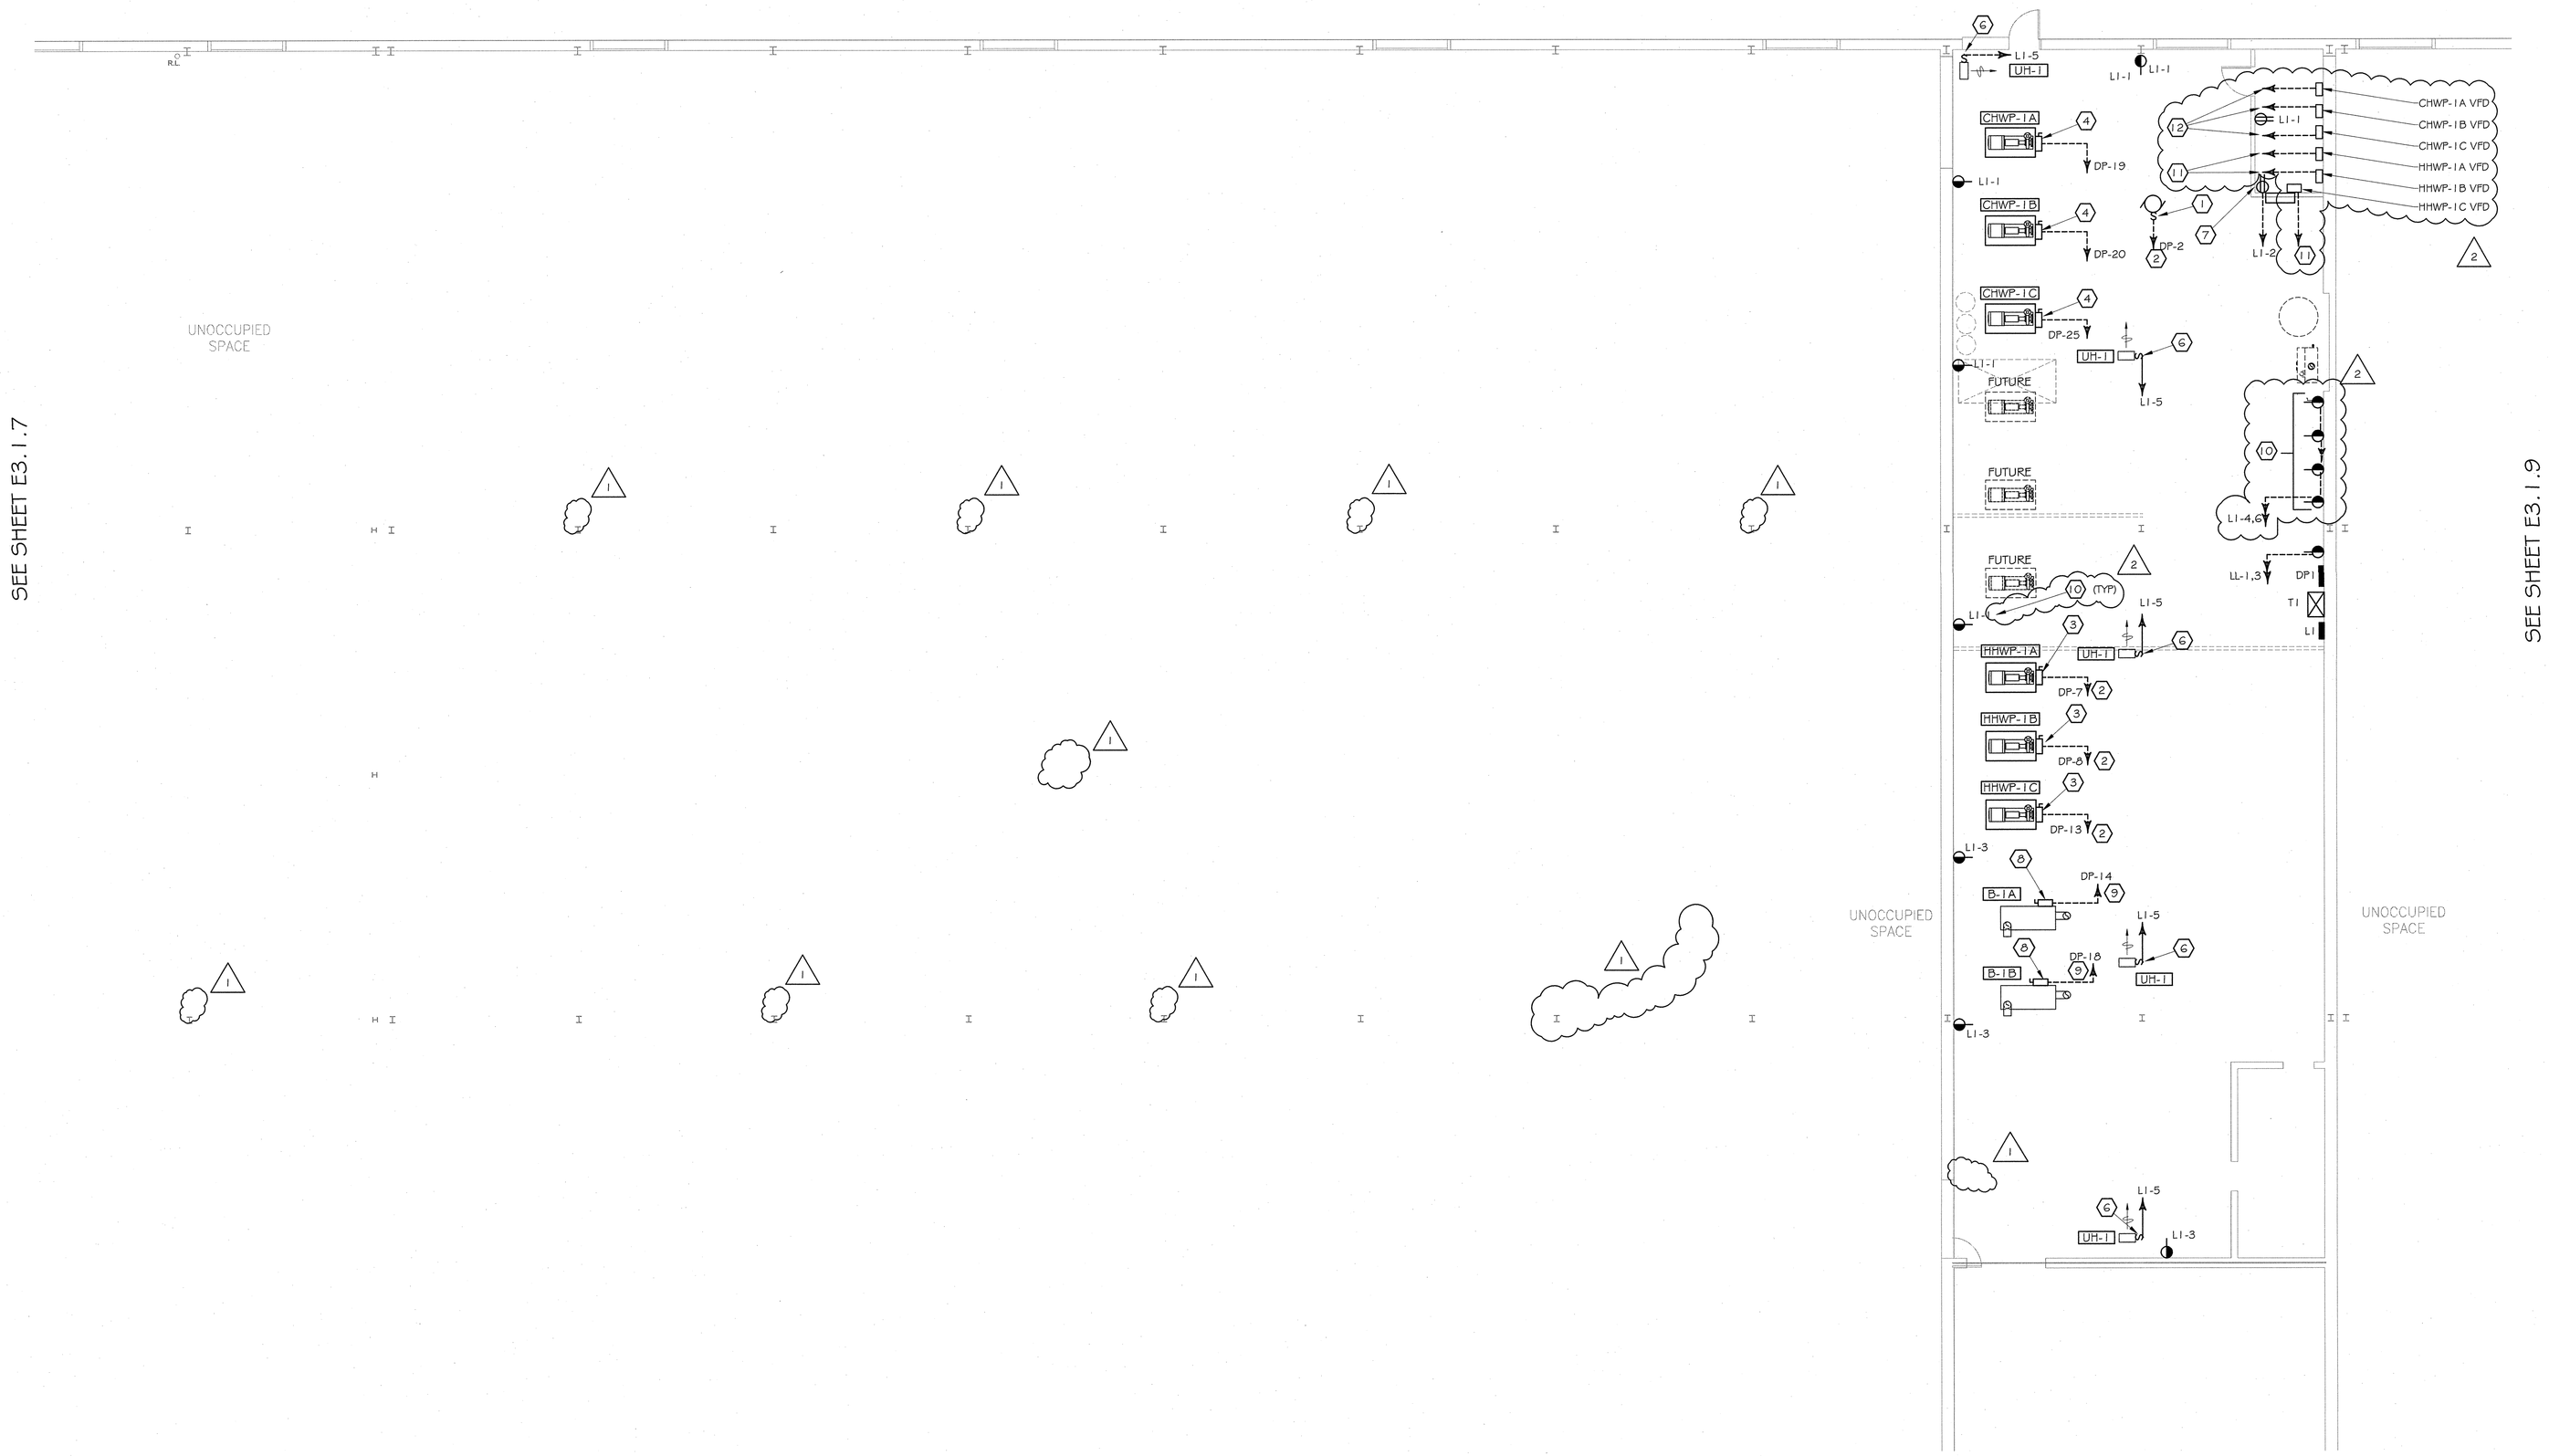

2 FIRST FLOOR POWER PLAN
3.1.8 SECTION 2 – AREA H 1/8" = 1'-0"

SPECIFIC NOTES (THIS SHEET ONLY):

1. SUPPLY FAN, 480V, 3Ø. PROVIDE SWITCH AT UNIT FOR SIGHT DISCONNECTING MEANS.
2. 3#10, 1#12 GROUND IN 3/4" CONDUIT.
3. HHWP - 10HP, 480V, 3Ø. PROVIDE 30A/3P NON FUSED DISCONNECT SWITCH FUSED SWITCH AND CONNECT TO UNIT AS REQUIRED.
4. CHWP - 75HP, 480V, 3Ø. PROVIDE 200A/3P DISCONNECT SWITCH FUSED AT 150AMPS. CONNECT TO UNIT AS REQUIRED
5. 3#1/0, 1#6 GROUND, 1-1/2" CONDUIT.
6. UNIT HEATER - 1/20HP, 120V. PROVIDE SWITCH AT UNIT FOR SIGHT DISCONNECTING MEANS.
7. FOR DDC PANEL. VERIFY EXACT LOCATION. PRIOR TO ROUGH IN.
8. BOILER, 11AMPS, 208V, 1Ø. PROVIDE 30A/2P NON-FUSED DISCONNECT SWITCH AT UNIT AND CONNECT TO UNIT AS REQUIRED.
9. 2#12, 1#12 GROUND IN 3/4" CONDUIT.
10. SURFACE MOUNT RECEPTACLE ON COLUMN. RUN WIRING EXPOSED IN RACEWAYS, TYPICAL FOR ENTIRE AREA.
11. 3#10, 1#12 GROUND IN 3/4" CONDUIT, RUN THROUGH DISCONNECT SWITCH AND CONNECT TO HHWP AS REQUIRED.
12. 3#1/0, 1#6 GROUND, 1-1/2" CONDUIT, RUN THROUGH DISCONNECT SWITCH AND CONNECT TO CHWP AS REQUIRED.

DEMOLITION NOTES:

1. CONTRACTOR SHALL REMOVE ALL ELECTRICAL EXISTING LIGHTING FIXTURES, DEVICES, PANELS, BOXES, CONDUIT WIRING, SPECIAL SYSTEMS AND OTHER ELECTRICAL APPARATUS IN AREAS WHERE NEW WORK IS BEING ACCOMPLISHED.
2. WHERE EXISTING LIGHTING FIXTURES ARE IN ADJACENT AREAS AND ARE SERVED THROUGH LIGHTING FIXTURES WHICH ARE IN AREAS BEING RENOVATED, CONTRACTOR SHALL CUT EXISTING CONDUITS AT BUILDING LINE OF NEW WORK AND REMOVE WIRING BACK TO SOURCE OR NEAREST OUTLET TO REMAIN. REMOVE EXISTING LIGHT FIXTURES AND PROVIDE NEW AS SHOWN ON LIGHTING PLANS.
3. WHERE OUTLETS, PANELS, ETC. IN ADJACENT AREAS ARE SERVED BY THROUGH OUTLETS, PANELS, ETC WHICH ARE IN AREAS BEING RENOVATED. CONTRACTOR SHALL CUT EXISTING CONDUITS OR EQUIPMENT AT BUILDING LINE OF NEW WORK AND REMOVE WIRING BACK TO SOURCE OR NEAREST OUTLET TO REMAIN. PROVIDE RECEPTACLES AS SHOWN ON POWER PLANS.

WDG | ARCHITECTS ENGINEERS
1100 POYDRAS ST. SUITE 1360 · NOLA 70163 · t. 504.754.5280

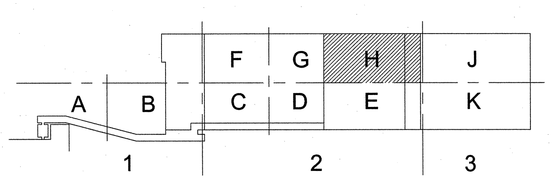

KEY PLAN

EDR
ESKEW+DUMEZ+RIPPLE
365 Canal Street, Suite 3150
New Orleans, LA 70130
T 504.561.8686
F 504.522.2253

RW
ROZAS • WARD
1100 Poydras Street, Suite 3550
New Orleans, LA 70163
T 504.524.4375
F 504.524.2493

THE ABOVE DRAWINGS AND SPECIFICATIONS AND IDEAS, DESIGNS, AND ARRANGEMENTS REPRESENTED THEREBY ARE AND SHALL REMAIN THE PROPERTY OF THE ARCHITECT; AND NO PART THEREOF SHALL BE COPIED, DISCLOSED TO OTHERS OR USED IN CONNECTION WITH ANY WORK OR PROJECT OTHER THAN THE SPECIFIC PROJECT FOR WHICH THEY HAVE BEEN PREPARED AND DEVELOPED WITHOUT THE WRITTEN CONSENT OF THE ARCHITECT. VISUAL CONTACT WITH THESE DRAWINGS OR SPECIFICATIONS SHALL CONSTITUTE CONCLUSIVE EVIDENCE OF ACCEPTANCE OF THESE RESTRICTIONS.
WRITTEN DIMENSIONS ON THESE DRAWINGS SHALL HAVE PRECEDENCE OVER SCALED DIMENSIONS; CONTRACTORS SHALL VERIFY, AND BE RESPONSIBLE FOR, ALL DIMENSIONS AND CONDITIONS ON THE JOB AND THIS OFFICE MUST BE NOTIFIED OF ANY VARIATIONS FROM THE DIMENSIONS AND CONDITIONS SHOWN BY THESE DRAWINGS. SHOP DETAILS MUST BE SUBMITTED TO THIS OFFICE FOR APPROVAL BEFORE PROCEEDING WITH FABRICATION.

OCHSNER NORTH CAMPUS INTERNAL MEDICINE RELOCATION

OCHSNER MEDICAL CENTER

1401 Jefferson Highway
Jefferson, LA 70121

Copyright © 2010
Eskew+Dumez+Ripple /
Rozas-Ward, Joint Venture

Date:	16 MAY 2011
1 ADD #3	13 JANUARY 2010
2 ADD #5	17 JANUARY 2011

STATE OF LOUISIANA
S. NORMAN SNYDER
No. 32,778
REGISTERED PROFESSIONAL ENGINEER IN ELECTRICAL ENGINEERING
10/04/2011

POWER
FIRST FLOOR PLAN
SECTION 2 - AREA H

EDR No. 09023	
RWA No. 09024	
drawn:	BGM
checked:	DAB
approved:	SNM
sheet:	

E3.1.8