

1 ELECTRICAL LIGHTING PLAN
SCALE: 1/4" = 1'-0"

| Label Symbol | Description | Catalog # | Total Load (Watts) |
|--------------|--|---|--------------------|
| F1, F4, FIE | 2x4' Fluorescent Lay-in Fixture FIE Designated to be Emergency with Battery Backup | 26TL, 4 48L, E21, LP935 | 46w |
| F2 | 2x4' Fluorescent Lay-in Fixture | 26TL, 4 40L, E21, LP935 | 46w |
| F3 | 2x4' Fluorescent Lay-in Fixture | 26TL, 4 60L, E21, LP935 | 46w |
| F4 | 2x2' LED Surface Mount | LB2, 20L, E21, LP935 | 46w |
| F5, F, FFE | 6' Fluorescent Downlight FFE Indicates to Add Battery Backup | LPN6 35/115 L06AR T8M 120 EL | 42w |
| F6 | Exterior Wall Pack LED Lininaire | LIGNIA NSQ-LED 1 10X100/20K 964 WVOLT FE IV PHOTO CONTROL | 24w |
| F7 | Slide Lower Cabinet Mini-Fluorescent Light | 1 EACH STRIP BULB | 10.4w |
| F8 | Parking Lot Lininaire | TECH LIGHT - LB93628781 | 20.4w |
| F9 | Emergency Egress Light w/ 90 Min. Battery Backup | 2 LAMPFS 85-4W EACH HALOGEN | 10.8w |
| X1 | Wall Mounted LED Exit Sign | LED | 2.4w |
| X2 | Emergency Egress/Exit LED Light Combo w/ 90 Min. Battery Backup | LED | 12w |
| X3 | Wall Mounted LED Exit Sign with Directional Arrow | LED | 2.4w |
| S1 | Switch Commercial Grade 20 AMP 120V | N/A | |
| S2 | Three-Way Switch Commercial Grade 20 AMP 120V | N/A | |
| S3 | Occupancy Sensor Commercial Grade 20 AMP 120V | LITRON L05-CDT 2000 AND POWER PACK | |


LIGHTING FIXTURE SCHEDULE

DAMMON
ENGINEERING, INC.
LOUISIANA & MISSISSIPPI

Job No. 215036.01
Drawn by JTL
Checked by CD
Date 1/23/2016
Sheet No. E2.2

| Issue | Date | Remark |
|-------|----------|-------------------------------------|
| 1 | 4/8/2016 | UPDATED LIGHTING FIXTURES AND CENTS |

SHEET NAME
ELECTRICAL LIGHTING PLAN

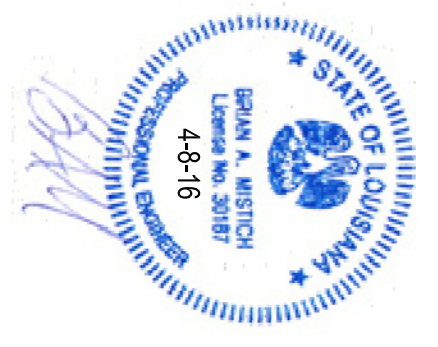

A NEW DENTAL OFFICE
CORE SMILE CENTER
La Highway 25 & Regina Coeli Rd
COVINGTON, LA



greenleafarchitects
985 778 2080 designcollaboratedeliver