


01-FRONT ELEVATION  
SCALE: 1/8" = 1'-0"

E-143

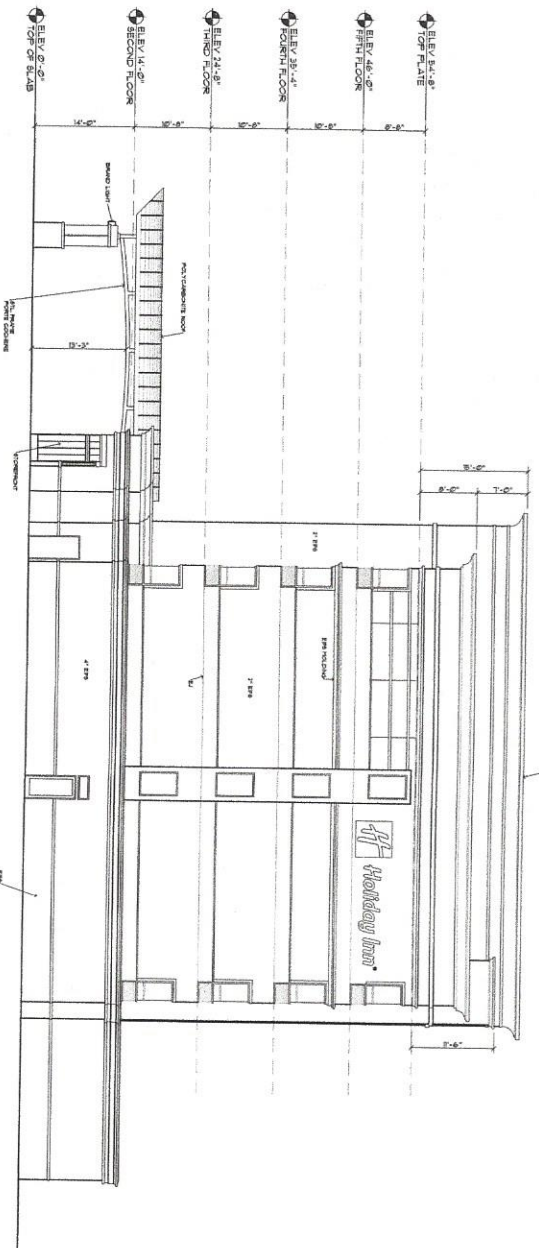

02-SIDE ELEVATION  
SCALE: 1/8" = 1'-0"

NORTH

SHEET NO.  
A2.13

DATE  
1-6-12

**N** NORMAN PATTEN & ASSOC.  
ARCHITECTURE & PLANNING  
415 CEDAR ST. @ MAIN - CEDAR HILL, TX 75104 - 972/ 293 - 2929  
npatten@flash.net

**H** Holiday Inn  
FULL SERVICE  
DOVINGTON, LA


OWNER/DEVELOPER  
MIKE DESAI  
TEL: (601) 415-5515  
432 GARDEN GROVE STREET  
VICKSBURG, MS 39180



REVISIONS:


01-BACK ELEVATION  
SCALE: 1/8" = 1'-0"

WEST

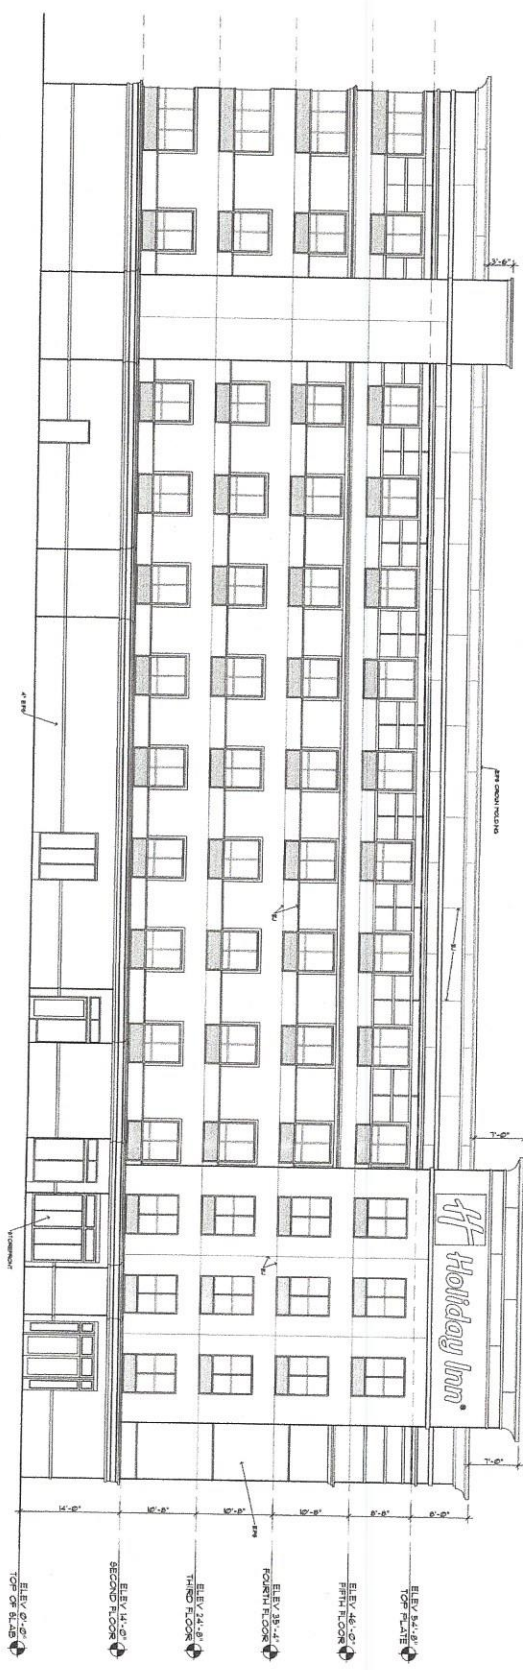

02-SIDE ELEVATION  
SCALE: 1/8" = 1'-0"

SOUTH

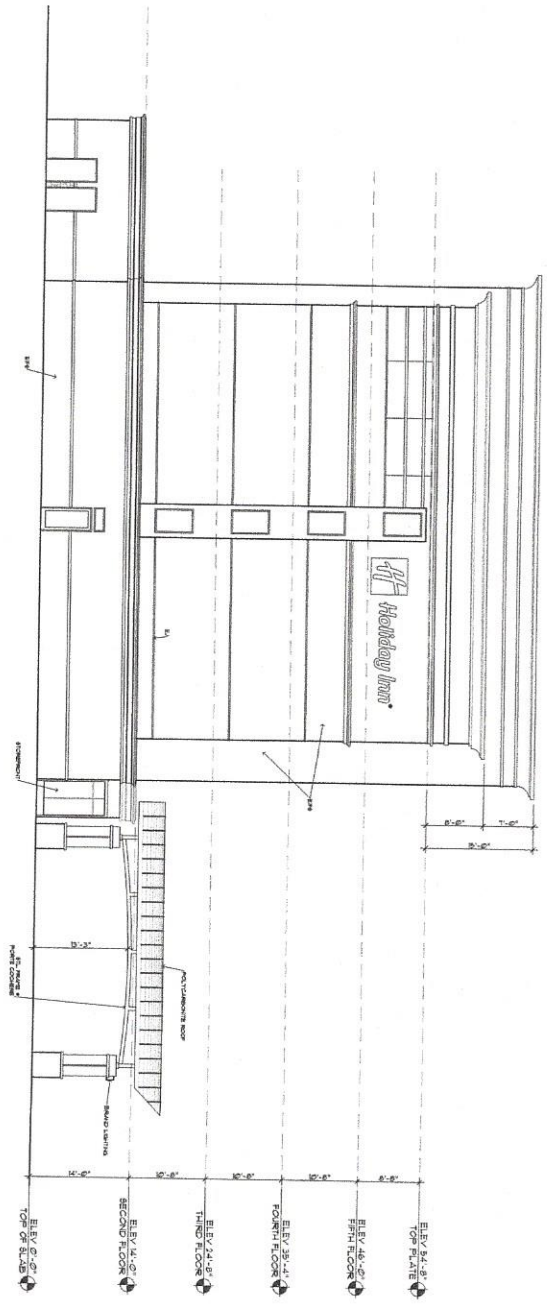

SHEET NO.  
A2.14

JOB NO.  
1121

DATE  
7-6-12


**N** NORMAN PATTEN & ASSOC.  
ARCHITECTURE & PLANNING  
415 CEDAR ST. @ MAIN - CEDAR HILL, TX 75104 - 972/293-2929  
npatten@flash.net

**H** Holiday Inn  
FULL SERVICE  
COVINGTON, LA

OWNER/DEVELOPER  
MIKE DESAI  
TEL \* (601) 415-5515  
432 GARDEN GROVE STREET  
VICKSBURG, MS 39160



REVISIONS:

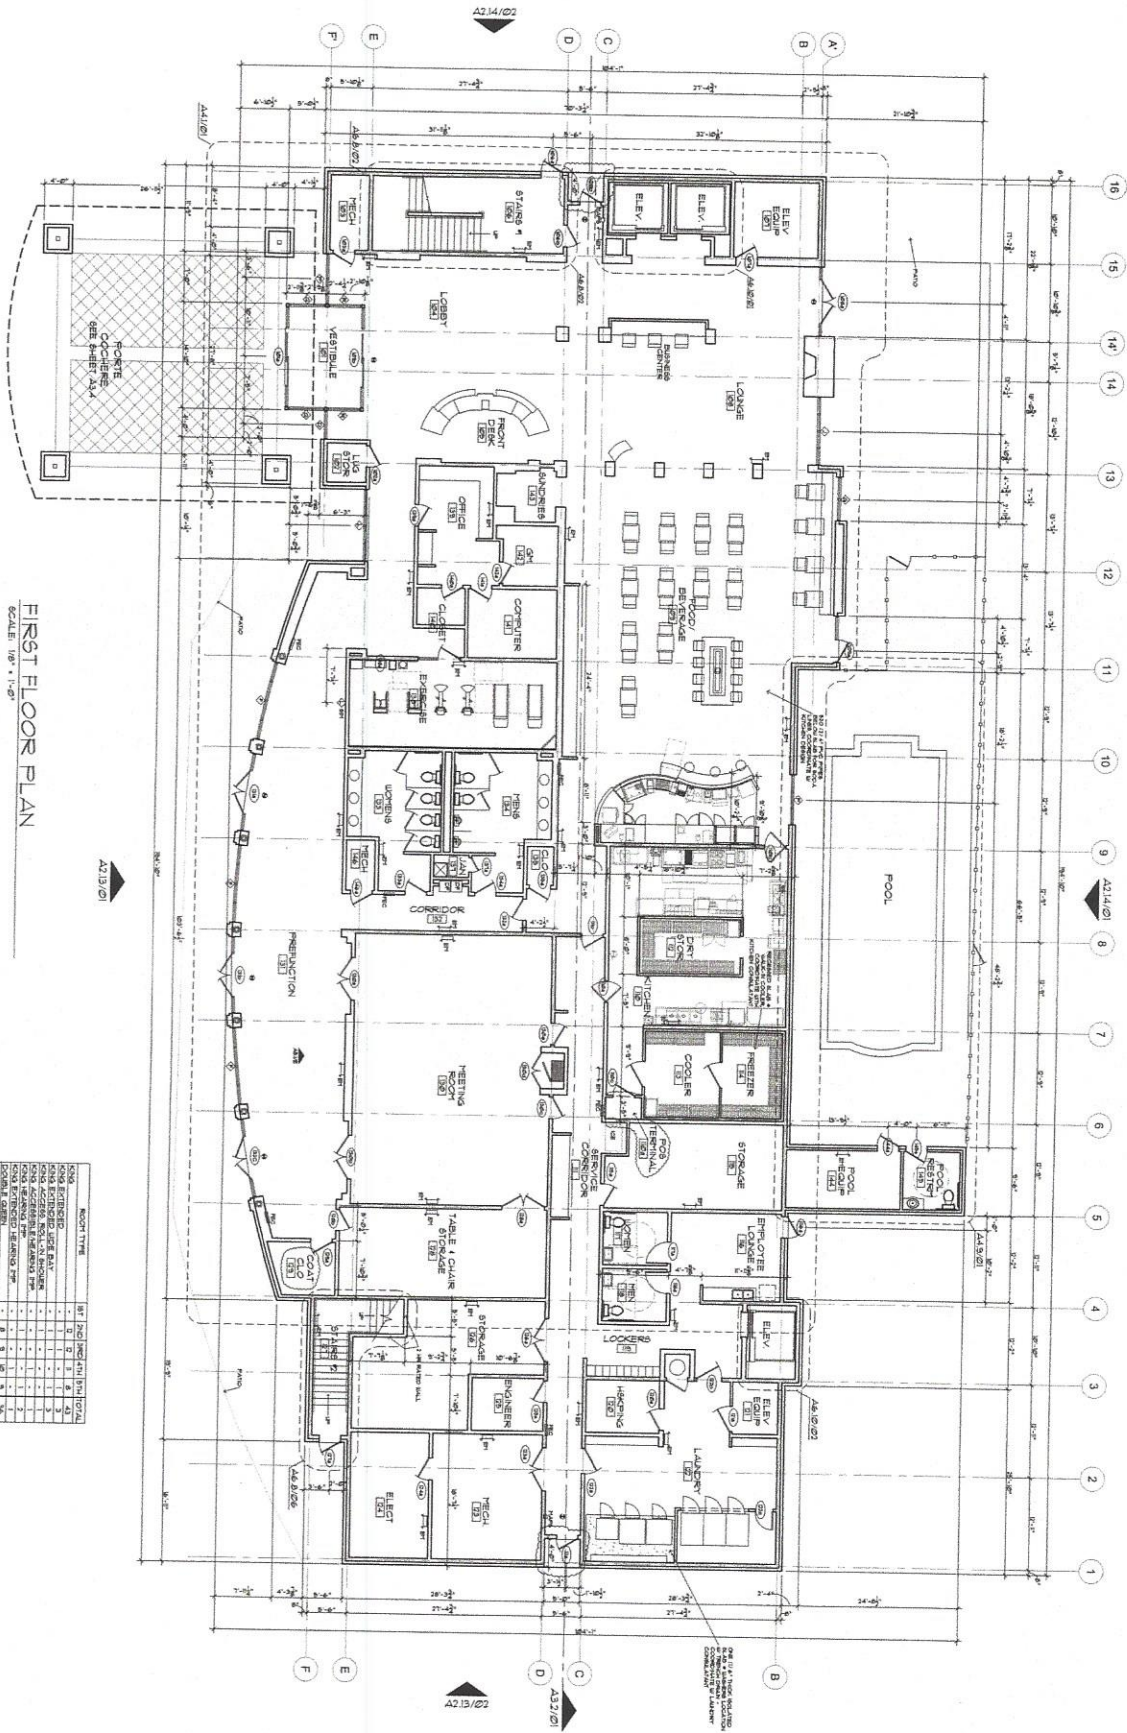

FIRST FLOOR PLAN  
SCALE: 1/8" = 1'-0"

SHEET NO. A2.1  
JOB NO. 1121  
DATE: 7-6-12


**NORMAN PATTEN & ASSOC.**  
ARCHITECTURE & PLANNING  
415 CEDAR ST. @ MAIN - CEDAR HILL, TX 75104 - 972/293-2929  
npatten@flash.net

**Holiday Inn**  
FULL SERVICE  
COVINGTON, LA

OWNER/DEVELOPER  
**MIKE DESAI**  
TEL: (601) 45-5519  
433 GARDEN GROVE STREET  
VICKSBURG, MS 39180




REVISIONS:  
4-3-13  
1-23-13

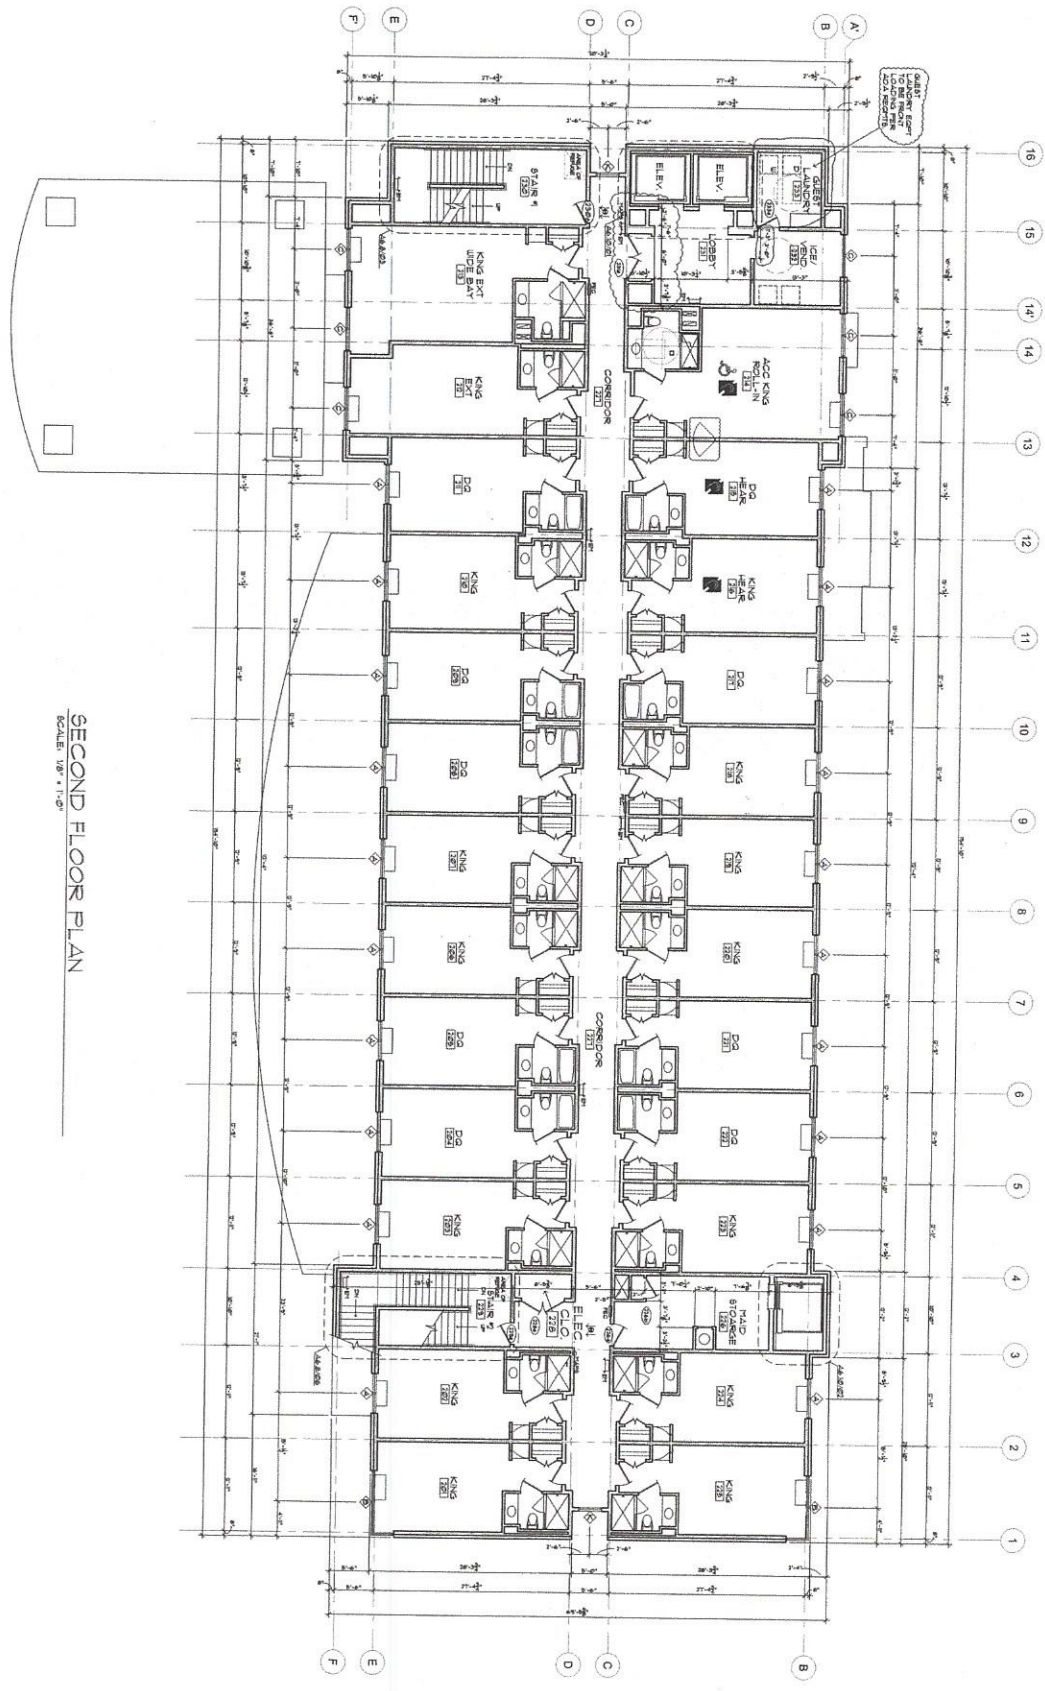

SECOND FLOOR PLAN  
SCALE: 1/8" = 1'-0"

SHEET NO. **A2.2**  
 JOB NO. **1121**  
 DATE **7-6-12**


**NORMAN PATTEN & ASSOC.**  
 ARCHITECTURE & PLANNING  
 413 CEDAR ST. @ MAIN - CEDAR HILL, TX 75104 - 972/293-2929  
 npatten@flash.net


  
**Holiday Inn**  
 FULL SERVICE  
 COVINGTON, LA

CONSULTING DEVELOPER  
**MIKE DESAI**  
 TEL: (601) 485-9816  
 432 GARDEN GROVE STREET  
 VICKSBURG, MS 39360



REVISIONS:  
 4-3-13  
 1-23-13



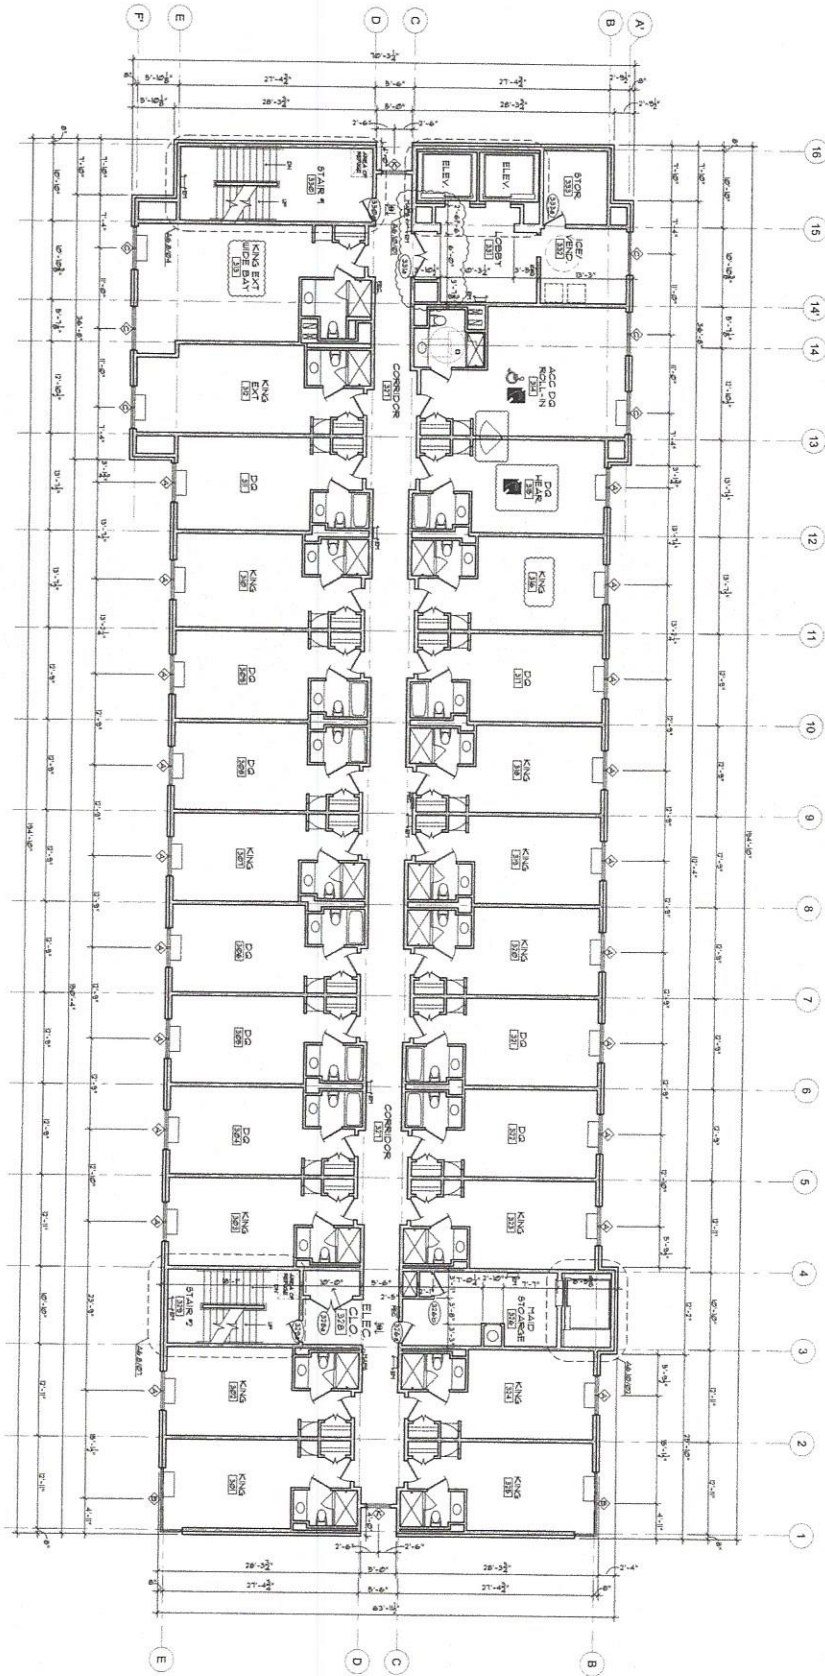

THIRD FLOOR PLAN  
SCALE: 1/8" = 1'-0"

A2.3

SHEET NO.

1121  
JOB NO.

T-6-12  
DATE



NORMAN PATTEN & ASSOC.  
ARCHITECTURE & PLANNING

413 CEDAR ST. @ MAIN - CEDAR HILL, TX 75104 - 972/293-2929  
npatten@flash.net




FULL SERVICE  
COVINGTON, LA

OWNER/DEVELOPER  
MIKE DESAI

TEL: (601) 415-9519  
432 GARDEN GROVE STREET  
VICKSBURG, MS 39180



REVISIONS:  
4-3-13  
1-23-13

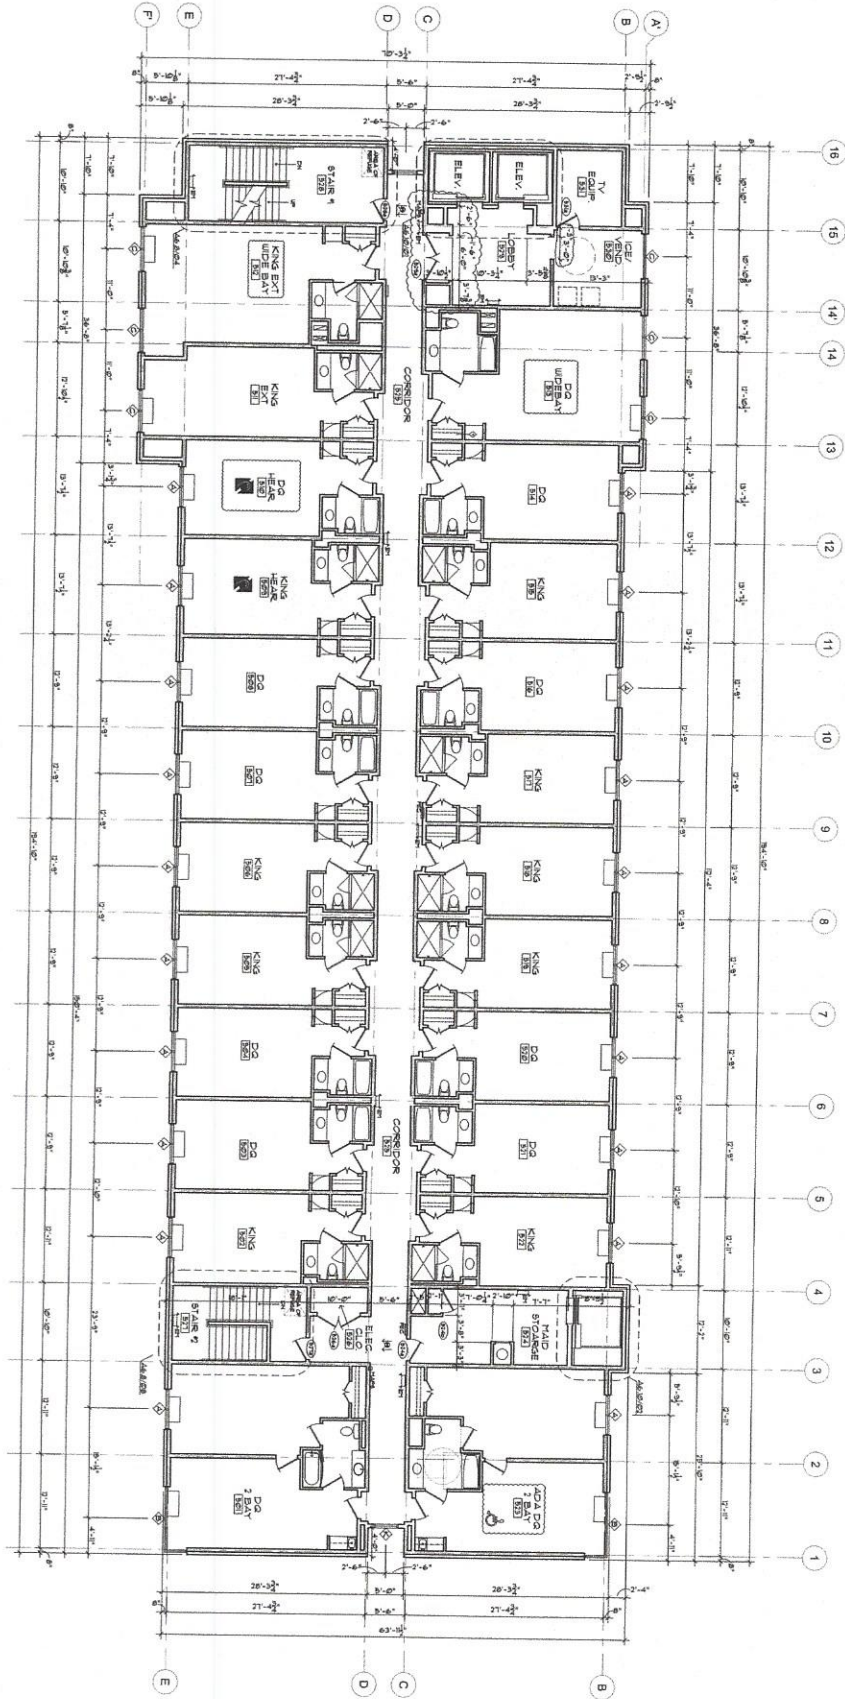

FIFTH FLOOR PLAN  
SCALE: 1/8" = 1'-0"

SHEET NO.  
A2.5

JOB NO.  
1121

T-6-12  
DATE

**N** NORMAN PATTEN & ASSOC.  
ARCHITECTURE & PLANNING  
413 CEDAR ST. @ MAIN - CEDAR HILL, TX 75104 - 972/ 293 - 2929  
npatten@flash.net

**H** Holiday Inn  
FULL SERVICE  
COVINGTON, LA

OWNER/DEVELOPER  
MIKE DESAI  
TEL: (601) 418-8810  
432 GARDEN GROVE STREET  
VICKSBURG, MS 39180



REVISIONS:  
4-3-13  
1-23-13