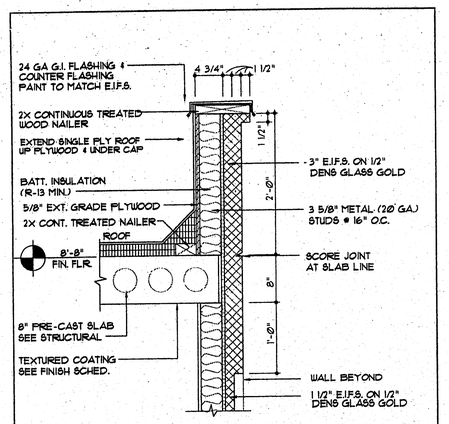

1 **Section Detail** SCALE: 1" = 1'-0"
Fourth Floor Stud Wall Section

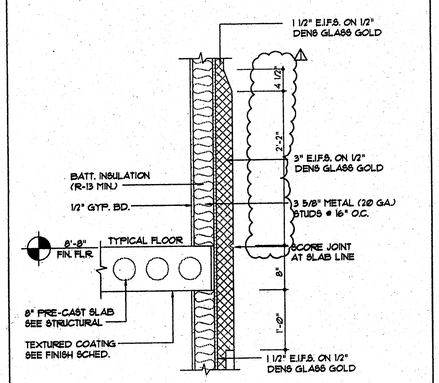

5 **Section Detail** SCALE: 1" = 1'-0"
Typical Floor Stud Wall Section

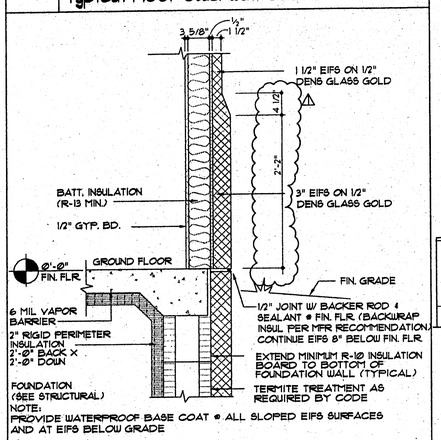

NOTE:
PROVIDE WATERPROOF BASE COAT @ ALL SLOPED EIFS SURFACES AND AT EIFS BELOW GRADE

15 **Section Detail** SCALE: 1" = 1'-0"
Typical Stud Wall Section

BUILDING MATERIALS/COLORS

STANDING SEAM METAL ROOF
COLOR: TO BE DETERMINED

STUCCO/DRYVIT:
MAIN BUILDING COLOR: DRYVIT #103 (NATURAL WHITE)
ACCENT COLOR: (INDICATED BY SHADING) DRYVIT # 453 (STAINLESS)

WINDOW TRIM: ANODIZED BRONZE ALUMINUM FRAMES

EXTERIOR DOORS/FRAMES: PAINT TO MATCH DRYVIT # 103

SIGN: YELLOW LETTERS/LOGO ON BLACK BACKGROUND

HVA/C LOUVERS: PAINT TO MATCH E.I.F.S.

GUTTERS, BOX GUTTERS & DOWNSPOUTS: PAINT TO MATCH E.I.F.S.

NOTES

1. SCREEN WALL
2. EXTERIOR FINISH SYSTEM
3. WINDOW - SEE PLANS
4. DOOR - SEE PLANS
5. STANDING SEAM METAL ROOF- SEE SPECS
6. THRU WALL HVAC UNIT - SEE MECHANICAL DRAWINGS
7. GUTTER OR DOWNSPOUT
8. BUILDING SIGN - PROVIDE BLOCKING AS REQUIRED BY MANUFACTURER
9. ACCENT BEAM AT PORTE COCHERE
10. 16" DIAMETER VENT LOUVER (PAINT TO MATCH E.I.F.S.)
11. SCORE JOINT IN EIFS
12. 8" x 8" EIFS BAND

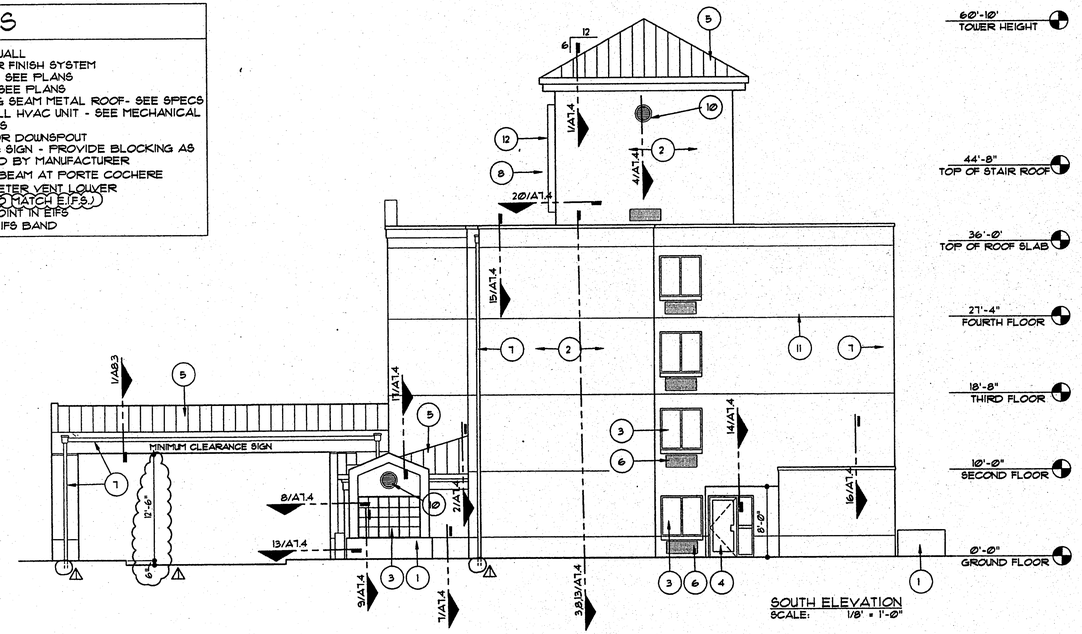

SOUTH ELEVATION
SCALE: 1/8" = 1'-0"

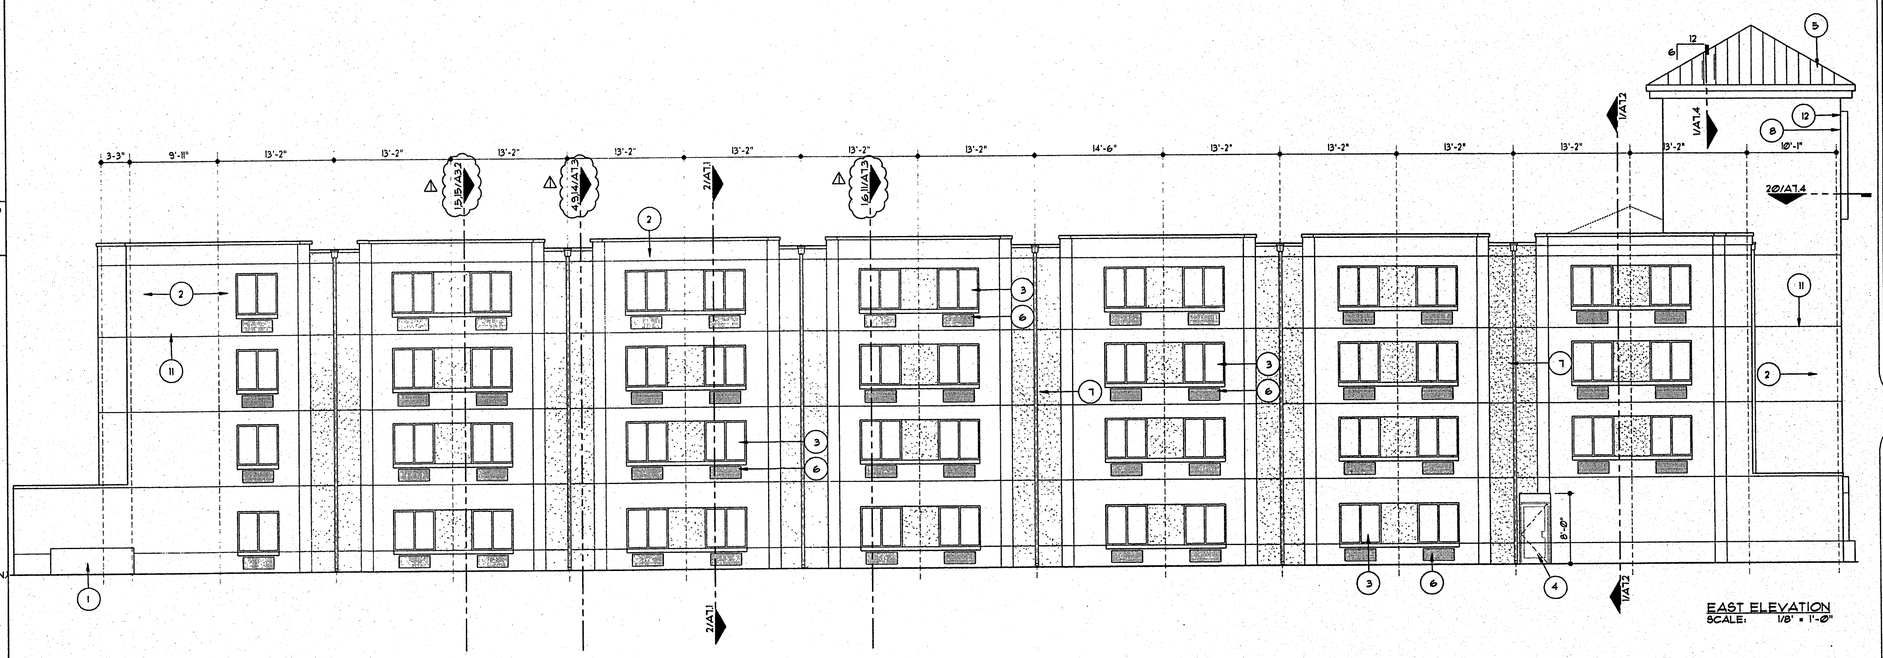

EAST ELEVATION
SCALE: 1/8" = 1'-0"

EXTERIOR ELEVATIONS
SCALE: 1/8" = 1'-0"

LLW, Inc.
803 SOUTH MT. MORIAH, STE. 100B
MEMPHIS, TENNESSEE 38117-5343
901-683-7175/FAX 901-683-2385
LEONARD MESSINA, ARCHITECT

▲ revisions:
OWNER REVISION 5-27-97
△ REVISION 10-14-97

▲ seal:

Sleep Inn
Jackson, Mississippi

▲ title:
EXTERIOR ELEVATIONS

▲ date: 8-22-97
▲ job: 1697
▲ file: 1697-A32
▲ scale: 1/8" = 1'-0"

sheet A3.2 of 10