



1 BUILDING SECTION
SCALE: 1/4" = 1'-0"

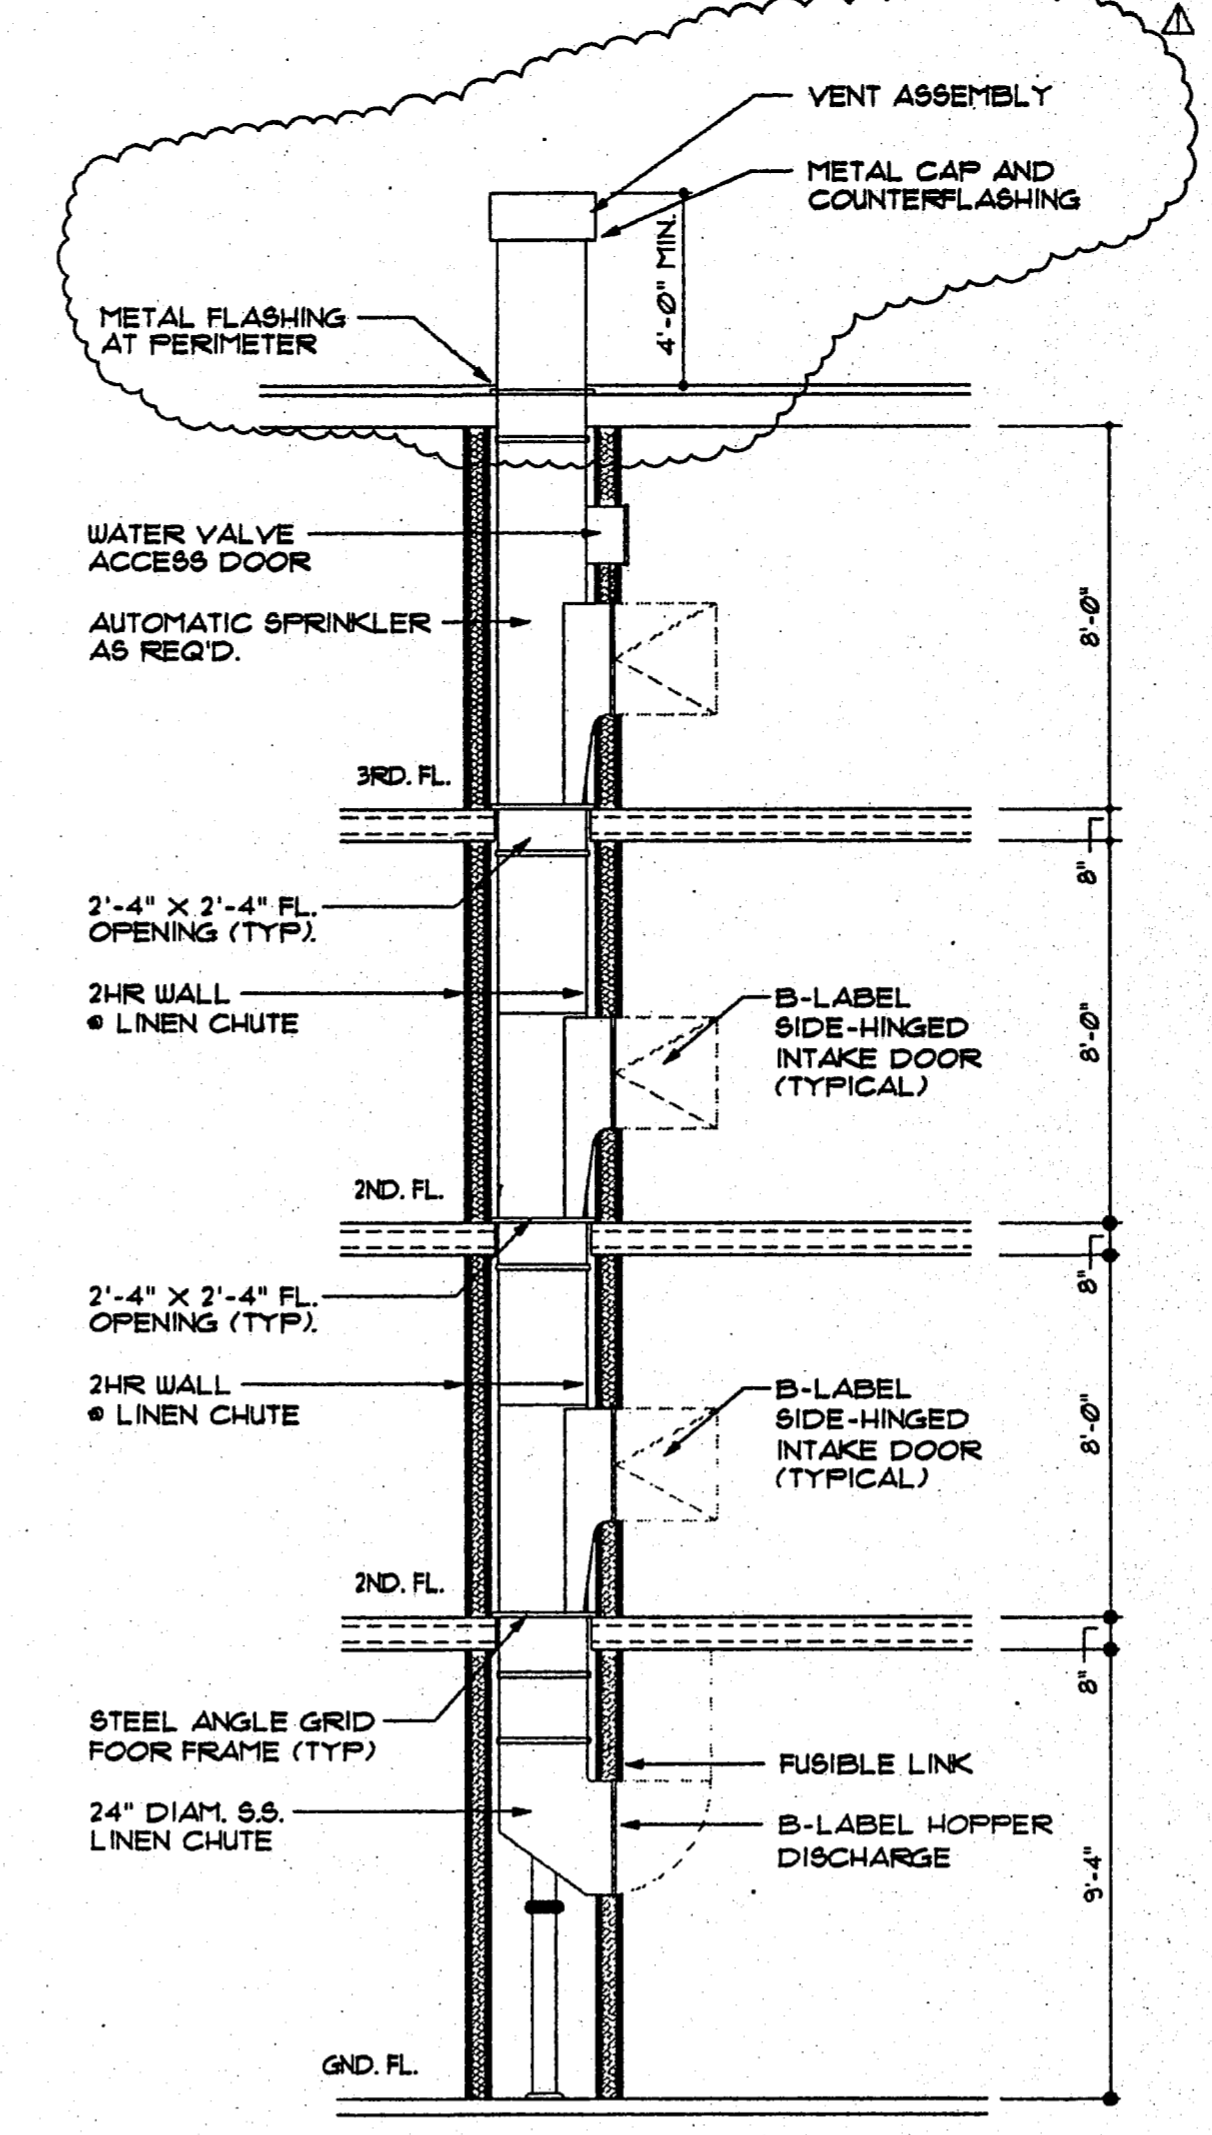

2 LINEN CHUTE SECTION
SCALE: 1/4" = 1'-0"

LINEN DISCHARGE IS SHOWN FOR CLARITY - SEE PLAN FOR ACTUAL DROP DIRECTION

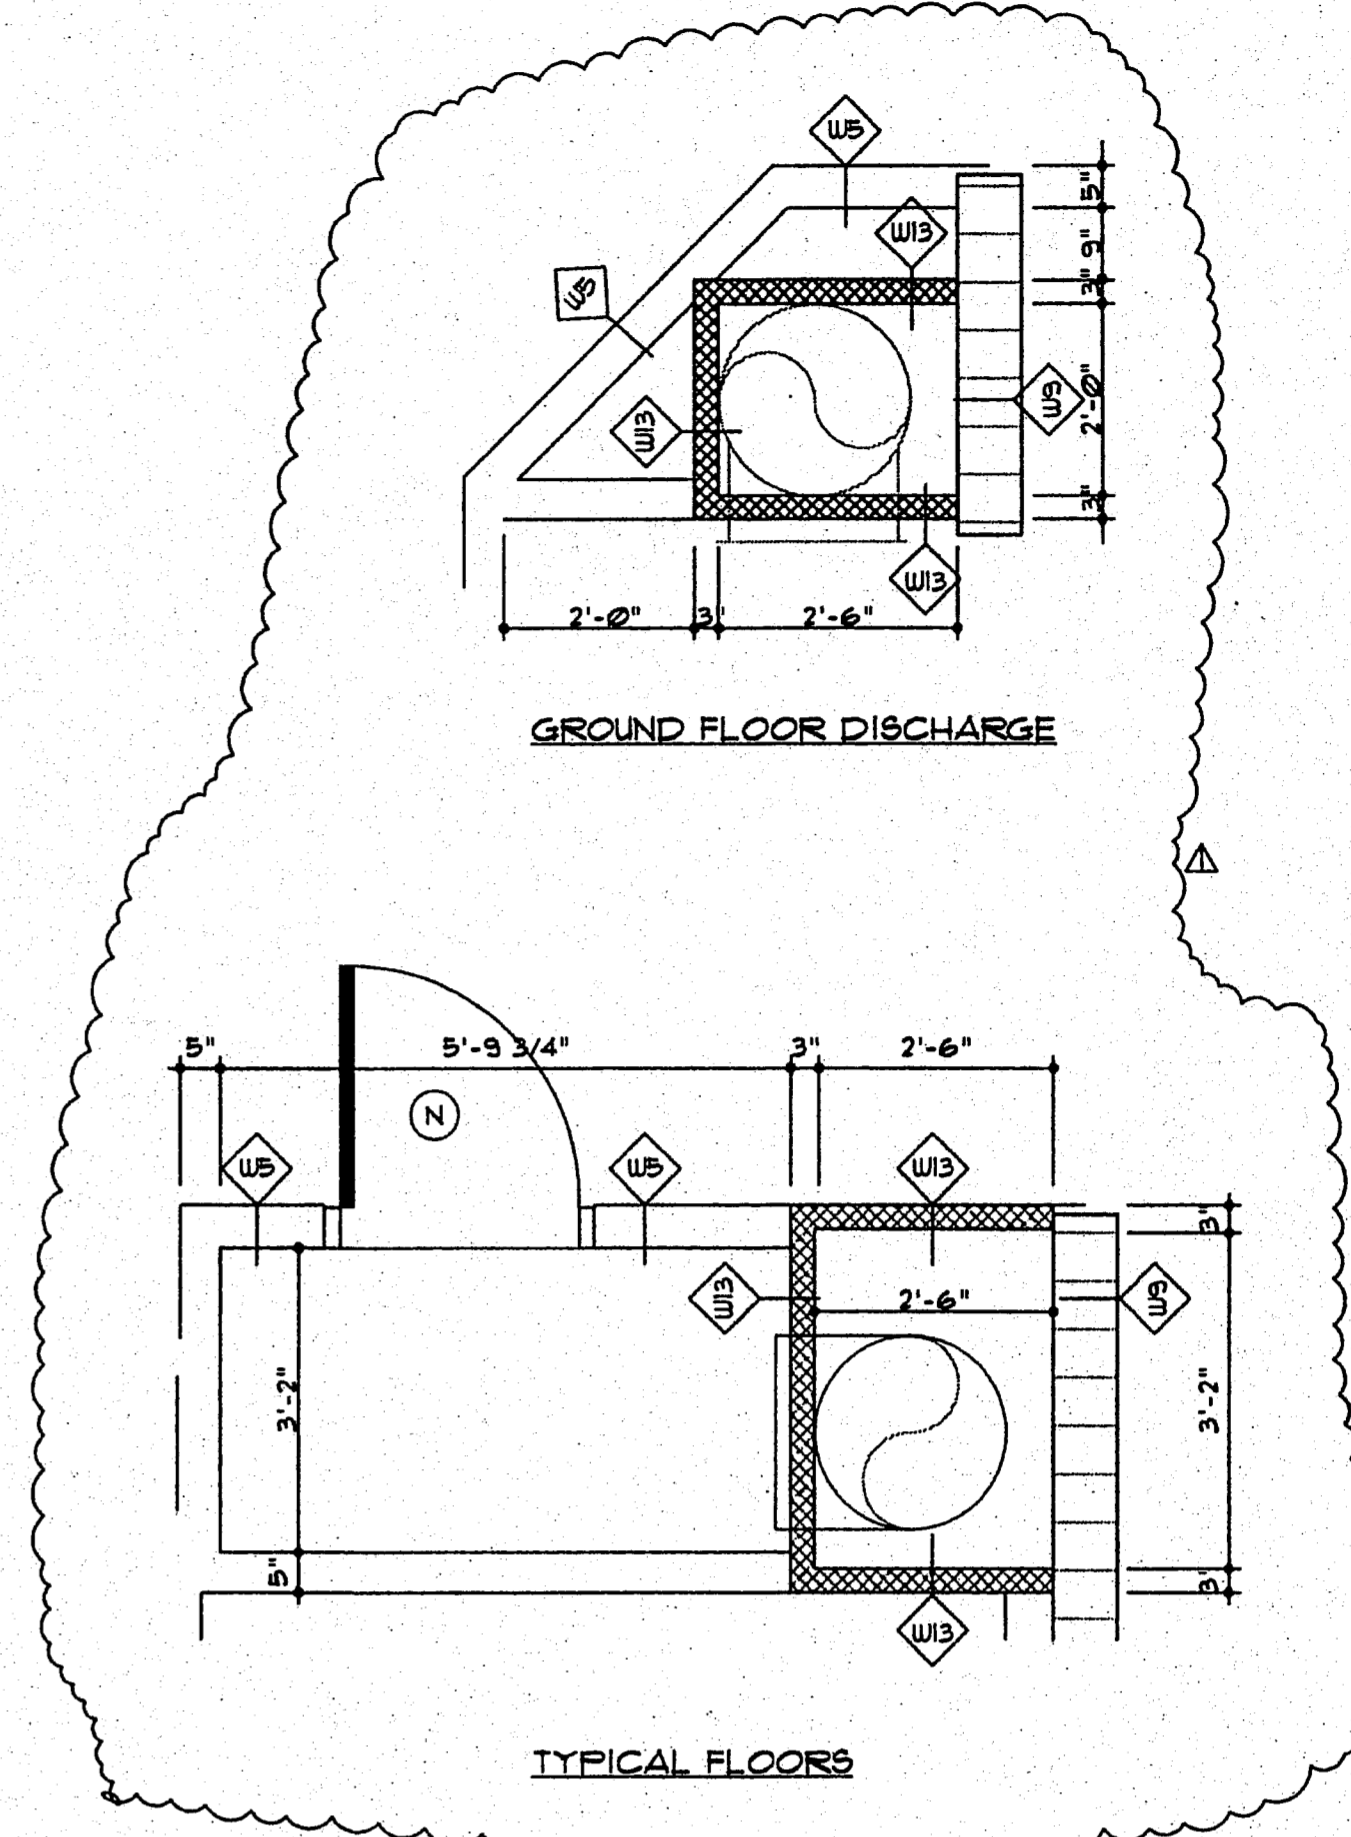

3 LINEN CHUTE PLAN DETAILS
SCALE: 1/2" = 1'-0"

LLW, Inc.
803 SOUTH MT. MORIAH, STE. 100B
MEMPHIS, TENNESSEE 38117-5343
901-683-7175/FAX 901-683-2385
LEONARD MESSINA, ARCHITECT

revisions:
REVIEW 10-14-97

seal:

Sleep Inn
Jackson, Mississippi

title:
BUILDING SECTION & DETAILS
date: 10-14-97
job: 1697
file: 1697-A7.2
scale: 1/8" = 1'-0"

sheet
A7.2
of 34