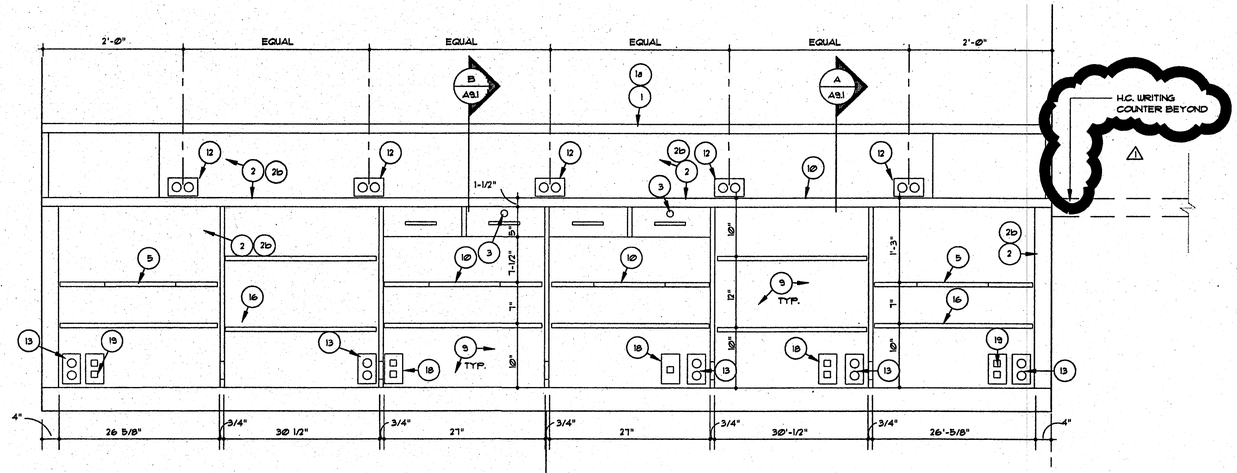

BACK ELEVATION
SCALE: 1"=1'-Ø"

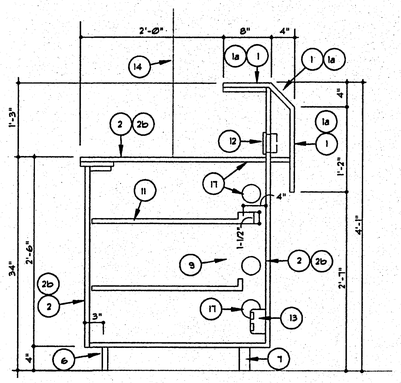

SECTION A
SCALE: 1"=1'-Ø"

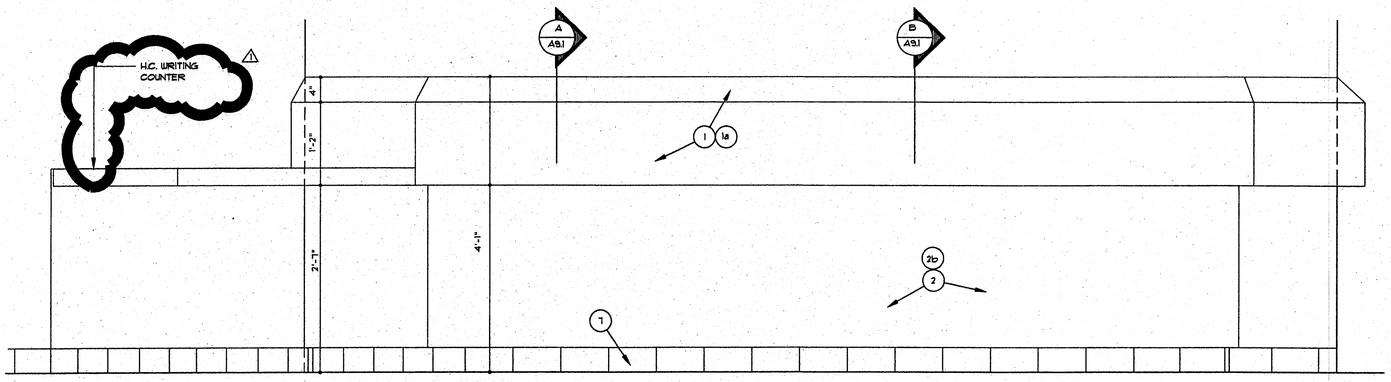

FRONT ELEVATION
SCALE: 1"=1'-Ø"

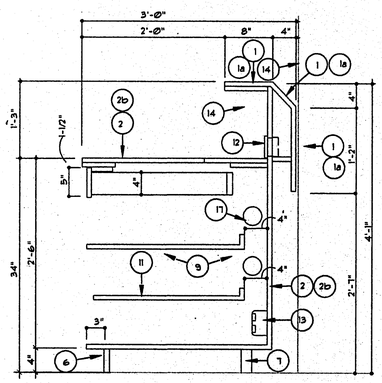

SECTION B
SCALE: 1"=1'-Ø"

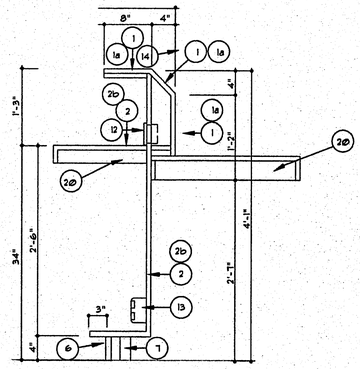

SECTION C
SCALE: 1"=1'-Ø"

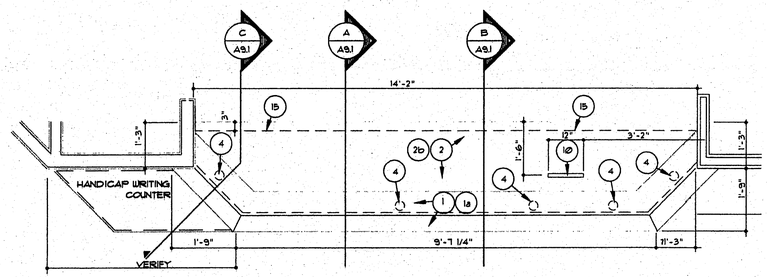

REGISTRATION DESK TOP PLAN
SCALE: 1/2"=1'-Ø"

GENERAL NOTES

1. DIMENSIONS SHOWN ON THIS SHEET FOR HEIGHT OF ELECTRICAL, TELEVISION, OR TELEPHONE OUTLETS ARE TO BE FOLLOWED WITH NO ALLOWANCES. UNDER NO CIRCUMSTANCES SHALL ANY OUTLETS OR FIXTURES IN THE DEMISING WALLS BE PLACED BACK-TO-BACK. SEE DET 10/A9.4
2. DUPICATE NUMBERS REFER TO DIFFERENT MANUFACTURERS OF PLASTIC LAMINATES. SUBMIT COLORS AND MANUFACTURER TO ARCHITECT FOR APPROVAL.

KEYED NOTES

1. PLASTIC LAMINATE FINISH - "WILSONART" D48-6 (THISTLE)GENERATION II)
1a. SOLID SURFACE - "GIBRALTAR" NO. D'16-8L MAUVE BLUSH CAN BE SUBSTITUTED FOR "WILSONART" D48-6 THISTLE(GENERATION II)
1. PLASTIC LAMINATE FINISH - FORMICA NO. 913-58 INDIAN SMOKE, MATTE FINISH (GENERATION III)
1a. SOLID SURFACE - SURELL DESERT BEIGE CAN BE SUBSTITUTED FOR FORMICAIO. 913-58 (GENERATION III)
2. PLASTIC LAMINATE FINISH - "WILSONART" 1500N-6 (GREY)GENERATION II)
2a. SOLID SURFACE - "GIBRALTAR" NO. D315-8L PLATINUM CAN BE SUBSTITUTED FOR "WILSONART" 1500N-6 GREY(GENERATION II)
2. PLASTIC LAMINATE FINISH - FORMICA NO. 925-58 CHAMPAGNE, MATTE FINISH (GENERATION III)
2a. SOLID SURFACE - SURELL ALMONDINE CAN BE SUBSTITUTED FOR FORMICAIO. 925-58 (GENERATION III)
3. CASH DRAWER WITH KEYED LOCK
4. 2 1/2" DIAMETER CABLE HOLE IN DESKTOP
5. FIXED SHELF WITH PAPER SLOT
6. VINYL BASE
7. CERAMIC TILE BASE (MATCH BASE TILE IN LOBBY AREA)
8. NUMBER NOT USED
9. INSIDE OF CABINET TO BE PAINTED FLAT BLACK.
10. SLOTS FOR PRINTER PAPER FEED - SLOTS TO BE CENTERED WITHIN BAY WIDTH.

KEYED NOTES

11. SHELVES ON ROLLERS / GUIDES, ROLLERS STOP AFTER BEINING SLID OUT 12". PROVIDE 1" LIP AT BACK OF SHELF. ALL SHELVES IN 3 MIDDLE BAYS (WHETHER WITH OR WITHOUT PAPER SLOTS) ARE TO BE INTERCHANGABLE.
12. 15 - AMP NON-DEDICATED RECEPTACLE
13. 15 - AMP DEDICATED RECEPTACLE
14. LINE OF WALL BEYOND
15. LINE OF TOE KICK BELOW
16. FIXED SHELF - 3/4" STOCK
17. 3" DIAMETER HOLE AT DIVIDER
18. RJ11C TELEPHONE JACK
19. RJ45 TELEPHONE JACK
20. SUPPORT AT 24" O.C.

LLW, Inc.
803 SOUTH MT. MORIAH, STE. 100B
MEMPHIS, TENNESSEE 38117-5343
901-683-7175/FAX 901-683-2385
LEONARD MESSINA, ARCHITECT

▲ revisions:
⚠ REVISION 10-14-97

▲ seal:

Sleep Inn
Jackson, Mississippi

▲ title:
REGISTRATION DESK & DETAILS

▲ date: 10-14-97
▲ job: 1697
▲ file: 1697-191
▲ scale: AS NOTED

sheet A9.1 of 34