

DOOR SCHEDULE

DOOR TYPE	DOOR		LITE	FRAME		FIRE RATING	HARDWARE GROUP	REMARKS	
	SIZE	THICKNESS		MAT.	FINISH				
A	3'-0"x6'-8"	1 3/4"	A	SC	P.W.	H.M.	PAINT	20 MIN.	RATED ASSEMBLY 6 PANEL POCKET DOOR NARROW STILE W/ SIDE LITE NARROW STILE W/ SIDE LITE 24"x24" LOUVER (NO LOUVER AT EXT. STAIR DOORS) 30"x60" LOUVER
B	3'-0"x6'-8"	1 3/4"	A	SC	P.W.	H.M.	PAINT	45 MIN.	
C	2'-0"x6'-8"	1 3/8"	G	HC	PAINT	WOOD	PAINT	-	
D	(2) 3'-0"x6'-8"	-	C	GLASS	-	ALUM.	ANOD.	-	
E	3'-0"x6'-8"	-	D	GLASS	-	ALUM.	ANOD.	-	
F	3'-0"x6'-8"	1 3/4"	E	HM.	PAINT	HM.	PAINT	-	
G	4'-0"x6'-8"	1 3/4"	E	HM.	PAINT	HM.	PAINT	-	
H	3'-0"x6'-8"	1 3/4"	A	SC	P.W.	H.M.	PAINT	45 MIN.	
J	3'-0"x6'-8"	1 3/4"	A	SC	P.W.	H.M.	PAINT	90 MIN.	
K	3'-0"x6'-8"	1 3/4"	A	SC	P.W.	H.M.	PAINT	-	
L	3'-0"x6'-8"	1 3/4"	A	SC	P.W.	H.M.	PAINT	-	
M	4'-0"x6'-8"	1 3/4"	A	SC	P.W.	H.M.	PAINT	45 MIN.	
N	3'-0"x6'-8"	1 3/4"	A	SC	P.W.	H.M.	PAINT	45 MIN.	
P	(2) 2'-0"x6'-8"	1 3/4"	F	HC	P.W.	H.M.	PAINT	-	
R	2'-0"x6'-8"	1 3/4"	A	SC	P.W.	H.M.	PAINT	45 MIN.	
S	(2) 2'-4"x6'-8"	1 3/4"	B	SC	P.W.	H.M.	PAINT	45 MIN.	
T	3'-0"x6'-8"	1 3/4"	A	SC	P.W.	H.M.	PAINT	45 MIN.	
V	(2) 3'-0"x6'-8"	1 3/4"	B	SC	P.W.	H.M.	PAINT	-	
W	2'-0"x6'-8"	1 3/4"	H	HC	P.W.	H.M.	PAINT	-	

DOOR SCHEDULE NOTES


1. INSTALL APPROPRIATE DOOR STOP @ ALL DOORS
2. ALL PRE-FINISHED WOOD DOORS TO BE MOHAWK RUSTIC SERIES (SEE SPEC.)
3. ALL EXTERIOR STAIR DOORS TO HAVE FULL WIDTH PANIC HARDWARE, ALL FLOORS.
4. PROVIDE SMOKE AND DRAFT CONTROL DOOR ASSEMBLIES AT ALL RATED DOORS.

SC SOLID CORE WOOD
ALUM ALUMINUM
HM. HOLLOW METAL


P.W. PRE-FINISHED WOOD
ANOD. DARK BRONZE ANODIZED
PAINT PAINT "SHERWIN WILLIAMS" 601000

HC HOLLOW CORE WOOD
VUC VINYL WALL COVERING

NOTE: EXIT DOORS SHALL BE OPENABLE FROM THE INSIDE WITHOUT THE USE OF A KEY OR ANY SPECIAL KNOWLEDGE OR EFFORT.


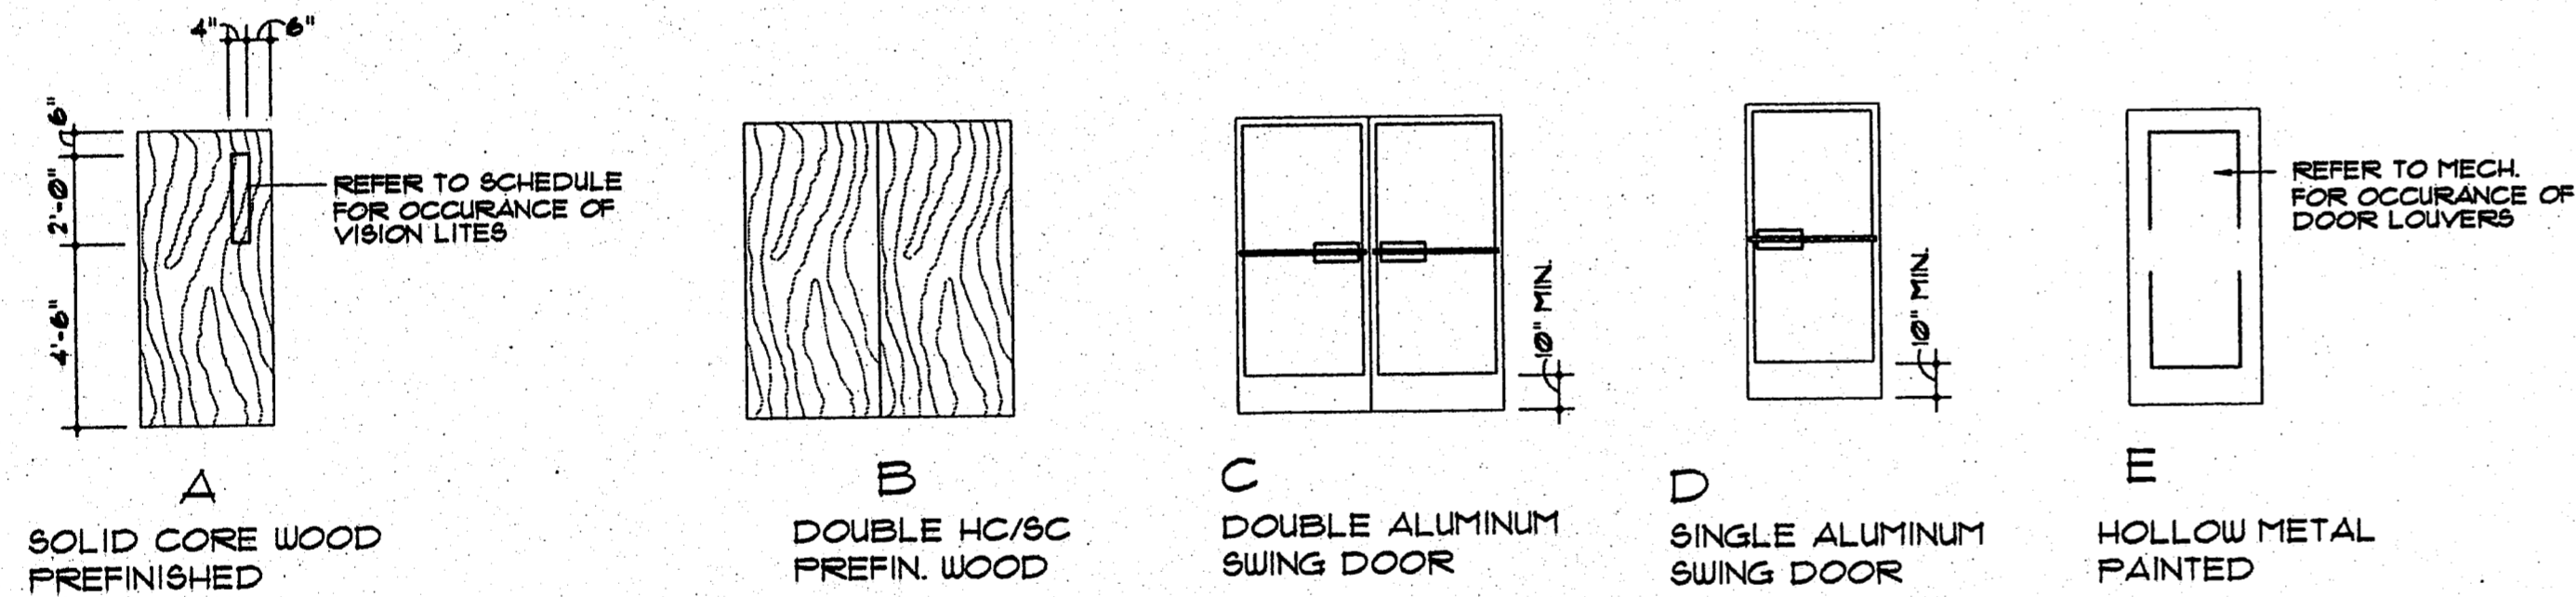


DOOR TYPES

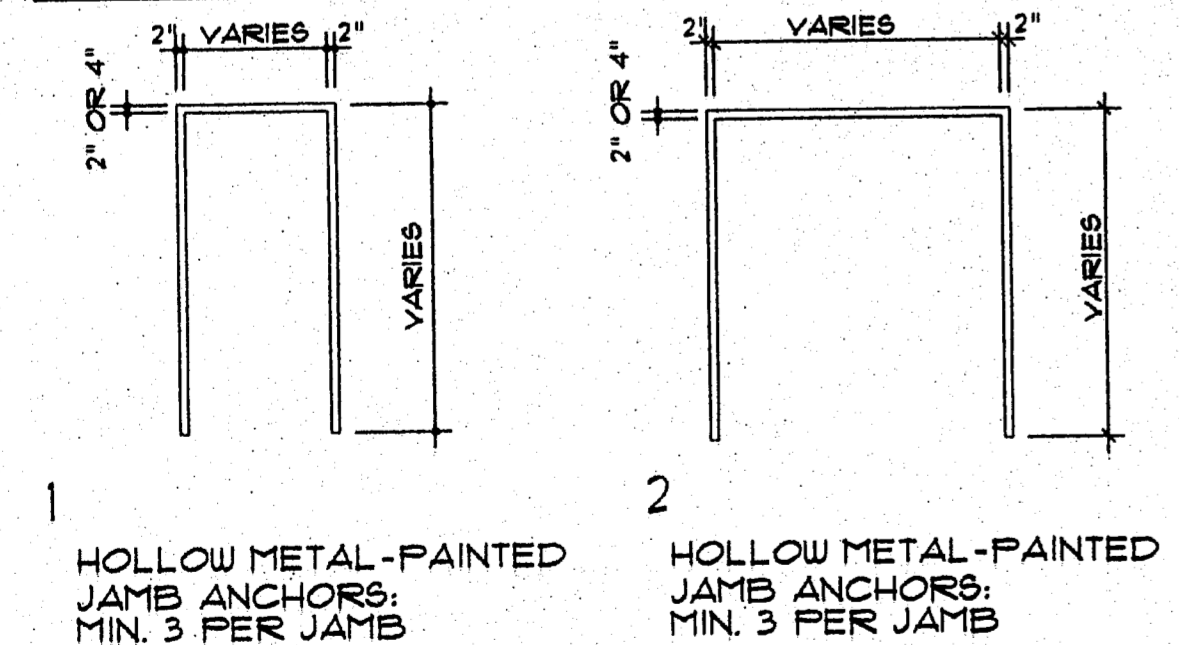

HOLLOW METAL FRAME TYPES

NOTES: ALL WELDED CONSTRUCTION
4" HEAD @ CMU WALLS

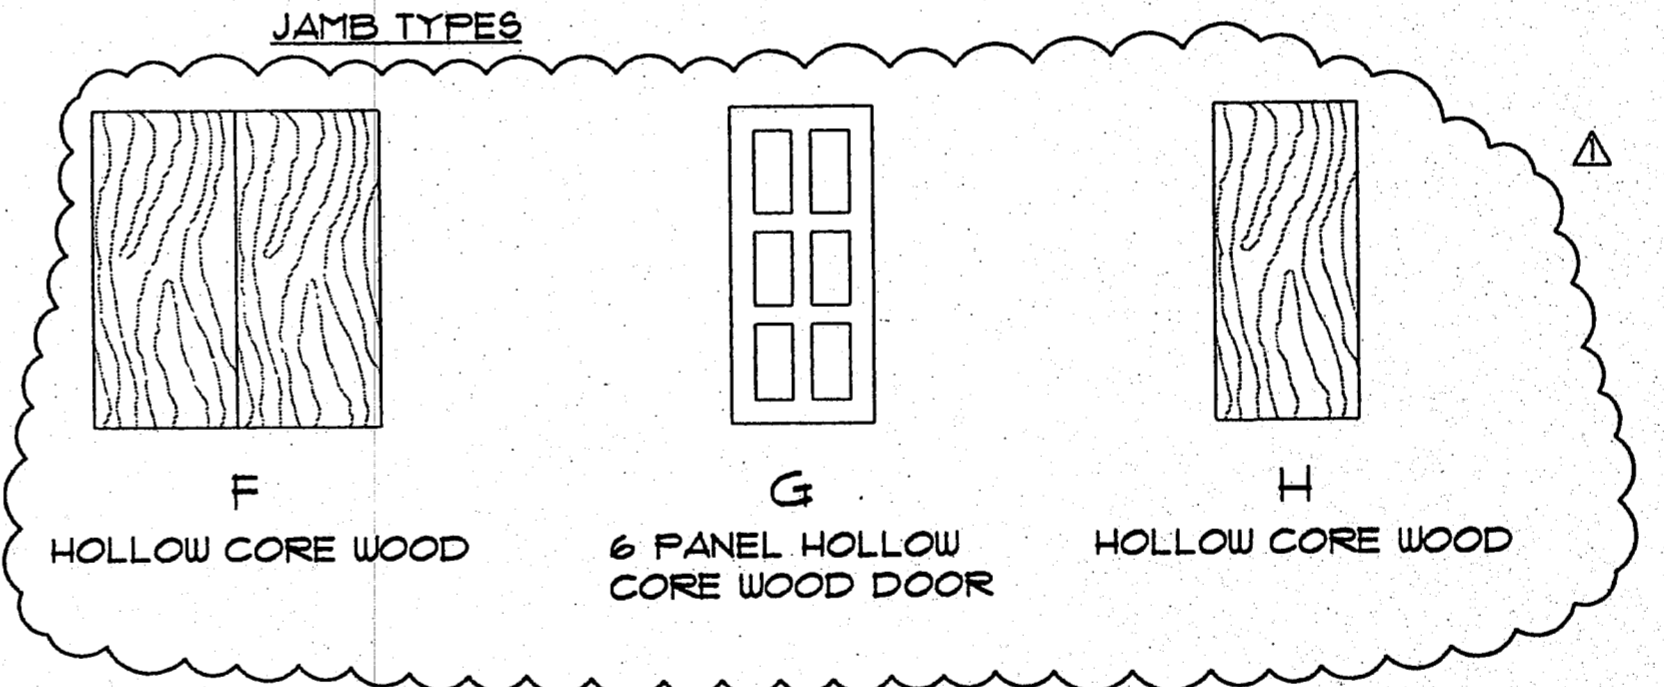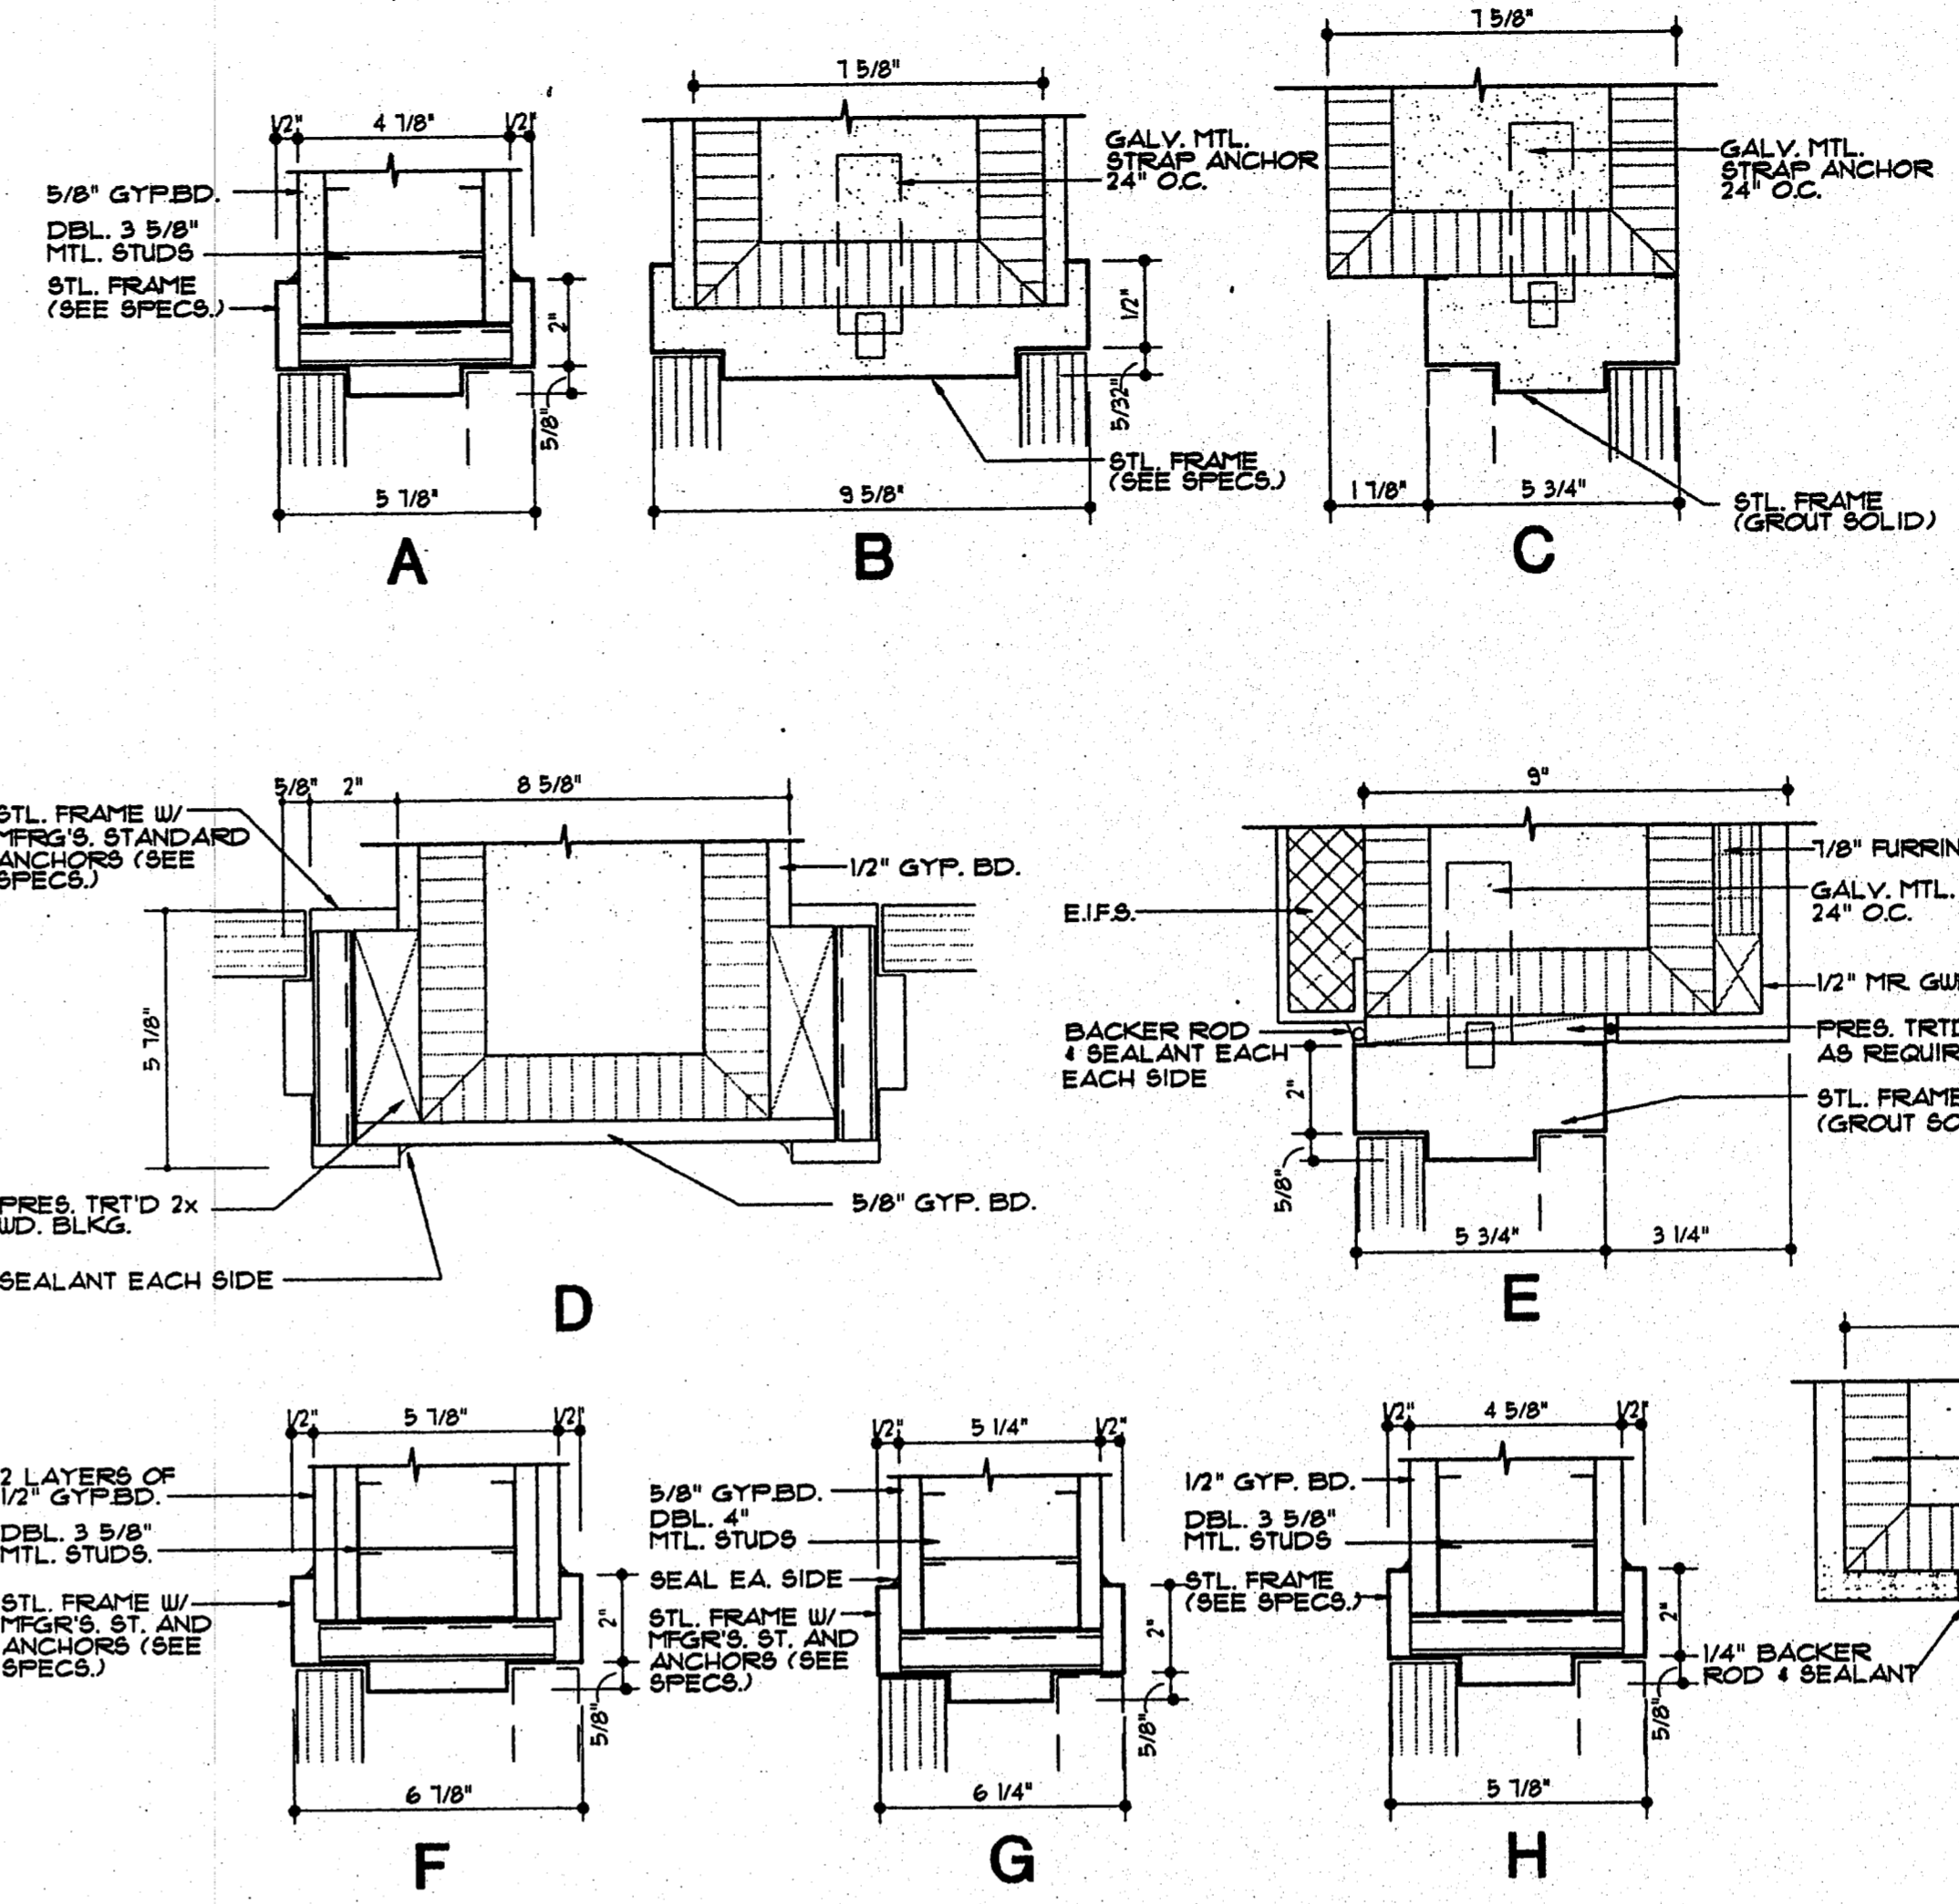

LLW, Inc.
803 SOUTH MT. MORIAH, STE. 100B
MEMPHIS, TENNESSEE 38117-5343
901-683-7755/FAX 901-683-2885
LEONARD MESSINA, ARCHITECT

revisions:
REVIEW 10-14-97

scale:

Sleep Inn
Jackson, Mississippi

title:
DOOR SCHEDULE AND DETAILS

date: 10-14-97
Job: 1697
file: 1697-A92
scale: AS NOTED

sheet
A9.2
of 34