

LLW, Inc.

803 SOUTH MT. MORIAH, STE. 100B
MEMPHIS, TENNESSEE 38117-5343
901-683-7175/FAX 901-683-2385
LEONARD MESSINA, ARCHITECT

▲ revisions:

FINAL REVIEW 8-28-97

▲ 10-14-97

▲ seal:

Sleep Inn

Jackson, Mississippi

▲ title:
LARGE SCALE
COMMERCIAL
ELECTRICAL


▲ date: 8-22-97

▲ job: 1697

▲ file: 1697-A47

▲ scale: 1/8"=1'-0"

sheet
124
of 10

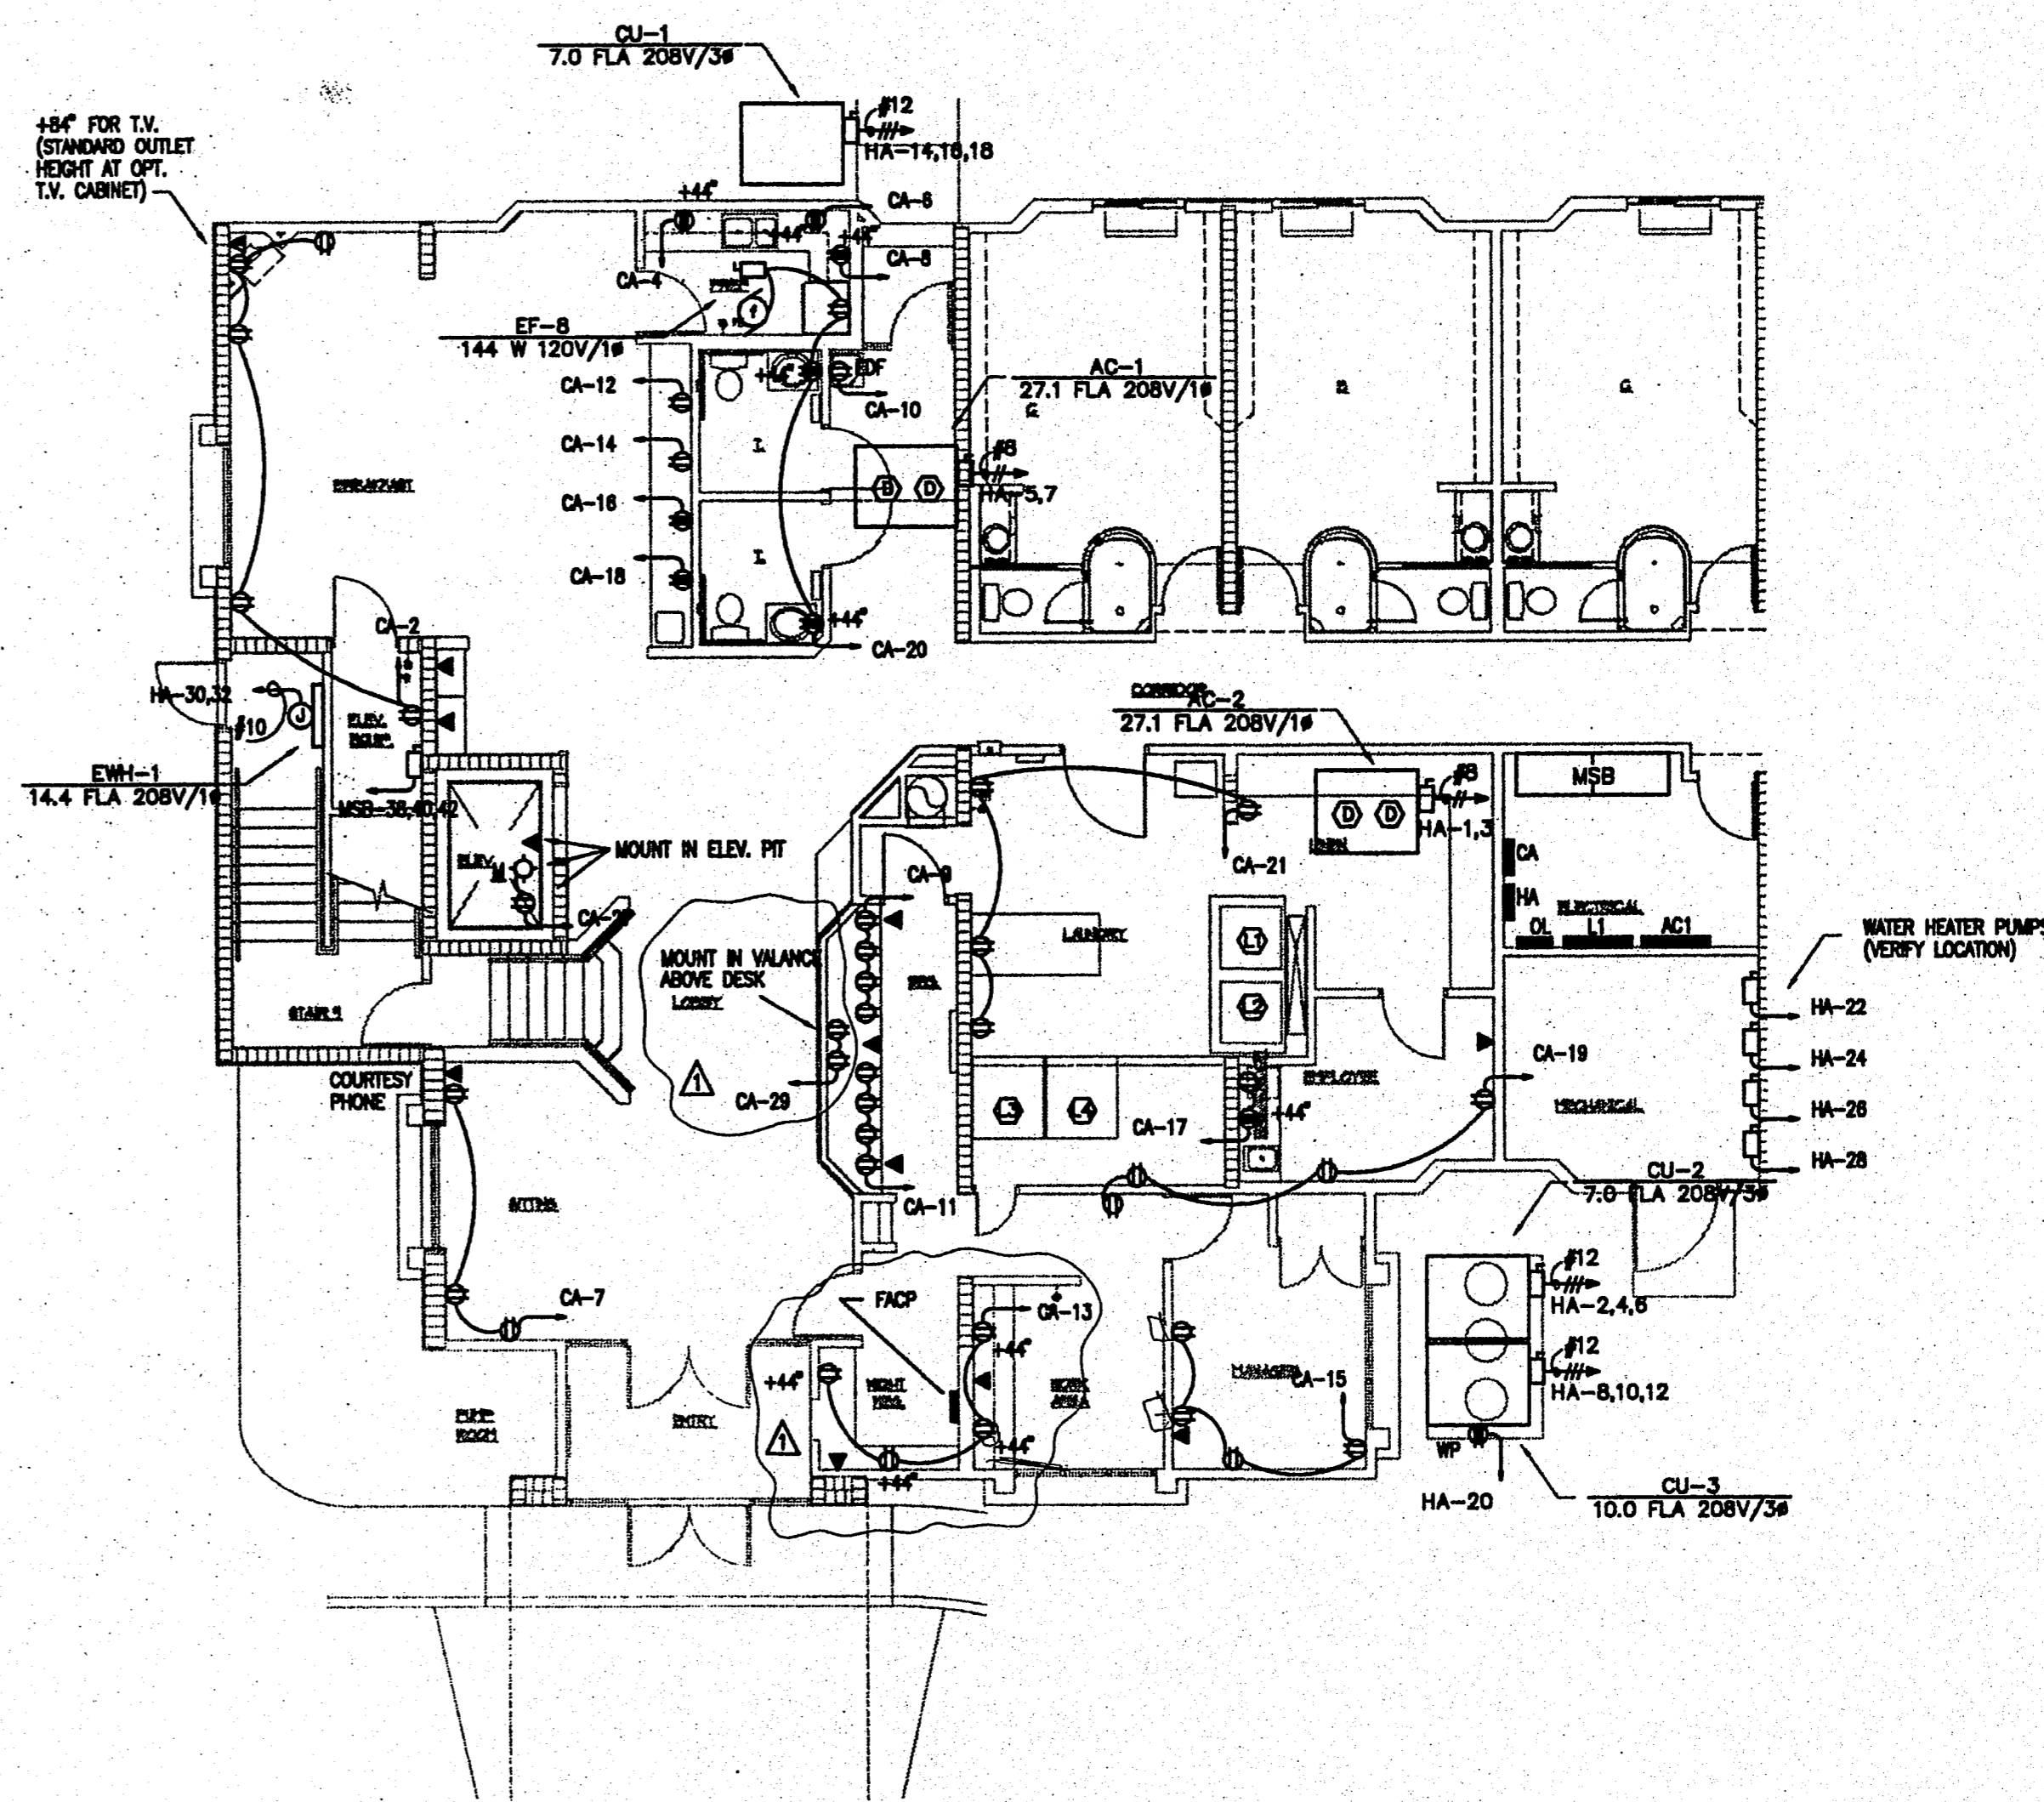

LARGE SCALE COMMERCIAL AREA

SCALE: 1/4" = 1'-0"

LAUNDRY ELECTRICAL CONNECTION SCHEDULE

CONN	ITEM	DESCRIPTION	TYPE	VOLTS	PH	AMPS	KW	HP	COMMENTS	AFF	CKT #	BREAKER SIZE	WIRE QUAN./SIZE
L1	1	50 Lb. Washer/Extractor	Disc	208	3	6.0				42"	CA-22,24,26	20/3	3-#12 W/G
L2	2	50 Lb. Washer/Extractor	Disc	208	3	6.0				42"	CA-28,30,32	20/3	3-#12 W/G
L3	3	75 Lb. Dryer	Disc	120	1	15.0				42"	CA-23	20/1	2-#12 W/G
L4	4	75 Lb. Dryer	Disc	120	1	15.0				42"	CA-25	20/1	2-#12 W/G