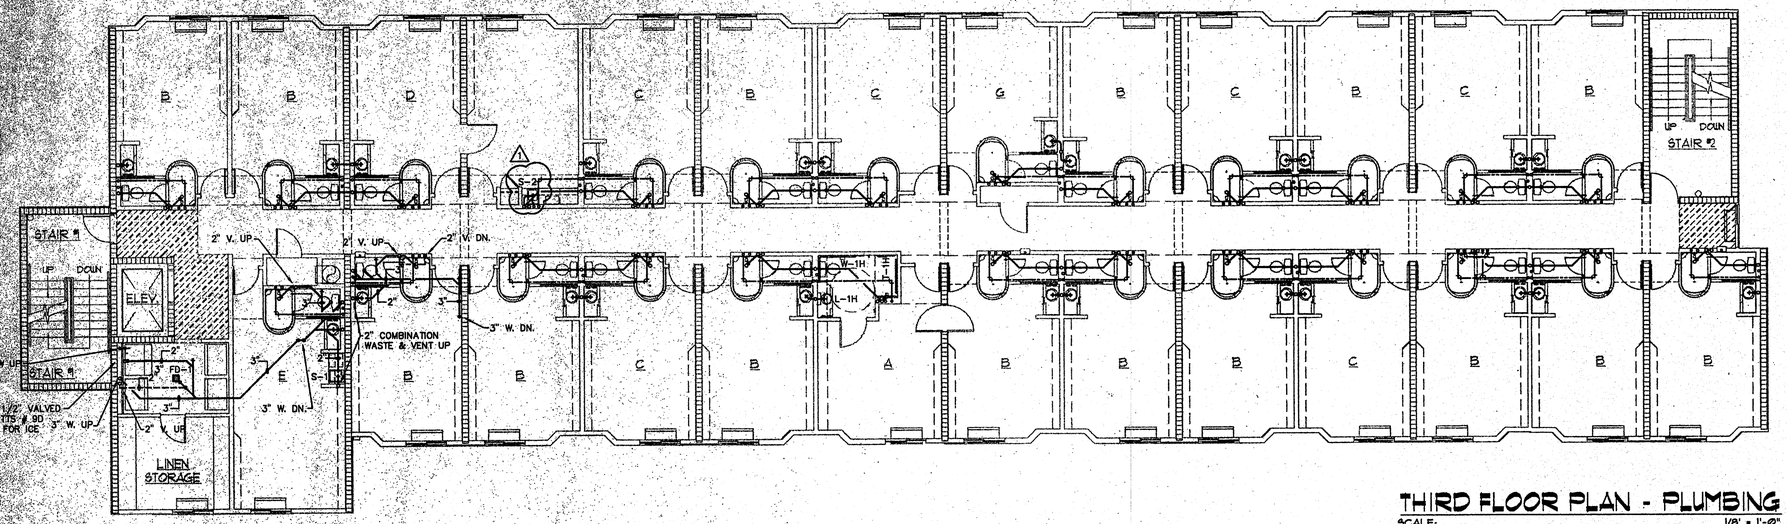

THIRD FLOOR PLAN - PLUMBING

SCALE: 1/8" = 1'-0"

NOTE:
SEE SHEET P1.5 FOR ENLARGED PLANS & RISER DIAGRAMS OF TYPICAL GUEST UNITS

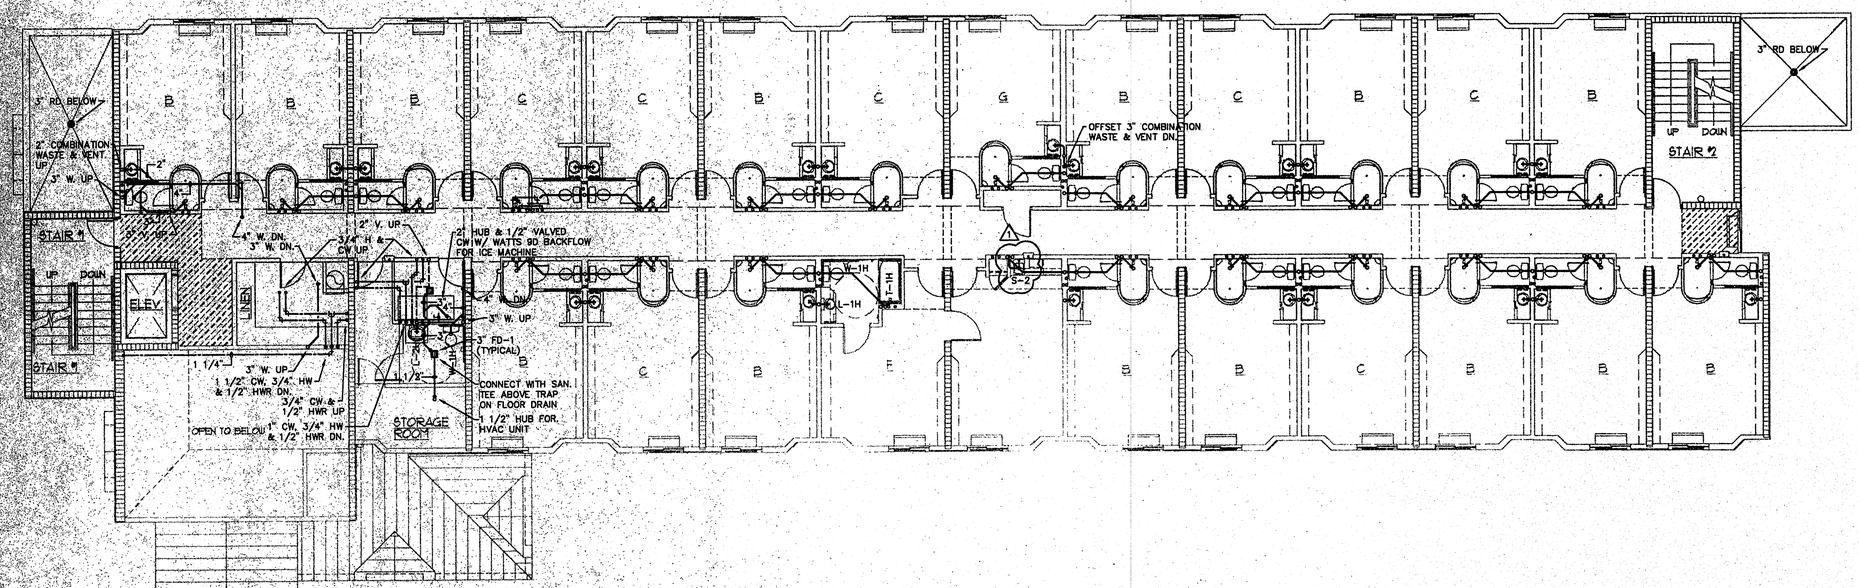

SECOND FLOOR PLAN - PLUMBING

SCALE: 1/8" = 1'-0"

LLW, Inc.
803 SOUTH MT. MORIAH, STE. 100B
MEMPHIS, TENNESSEE 38117-5343
901-683-7775/FAX 901-683-2385
LEONARD MESSINA, ARCHITECT

▲ revisions:

△ REVIEW 10-24-97

▲ seal:

Sleep Inn
Jackson, Mississippi

▲ title:
SECOND & THIRD FLOOR PLANS - PLUMBING

▲ date: 10-14-97
▲ job: 1697
▲ file: 1697-P13
▲ scale: 1/8" = 1'-0"

sheet P1.3 of 34