GENERAL NOTES

1. UNLESS OTHERWISE NOTED, ALL BRANCH CIRCUITS ROUTED ON SITE SHALL BE MINIMUM #10 AWG IN MINIMUM 1" CONDUITS.
2. ALL BELOW GRADE CONDUITS INSTALLED OUTSIDE OF THE BUILDING FOUNDATION SHALL HAVE A MINIMUM BURIAL DEPTH AND BE PROVIDED WITH A MINIMUM COVER OF 24" AS MEASURED FROM THE TOP OF FINISHED GRADE, OR OTHERWISE DICTATED BY CODE OR THE AHJ, WHICHEVER IS GREATER.
3. UNDERGROUND UTILITES. AT UTILITY CROSSINGS, CONTRACTOR SHALL VERIFY UTILITY DEPTHS AND COORDINATE CONDUIT ROUTING AS NECESSARY.

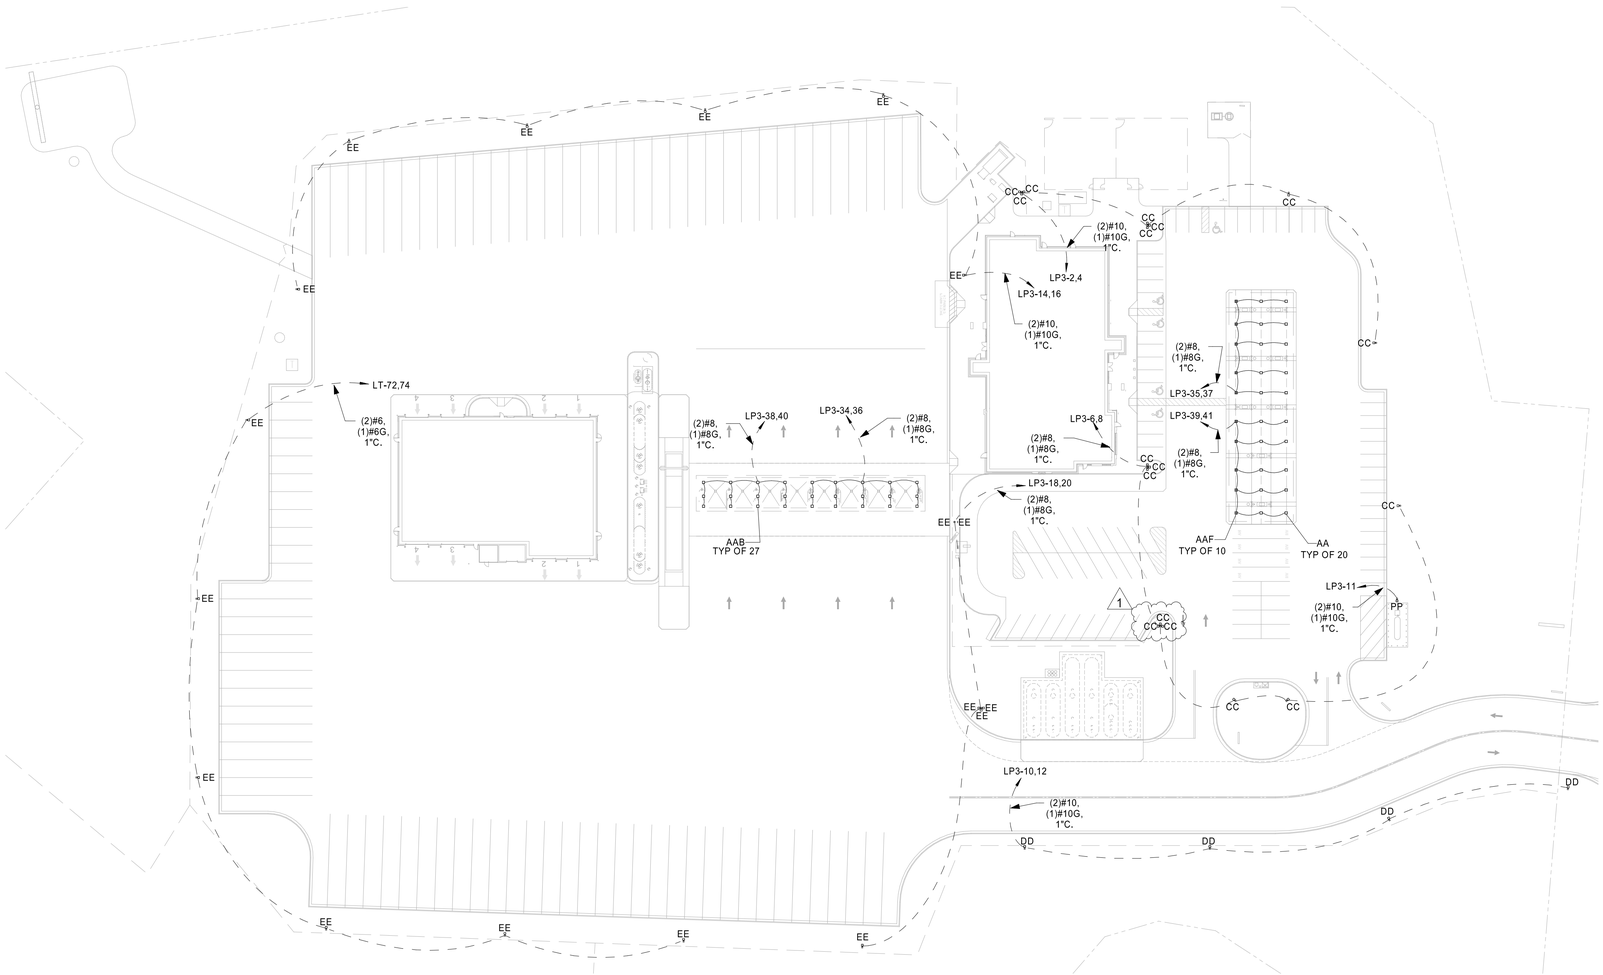

1 SITE PLAN - LIGHTING
1" = 50'-0"

HFA
HARRISON FRENCH & ASSOCIATES, LTD
t 479.273.7780
1705 S. Walton Blvd., Suite 3
Bentonville, Arkansas 72712
www.hfa-ae.com

STIPULATION FOR REUSE
THIS DRAWING WAS PREPARED FOR USE ON A SPECIFIC SITE AT NICHOLSON, MS CONTEMPORANEOUSLY WITH ITS ISSUE DATE. IT IS NOT ARCHITECTURALLY SUITABLE FOR USE ON A DIFFERENT SITE AT THIS TIME. ANY REPRODUCTION OR USE OF THIS DRAWING FOR REFERENCE BY ANYONE WHO HAS NOT FIRST PAID FOR REQUIRED THE SERVICES OF PROPERLY LICENSED PROFESSIONALS, OR ANY OTHER REPRODUCTION OF THIS DRAWING FOR ANY PURPOSE WHATSOEVER IS NOT AUTHORIZED AND MAY BE CONTRARY TO LAW.

Love's
STORE NUMBER: 860
I-59, EXIT 1
NICHOLSON, MS 39466
JOB NUMBER: 03-23-30009
TIER 1 180

ISSUE BLOCK

1	ADD 1	02/16/23

CHECKED BY:	CAR
DRAWN BY:	SED
DOCUMENT DATE:	2/7/2023
PROTO:	TIER 1 180
PROTO CYCLE:	Q4 - 2022

MISSISSIPPI LICENSED PROFESSIONAL ENGINEER
2023.02.17 12:50:37-06'00'
28109
STATE OF MISSISSIPPI

ELECTRICAL SITE PLAN - LIGHTING

SHEET:
E111

2/16/2023 7:03:56 AM
C:\Users\sedavis\Autodesk\Revit\Document\2018 Revit Properties\Love's, Nicholson, MS_MEP_T2_R18_v21_HFA Civil Bidset\Bidset.rvt
4206-E111-ELECTRICAL SITE PLAN - LIGHTING-ADD 1