


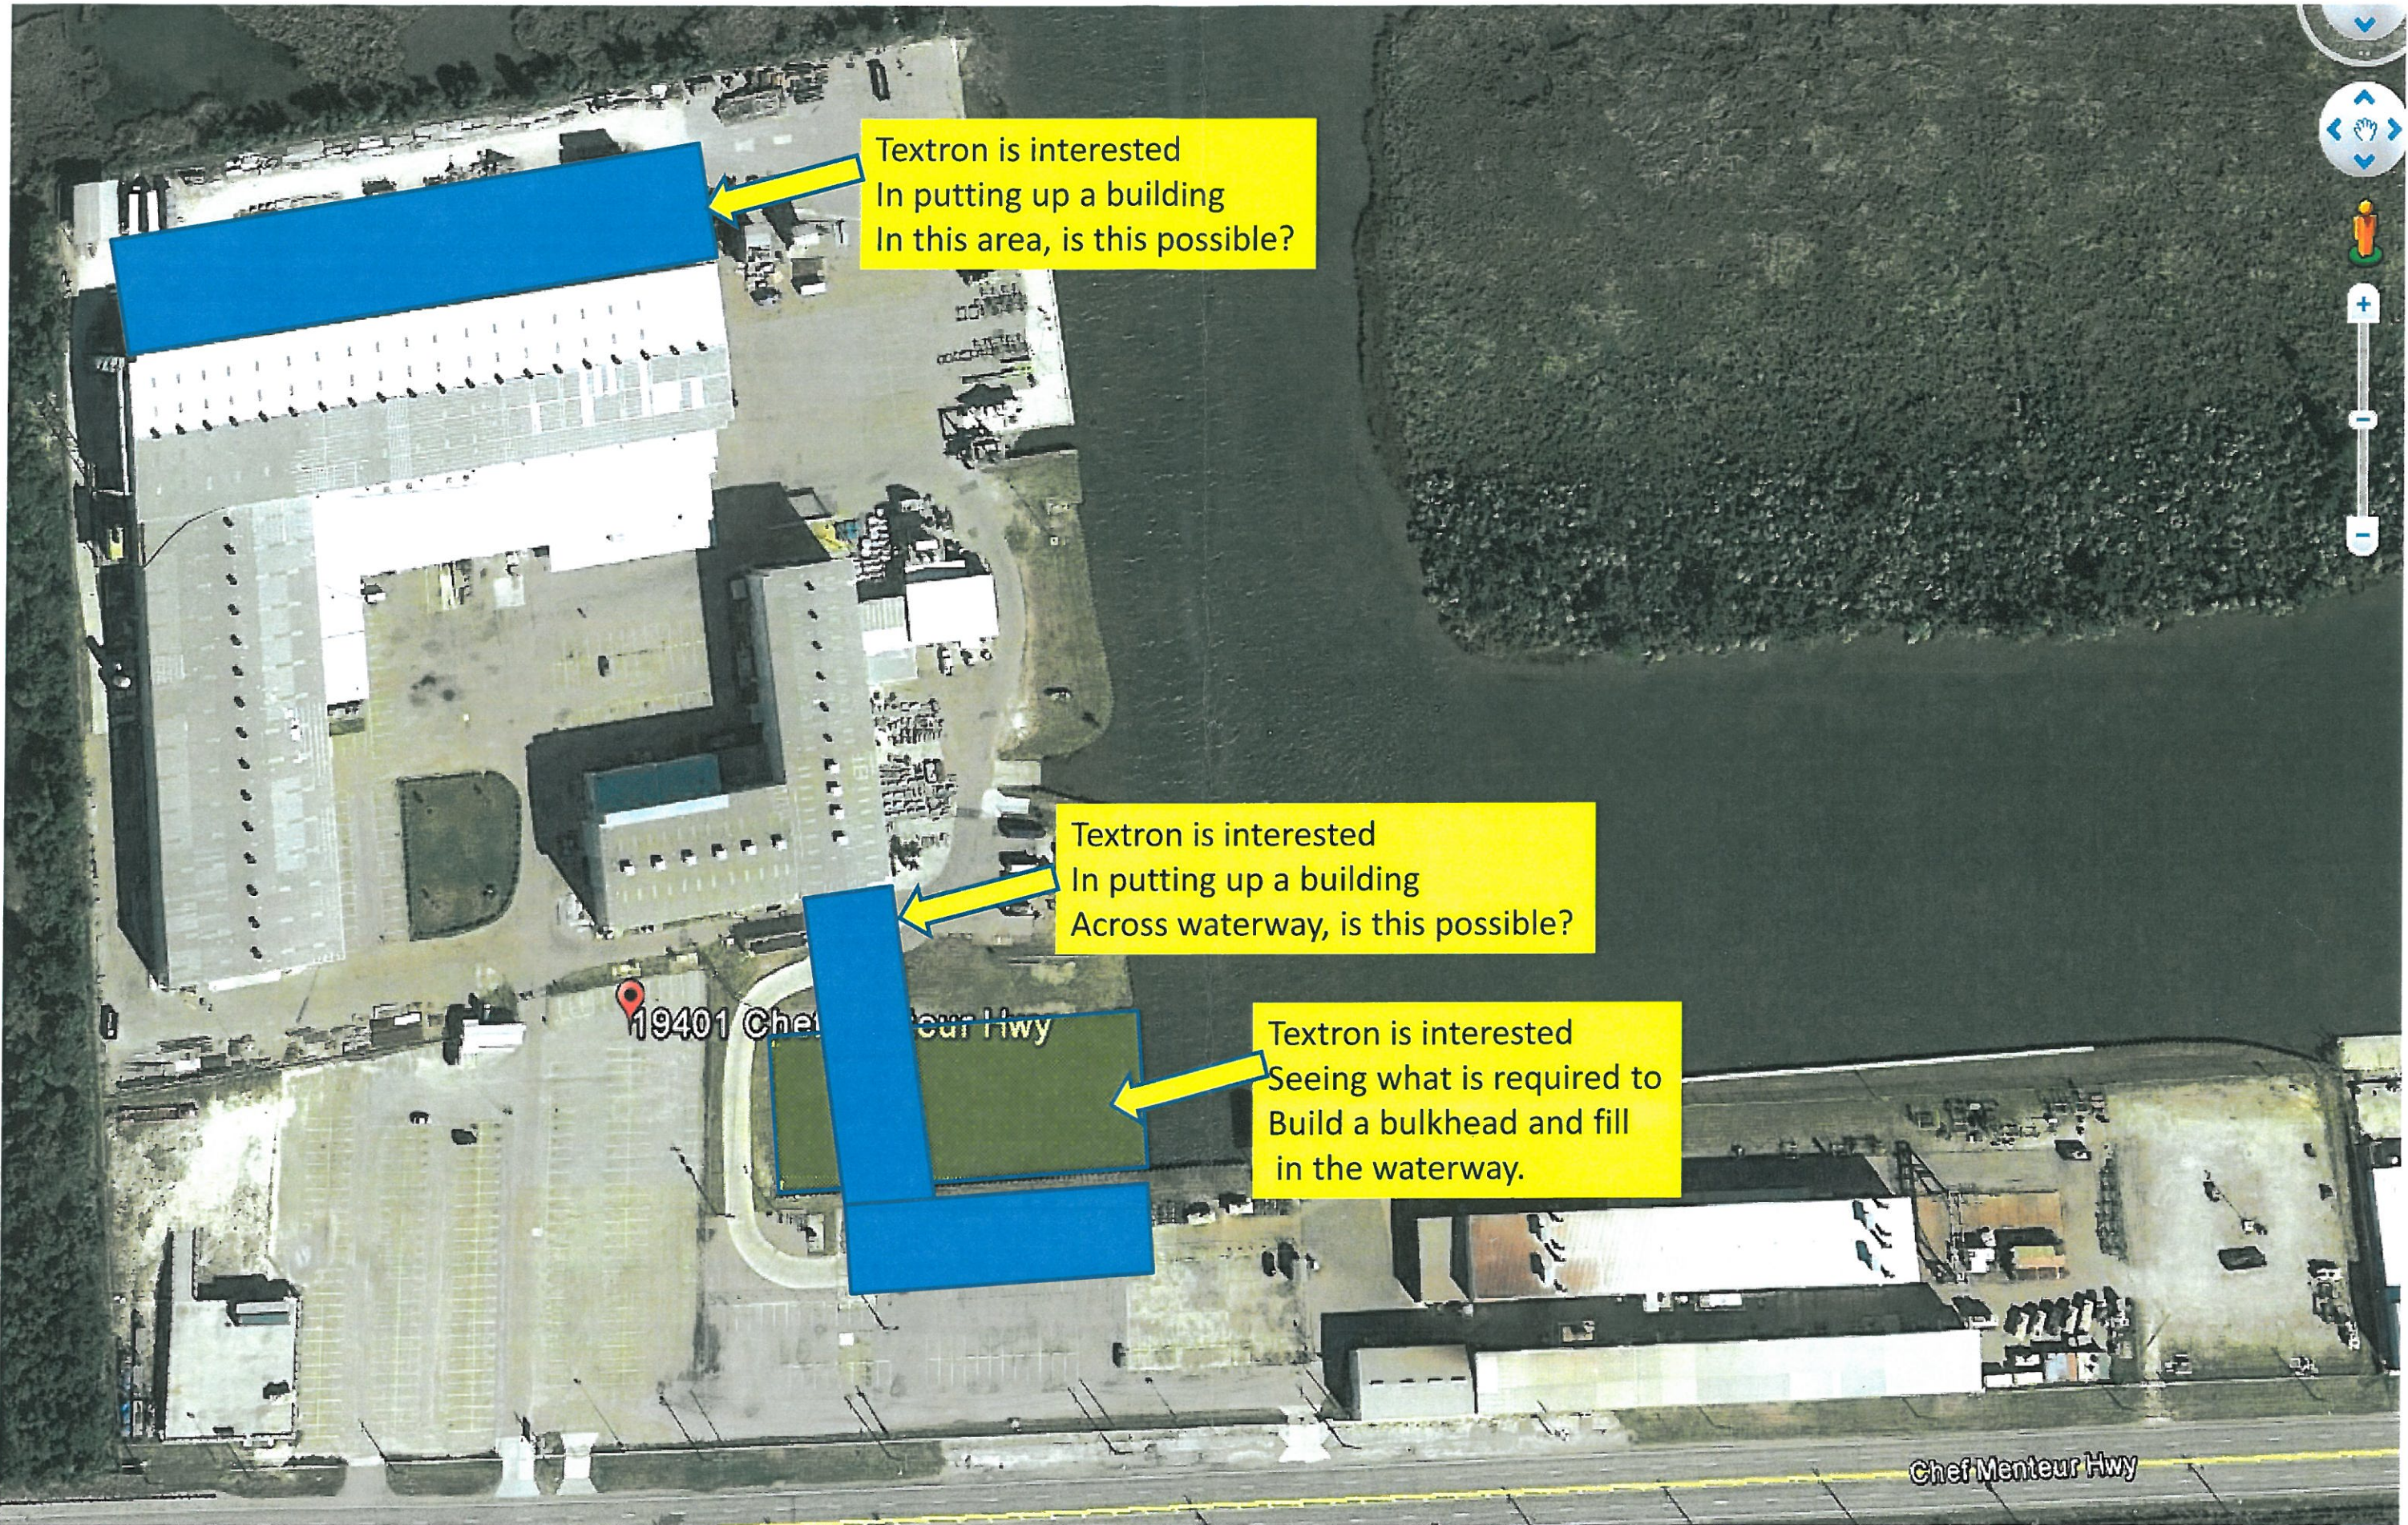

Textron is interested
In putting up a building
In this area, is this possible?

Textron is interested
In putting up a building
Across waterway, is this possible?

Textron is interested
Seeing what is required to
Build a bulkhead and fill
in the waterway.

19401 Chef Menteur Hwy

Chef Menteur Hwy