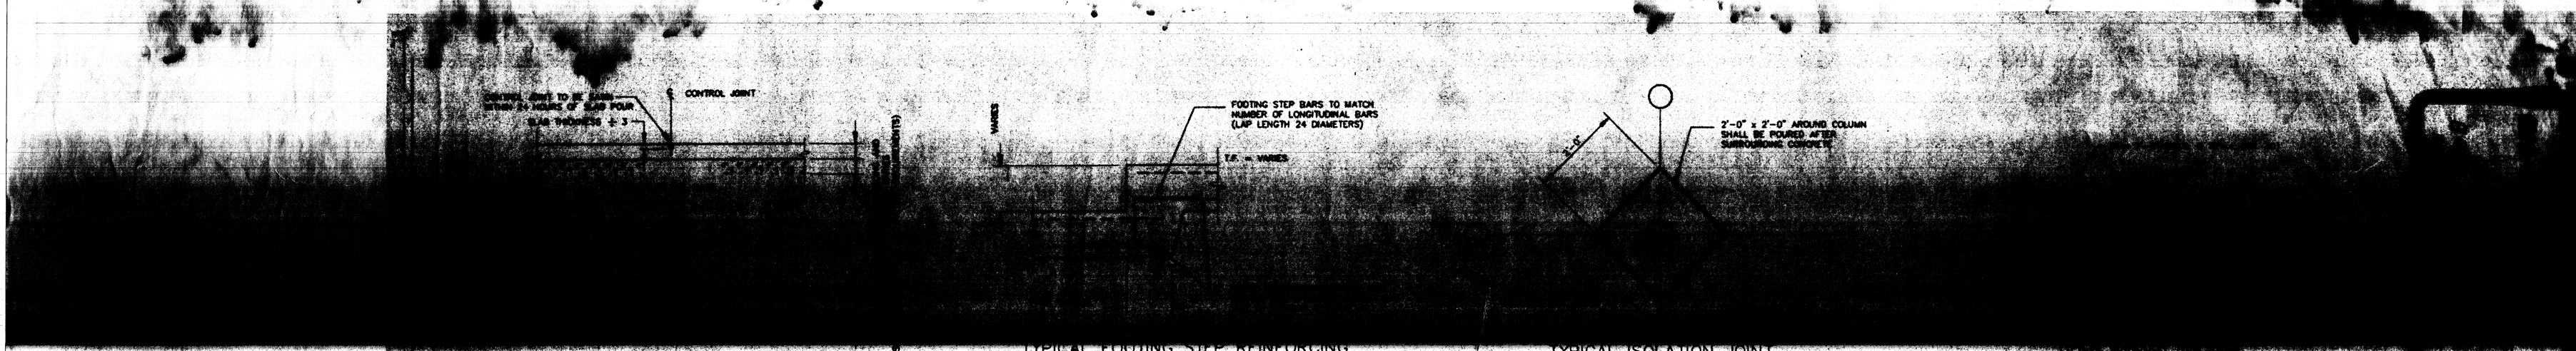

TYPICAL SLAB CONSTRUCTION JOINT

1/S3 DETAIL

SCALE: NONE

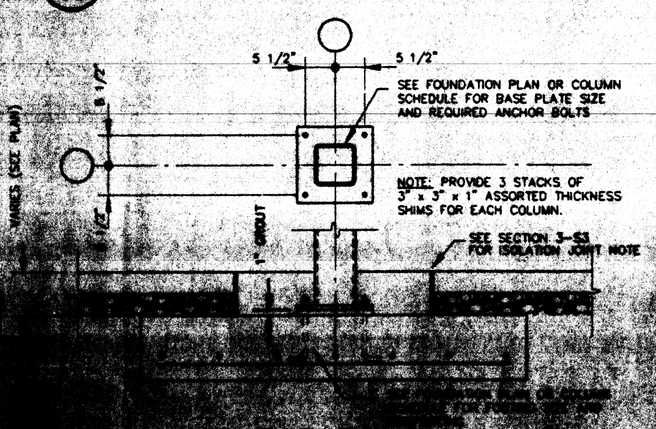

TYPICAL FOOTING STEP REINFORCING

2/S3 DETAIL

SCALE: NONE

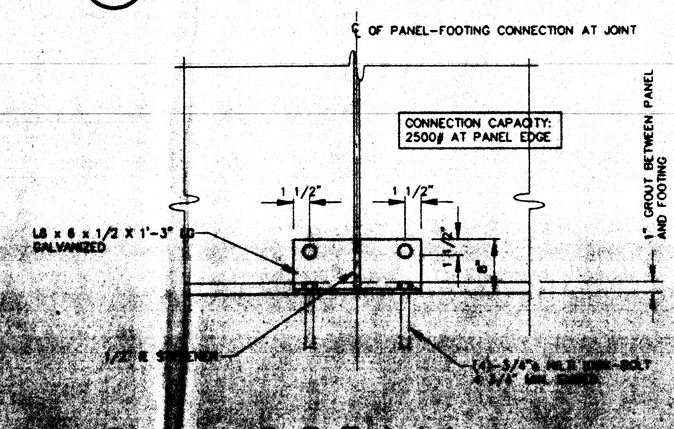

TYPICAL ISOLATION JOINT

3/S3 DETAIL

SCALE: NONE

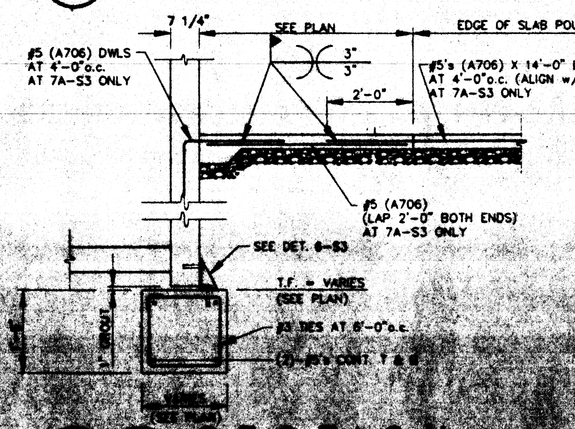

4/S3 SECTION

SCALE: 3/4" = 1'-0"

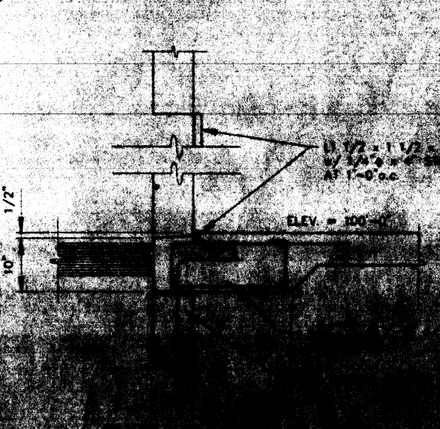

6/S3 DETAIL

SCALE: 1/2" = 1'-0"

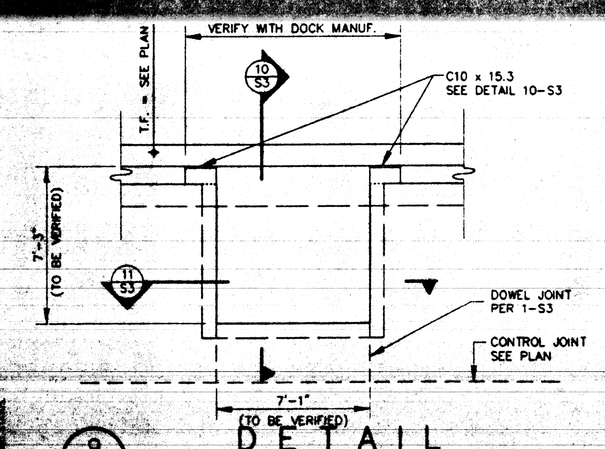

9/S3 DETAIL

SCALE: 1/4" = 1'-0"

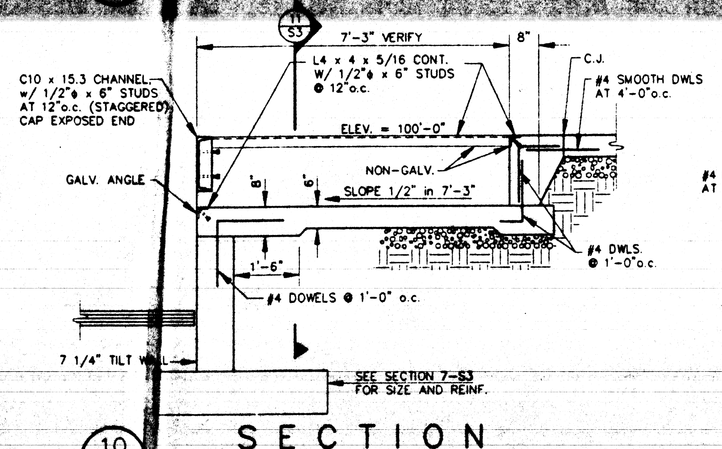

10/S3 SECTION

SCALE 1/2" = 1'-0"

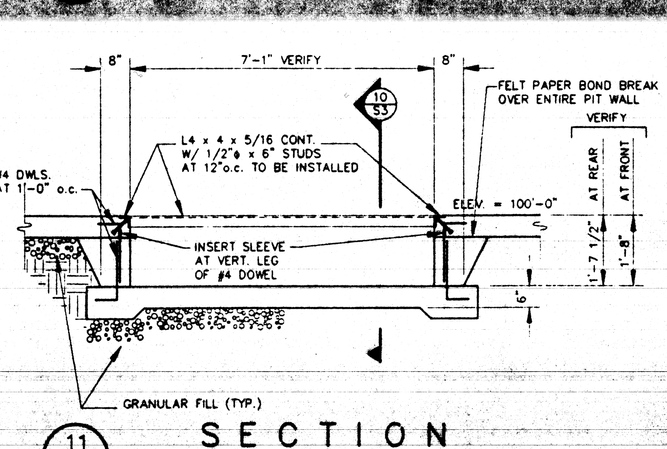

11/S3 SECTION

SCALE: 1/2" = 1'-0"

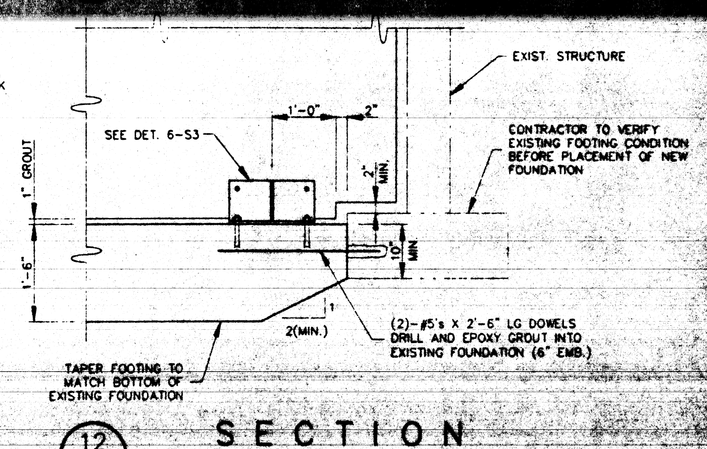

12/S3 SECTION

SCALE: 3/4" = 1'-0"

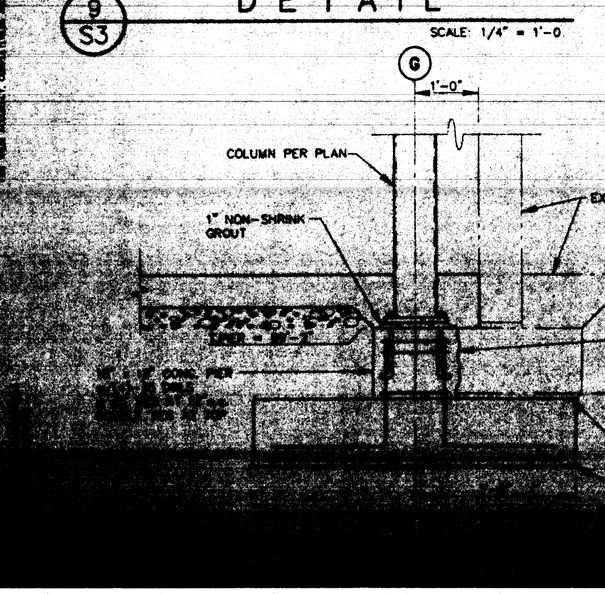

McKesson Drug

Contractor ARCO E

AS BUILTS