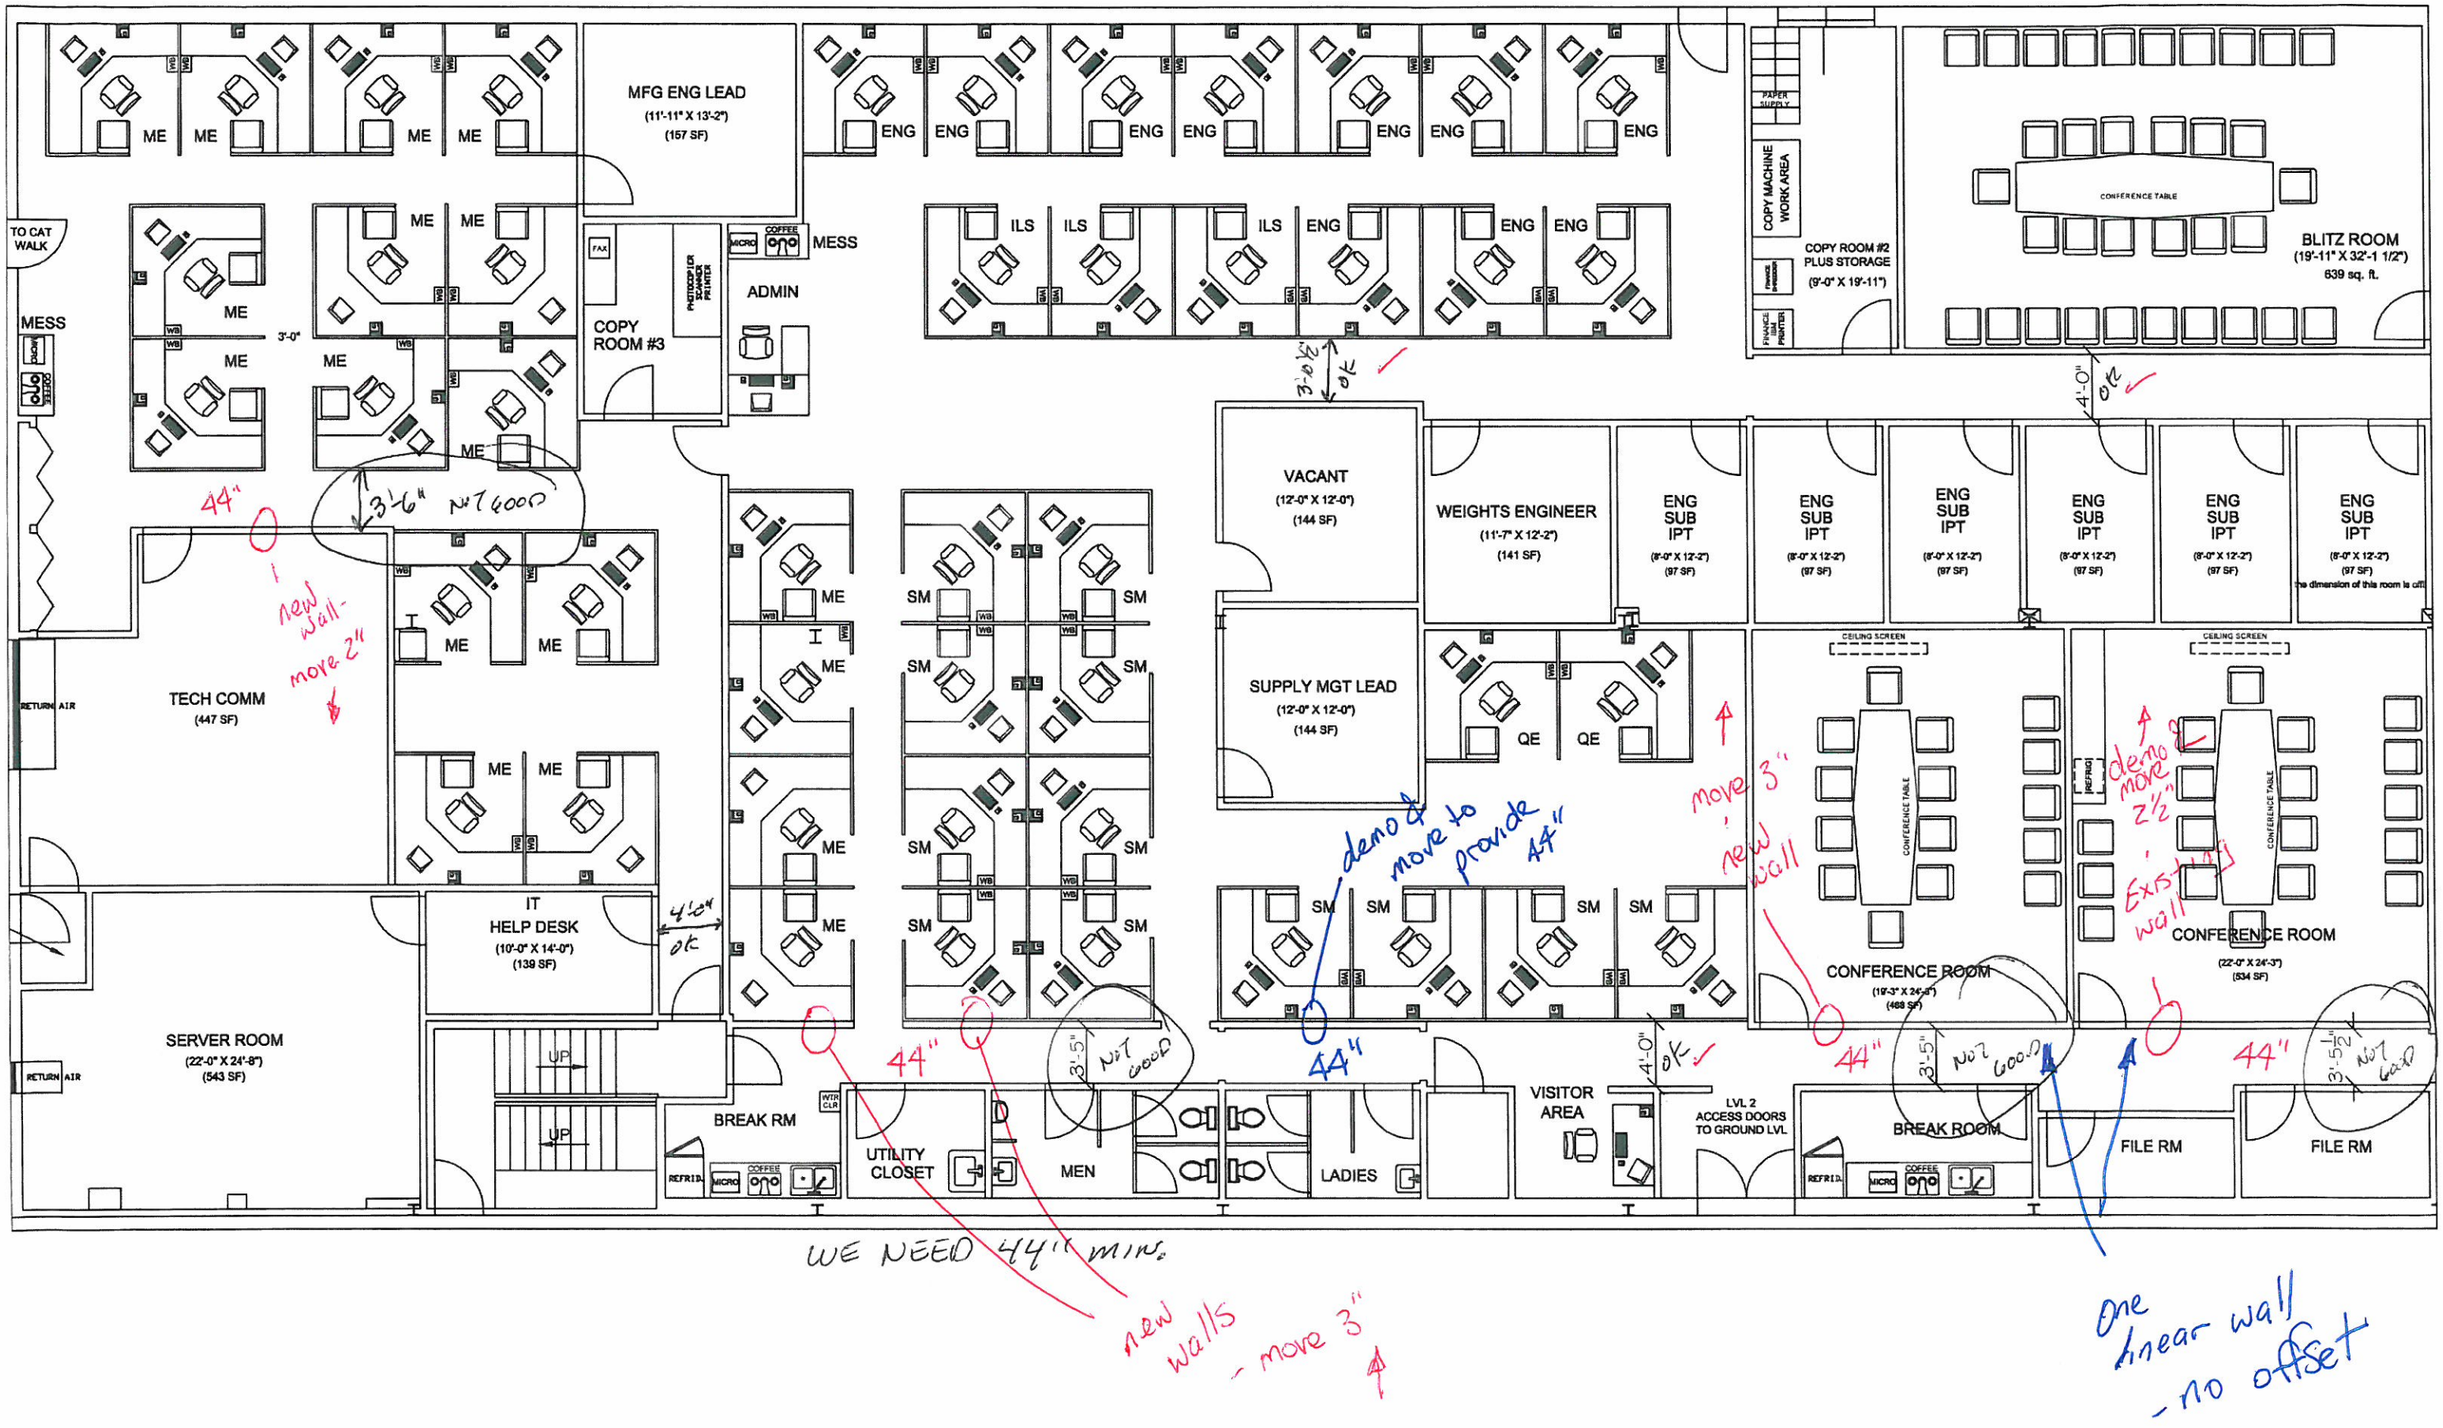
MFG ENG LEAD
(11'-11" X 13'-2")
(157 SF)
ME
ENG
ILS
TO CAT WALK
MESS
COPY ROOM #3
ADMIN
COPY MACHINE WORK AREA
COPY ROOM #2 PLUS STORAGE
(9'-0" X 19'-11")
BLITZ ROOM
(19'-11" X 32'-1 1/2")
639 sq. ft.
CONFERENCE TABLE
VACANT
(12'-0" X 12'-0")
(144 SF)
WEIGHTS ENGINEER
(11'-7" X 12'-2")
(141 SF)
ENG SUB IPT
(8'-0" X 12'-2")
(97 SF)
SUPPLY MGT LEAD
(12'-0" X 12'-0")
(144 SF)
QE
SM
TECH COMM
(447 SF)
RETURN AIR
IT HELP DESK
(10'-0" X 14'-0")
(139 SF)
SERVER ROOM
(22'-0" X 24'-8")
(543 SF)
UP
BREAK RM
UTILITY CLOSET
MEN
LADIES
VISITOR AREA
LVL 2 ACCESS DOORS TO GROUND LVL
CONFERENCE ROOM
(19'-3" X 24'-3")
(468 SF)
CONFERENCE ROOM
(22'-0" X 24'-3")
(534 SF)
BREAK ROOM
FILE RM
CEILING SCREEN
44"
3'-6"
4'-0"
ok
3'-5"
NOT GOOD
new wall - move 2"
demo & move to provide 44"
move 3" new wall
demo & move 2½" Exist wall
new walls - move 3"
WE NEED 44" MIN.
One linear wall - no offset