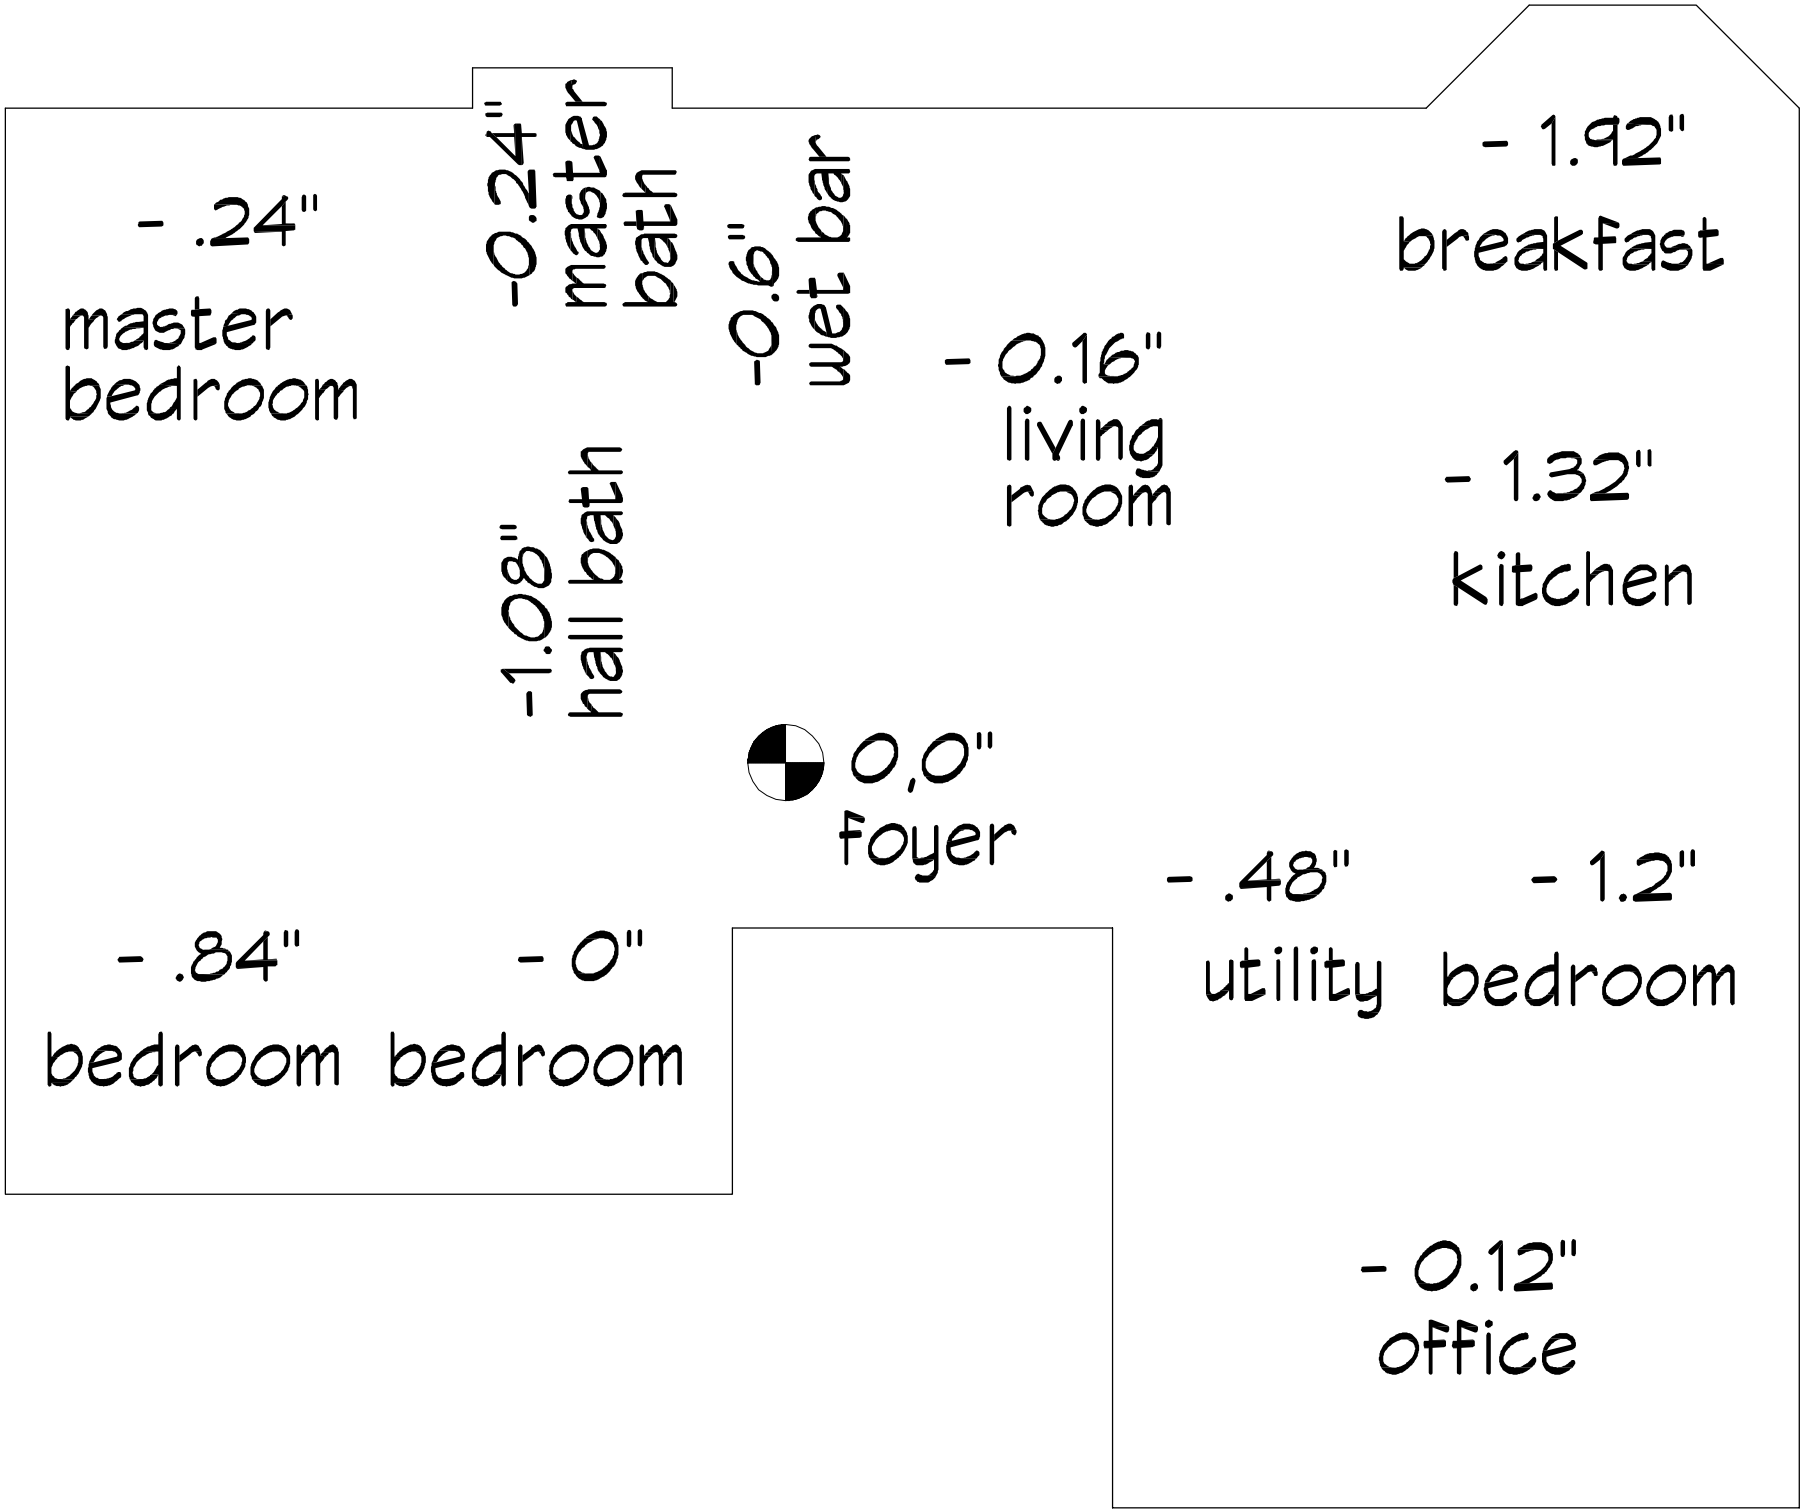
- .24"
master bedroom
-0.24"
master bath
-0.6"
wet bar
- 0.16"
living room
- 1.92"
breakfast
- 1.32"
kitchen
-1.08"
hall bath
0,0"
foyer
- .48"
utility
- 1.2"
bedroom
- .84"
bedroom
- 0"
bedroom
- 0.12"
office