


First Floor

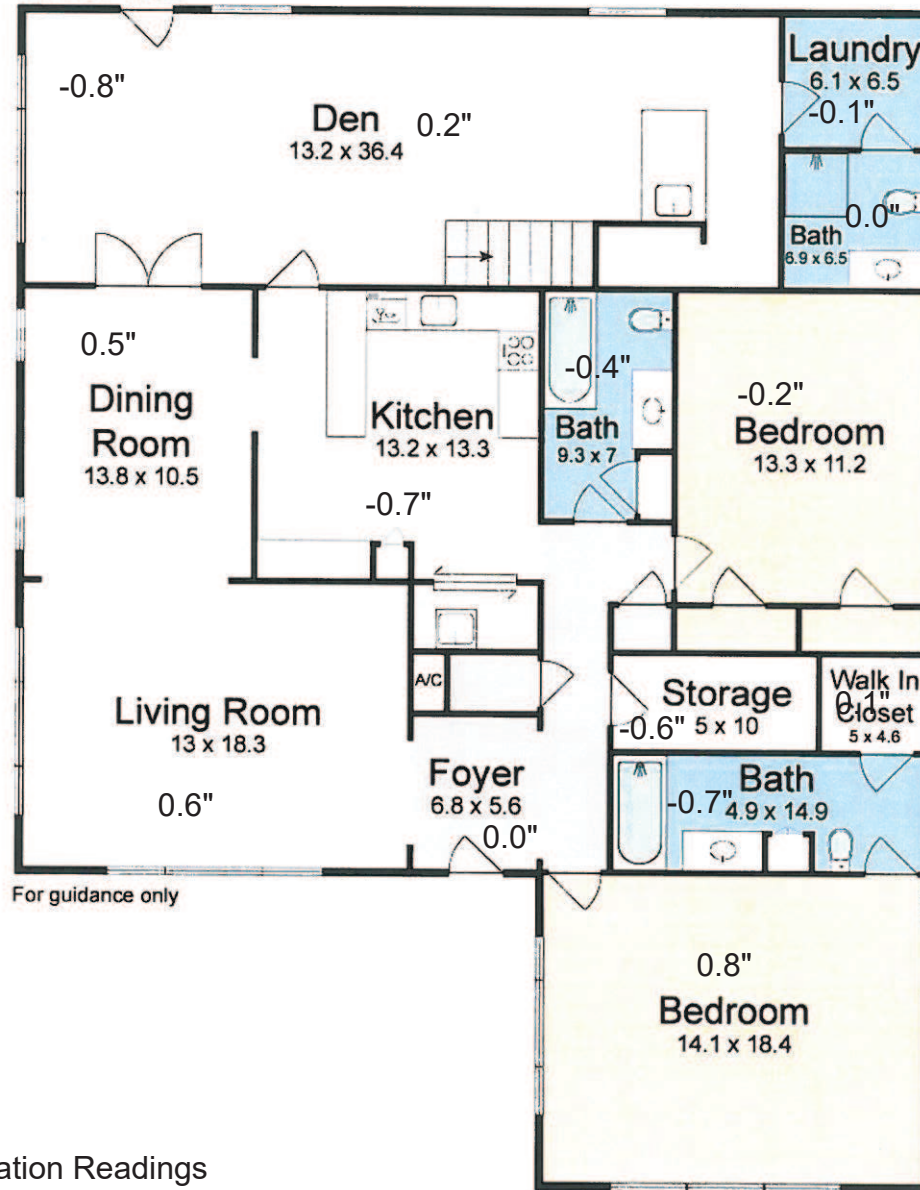

Elevation Readings