


MARK	SIZE		DESCRIPTION
	W	H	
1	3/0	6/8	1 3/4" SEE BUILDER EXT. DOOR
2	"	"	" S/C FLUSH " "
3	2/4	"	" 1 3/8" H/C " INT. "
4	2/0	"	" " " " " "
5	"	"	" " POCKET " "
6	1/6	"	" " " " " "
7	5/0	"	1 1/8" LOUVERED BIFOLD " "
8	3/0	"	" " " " " "
9	5/0	"	" CASED OPENING " "
10	2/0	"	" " " " " "
11	"	6/0	1 1/8" GLASS SHOWER DOOR
12	12/0	6/8	" ALUMINUM PATIO " "
13	6/0	"	" " " " " "
14	2/0	4/0	" SKYLITE " "
15	6/0	"	" HIS ALUMINUM WDO. " "

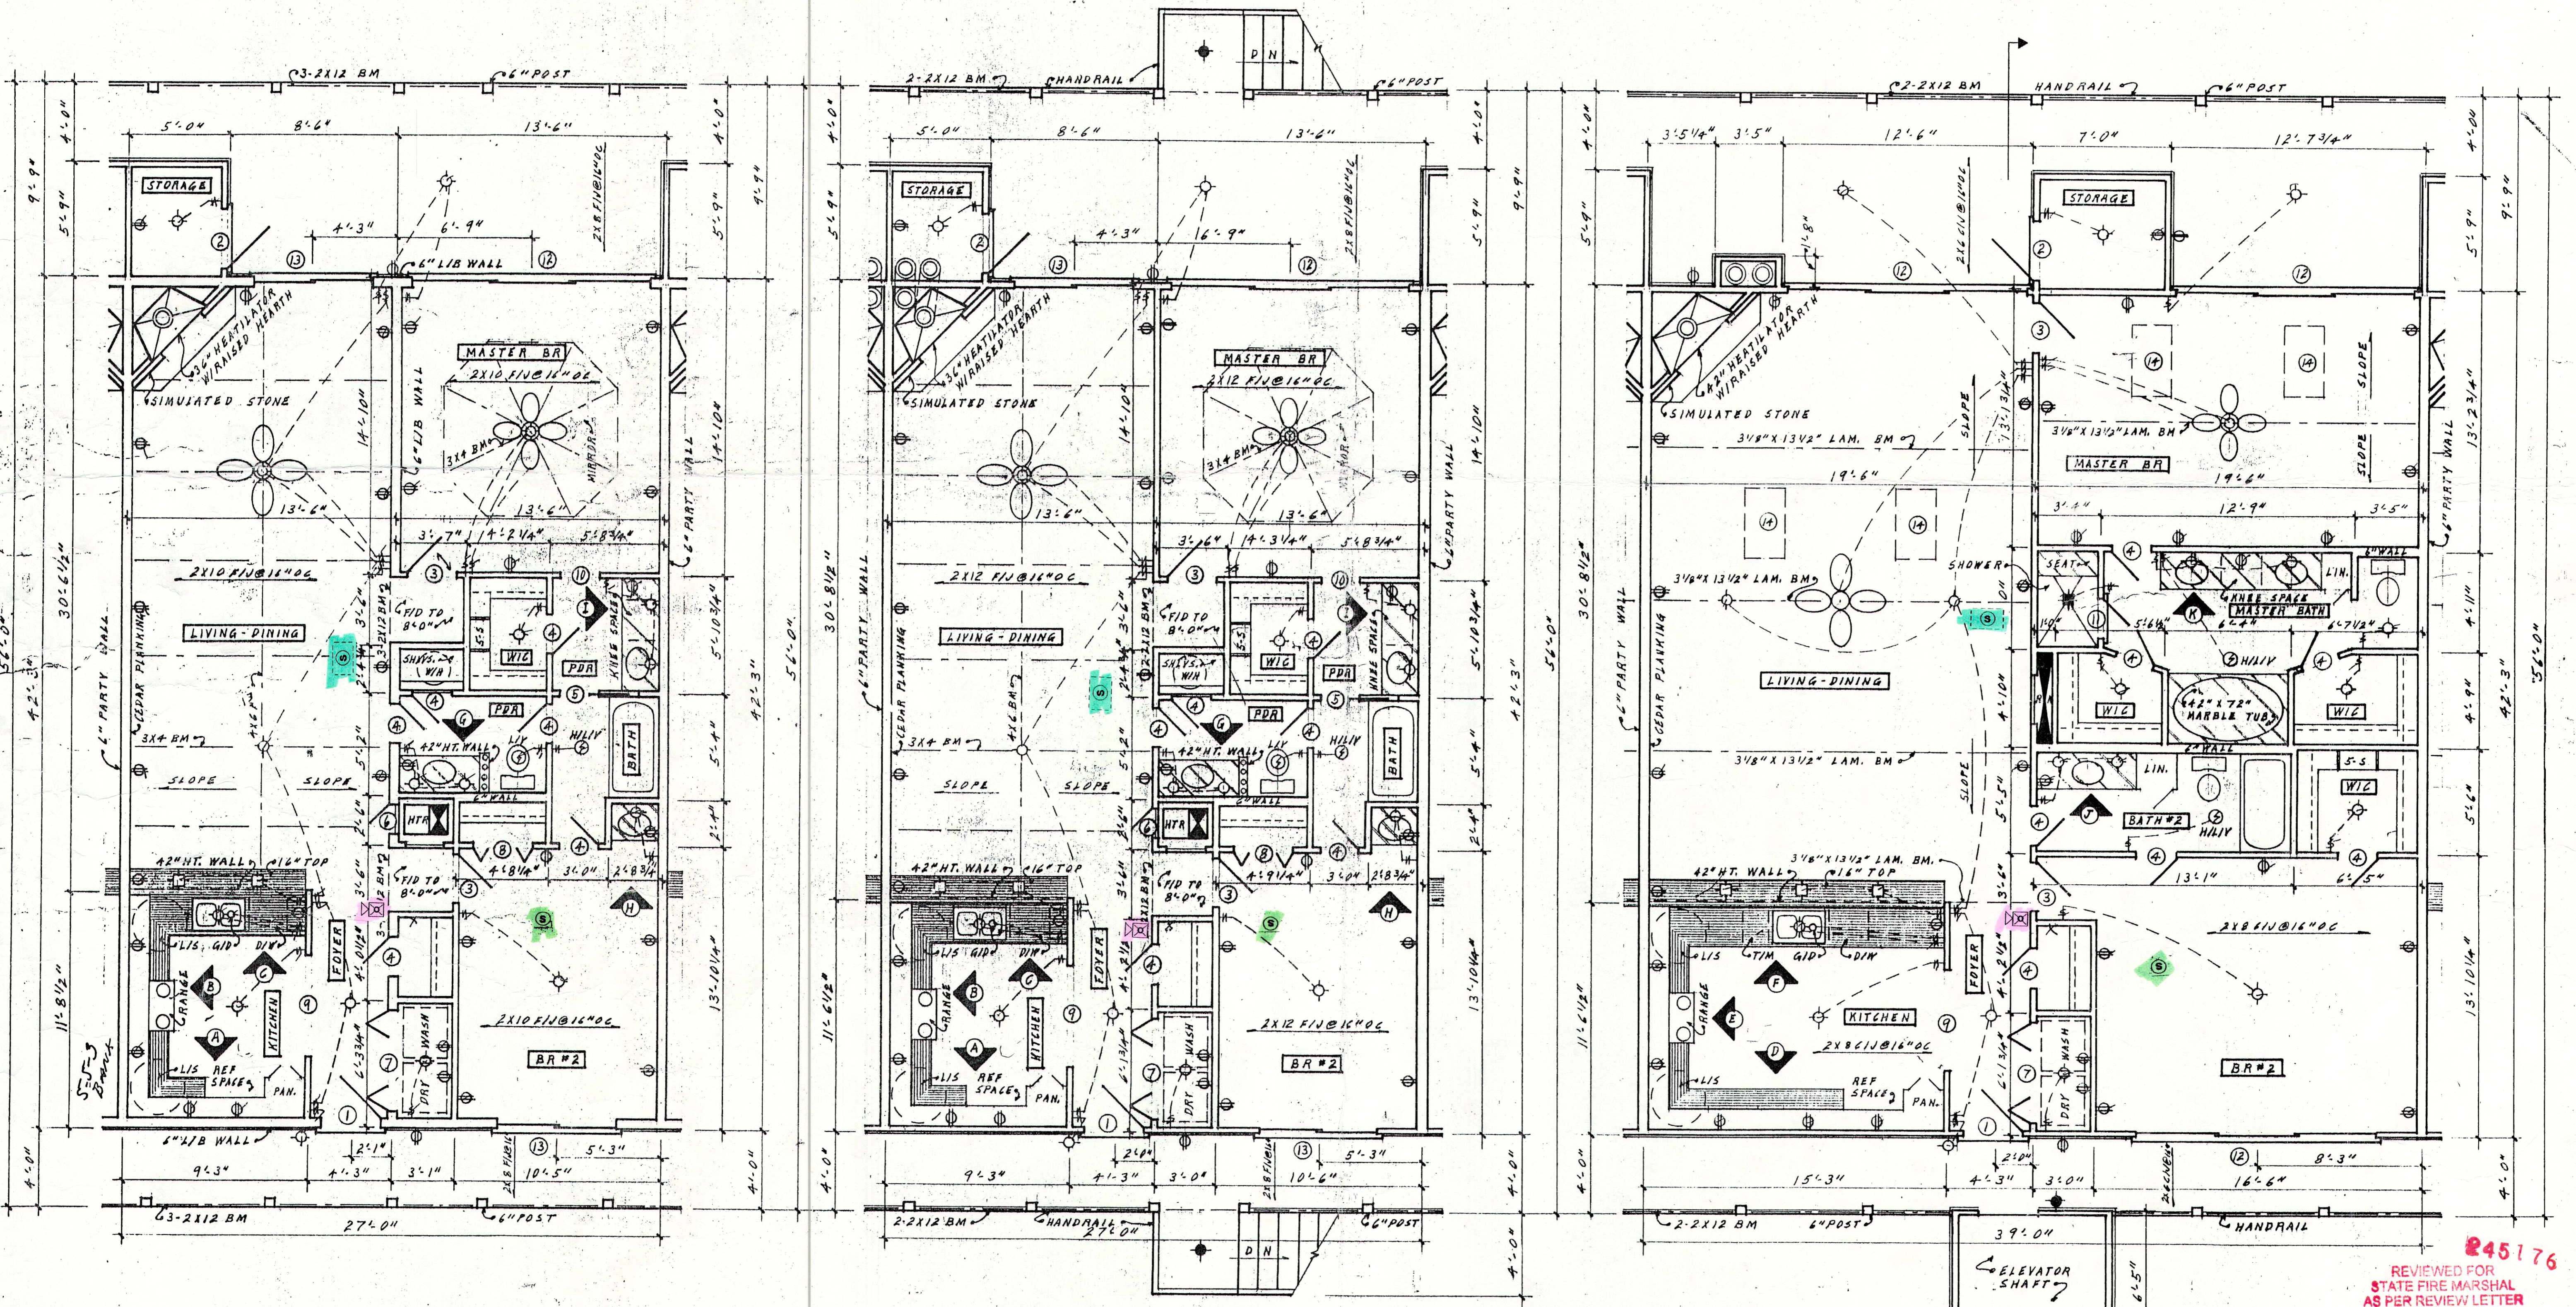

TYP. 1ST FL. UNIT WALL HT. 10'-1 1/8" L/A=1141 U/B=1512

TYP. 2ND FL. UNIT WALL HT. 10'-1 1/8" L/A=1141 U/B=1512

TYP. 3RD FL. UNIT WALL HT. 8'-1 1/8" L/A=1648 U/B=2184

245176
 REVIEWED FOR
 STATE FIRE MARSHAL
 AS PER REVIEW LETTER
 BY RON C. MATHIS
R. C. Mathis