


• TYP. SECTION @ PARTY WALL •

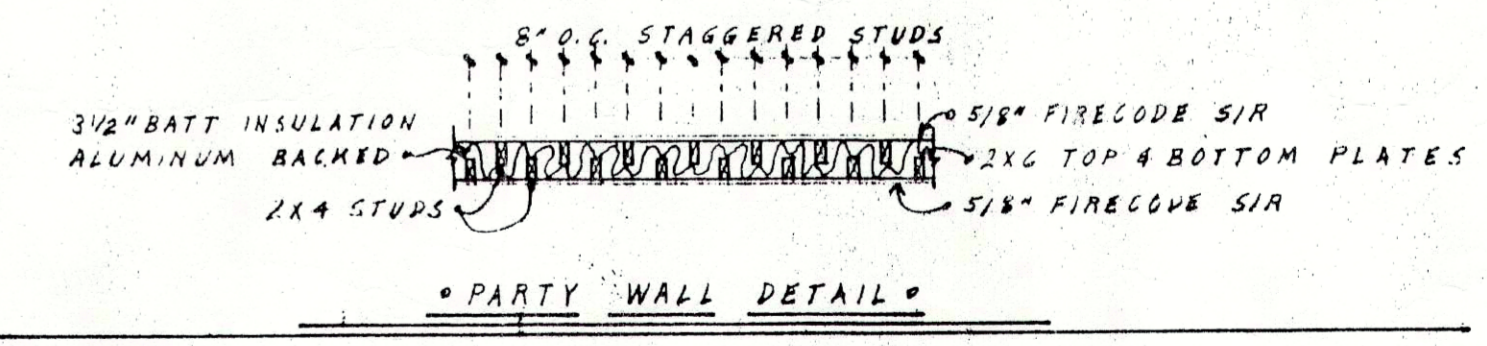

• PARTY WALL DETAIL •

REVIEWED FOR
STATE FIRE MARSHAL
AS PER REVIEW LETTER
BY RON C. MATHIS
Ron C. Mathis
245176



Mike Zweifel Home Designs

(504) 641-7168

1253 GAUSE BLVD. SUITE 201
SLIDELL, LOUISIANA 70458

PLANS FOR: DONALD JACOBS
GRAND LAGOON CONDOMINIUMS
DATE: 3-31-84
SCALE: 3/8" = 1'-0"
DRAWN BY: [Signature]
BF: LA 12-499
SF: UB 24-958
CABINET ELEV. & PARTY WALL DETAILS
PLAN NUMBER: 1112
FILE NUMBER: 1112

