


# BAY #3

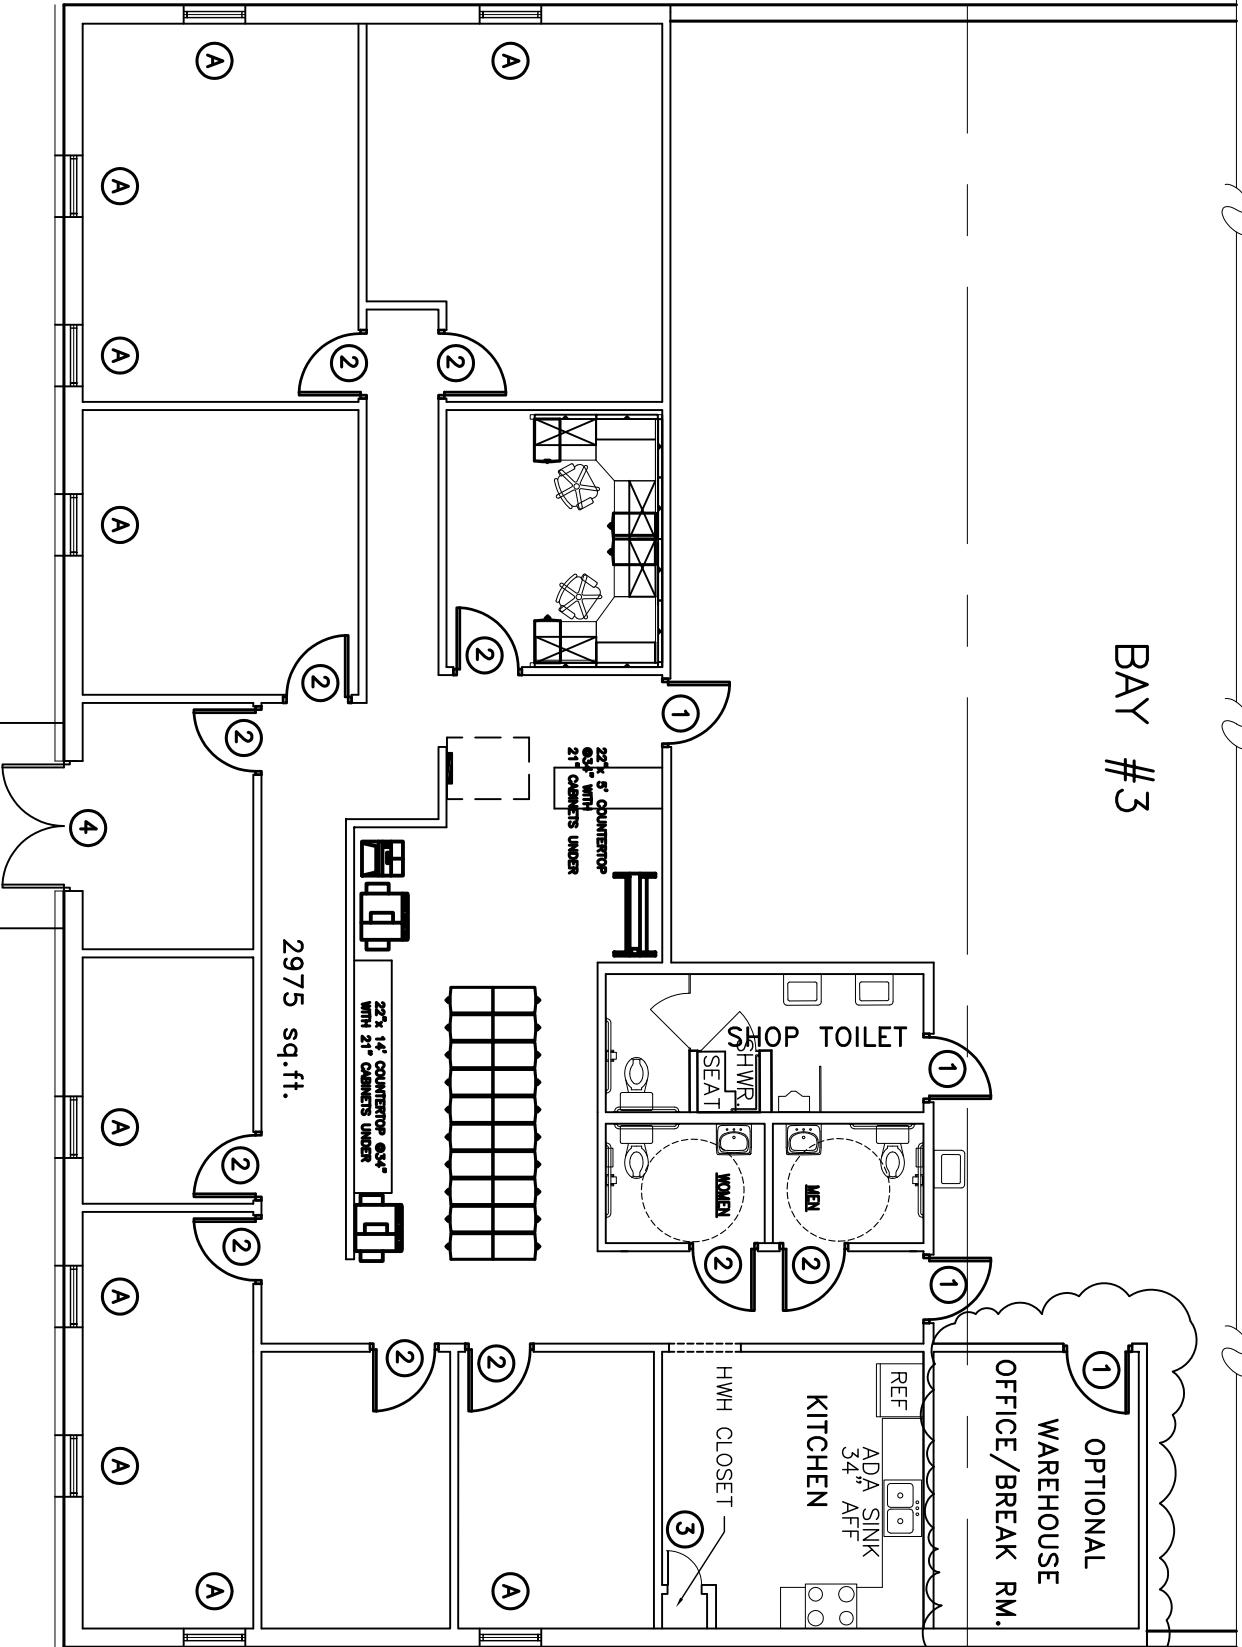

1	5/8"
2	3/4"
3	1/2"
4	8-3/4"
5	
6	
7	
8	

WINDIC
A 3/4"