


1040 0st

RICK RICE
BUILDOUT

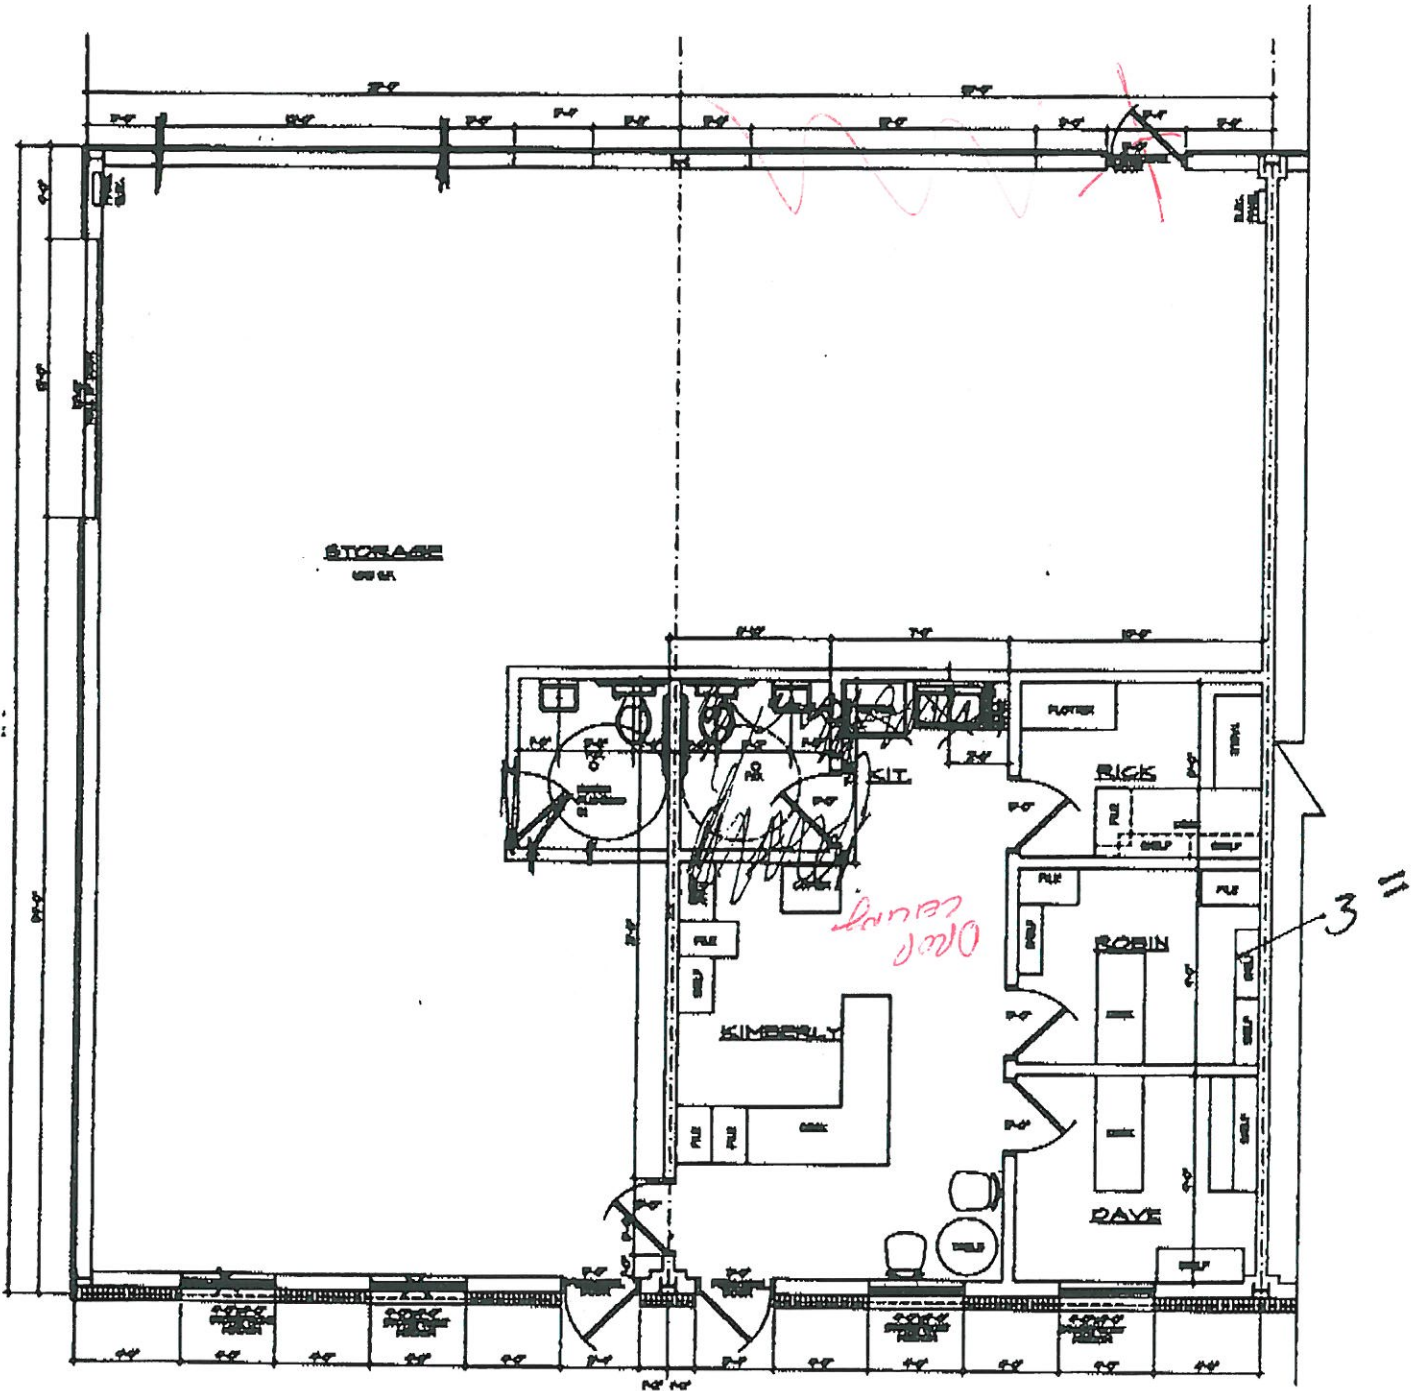





1841

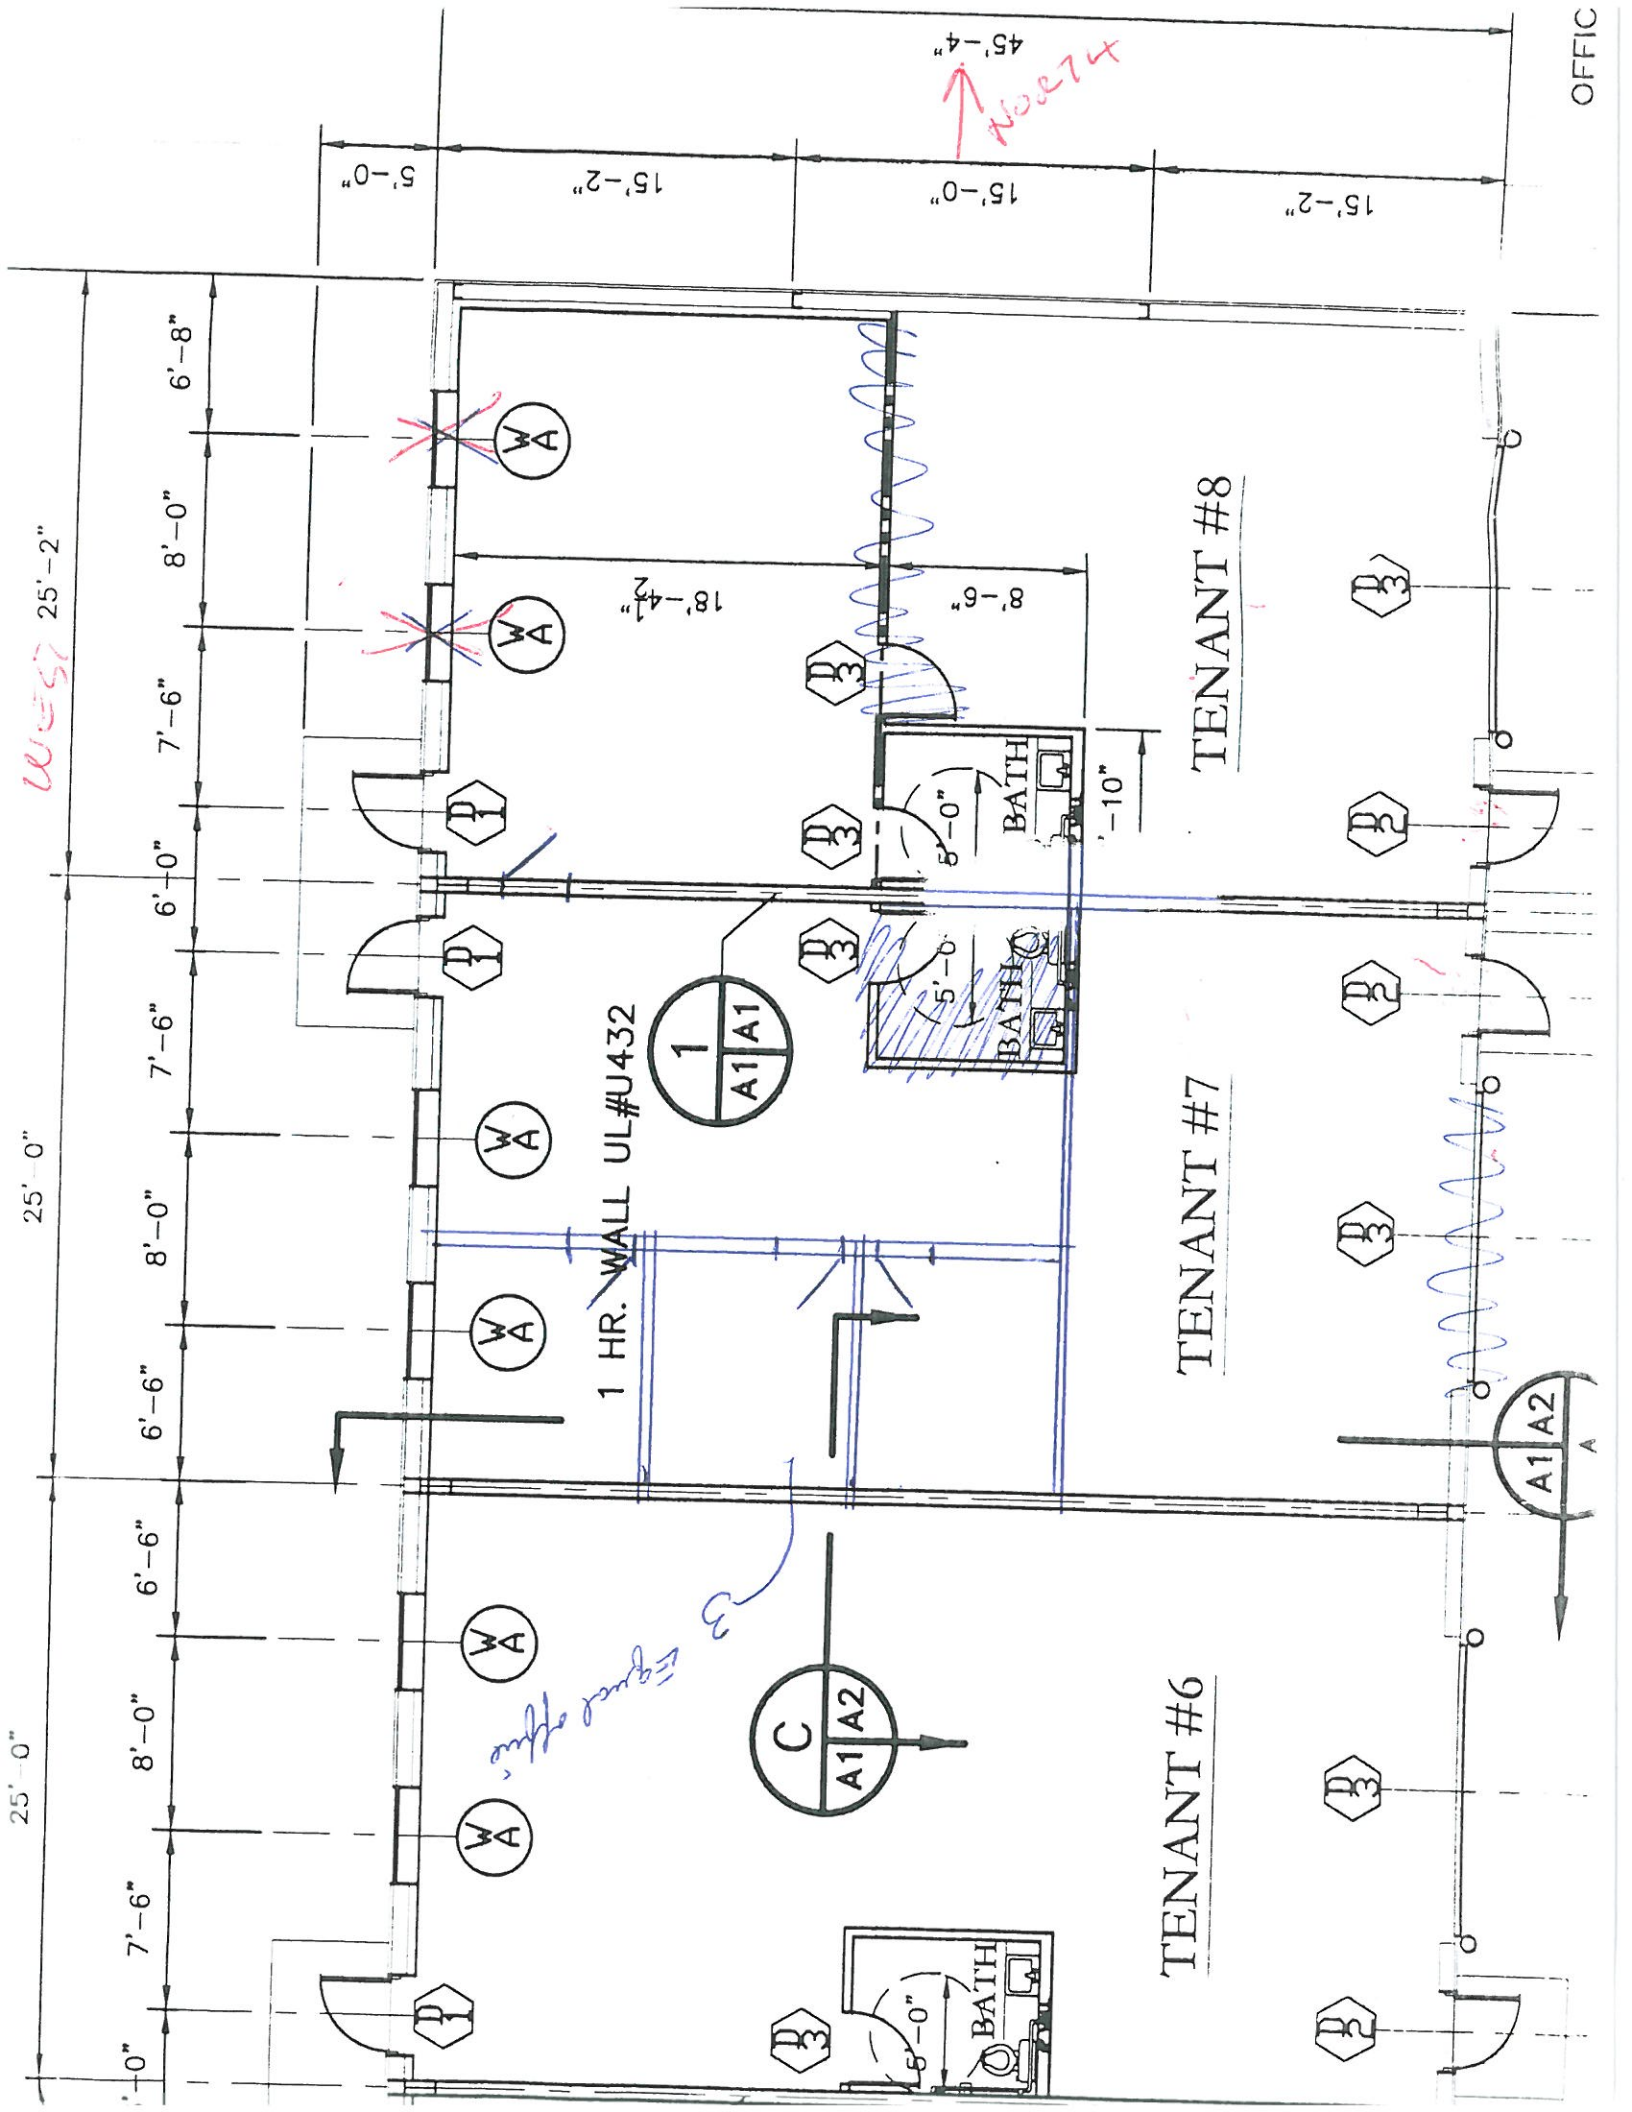

WEST 25'-2"

North
45'-4"

OFFICE

25'-0"

25'-0"

7'-0"
7'-6"
8'-0"
6'-6"
6'-6"
8'-0"
7'-6"
6'-0"
7'-6"
6'-8"



1 HR. WALL UL#U432



TENANT #6

TENANT #7

TENANT #8

