


U . S . I N T E R S T A T E H W Y . 1 2

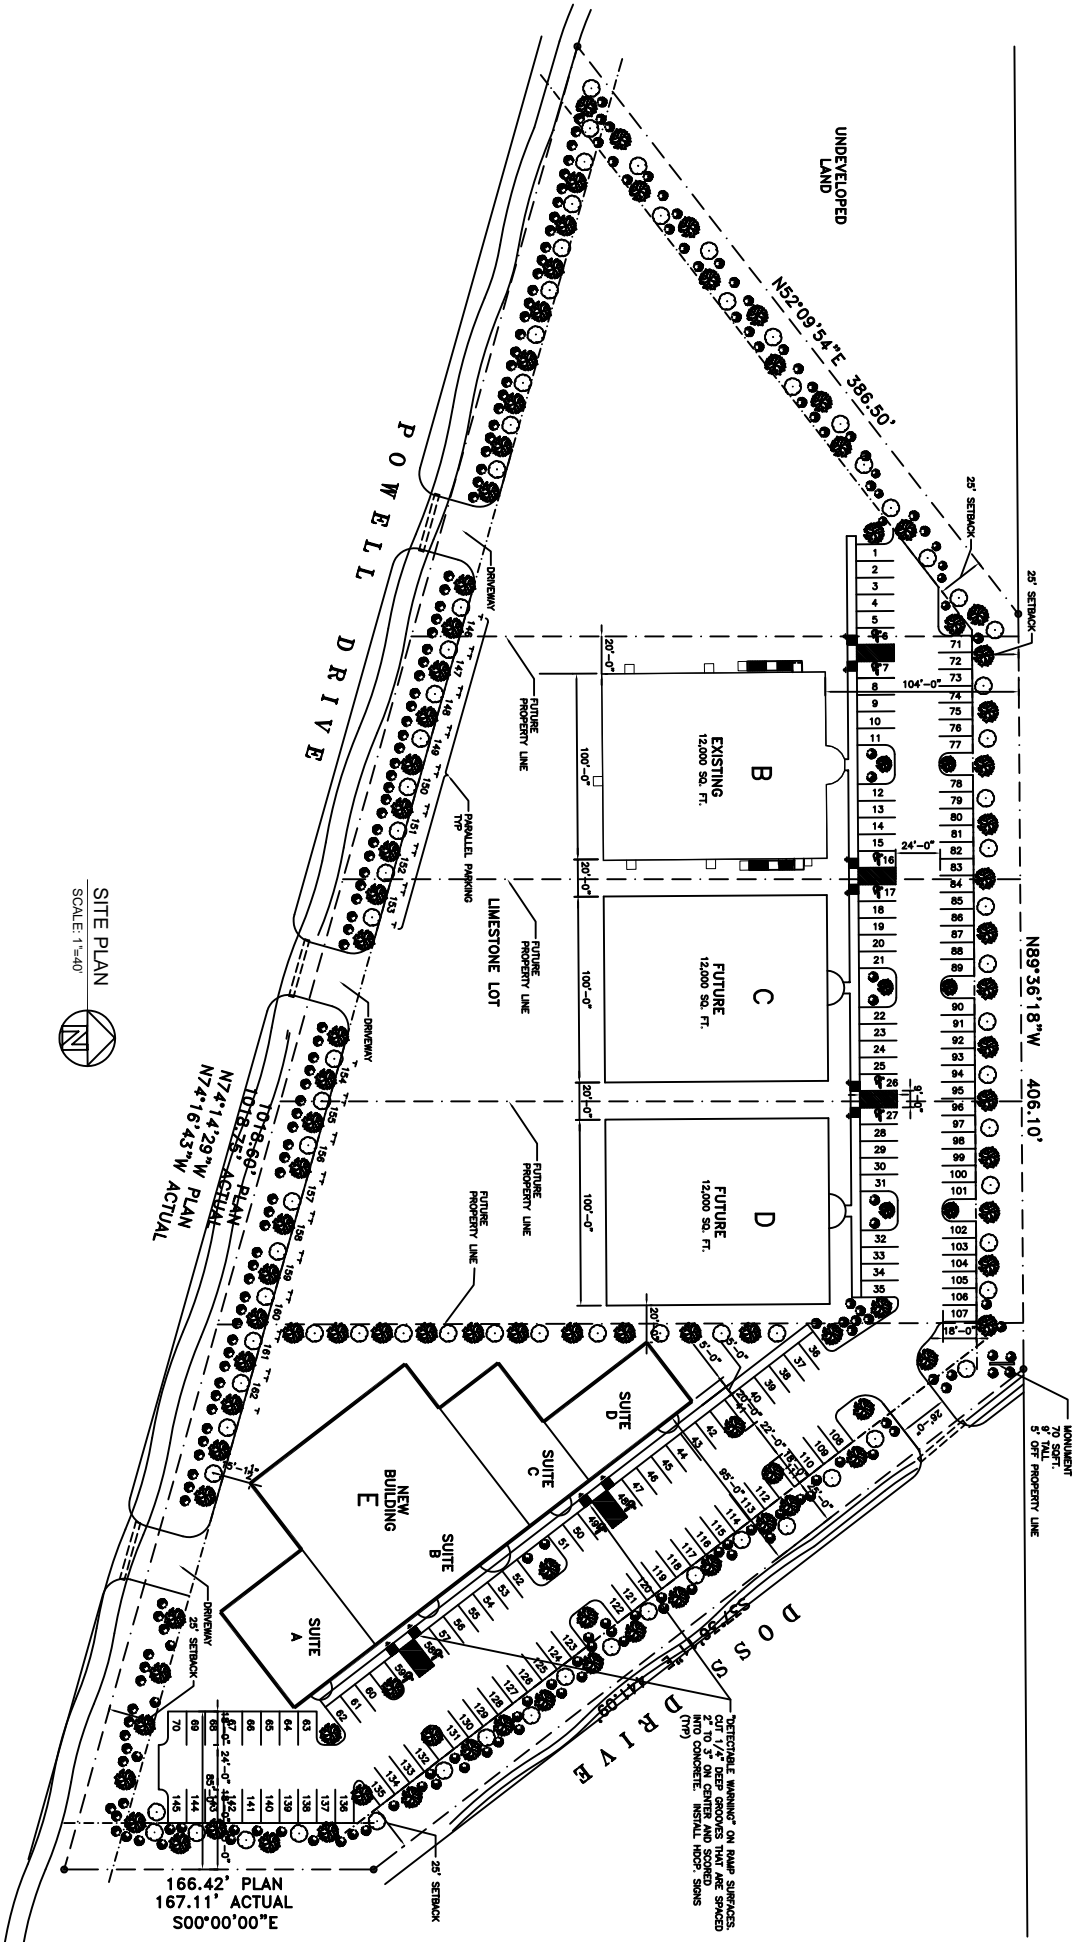

SITE PLAN
SCALE: 1"=40'

- CLASS A 12.5" MINIMUM UP TO 11' MEASURED AT
- CLASS B 12.5" MINIMUM UP TO 8' MEASURED AT
- CLASS C 12.5" MINIMUM UP TO 6' MEASURED AT
- SHRUB

(U75)

166.42' PLAN
167.11' ACTUAL
S00°00'00"E