


METAL PASSIVE VENTILATION LOUVER W/ BIRD SCREEN TO MATCH METAL BLDG. SIDING, TYP. OF 2, 18"H x 36" L, LOCATE IN FIELD AS REQUIRED

SEE SECTION "C" BELOW

1/2" SS ROOFING

JBOX FOR SIGNAGE BY OTHERS, SEE ELECT. (TYP OF 2)

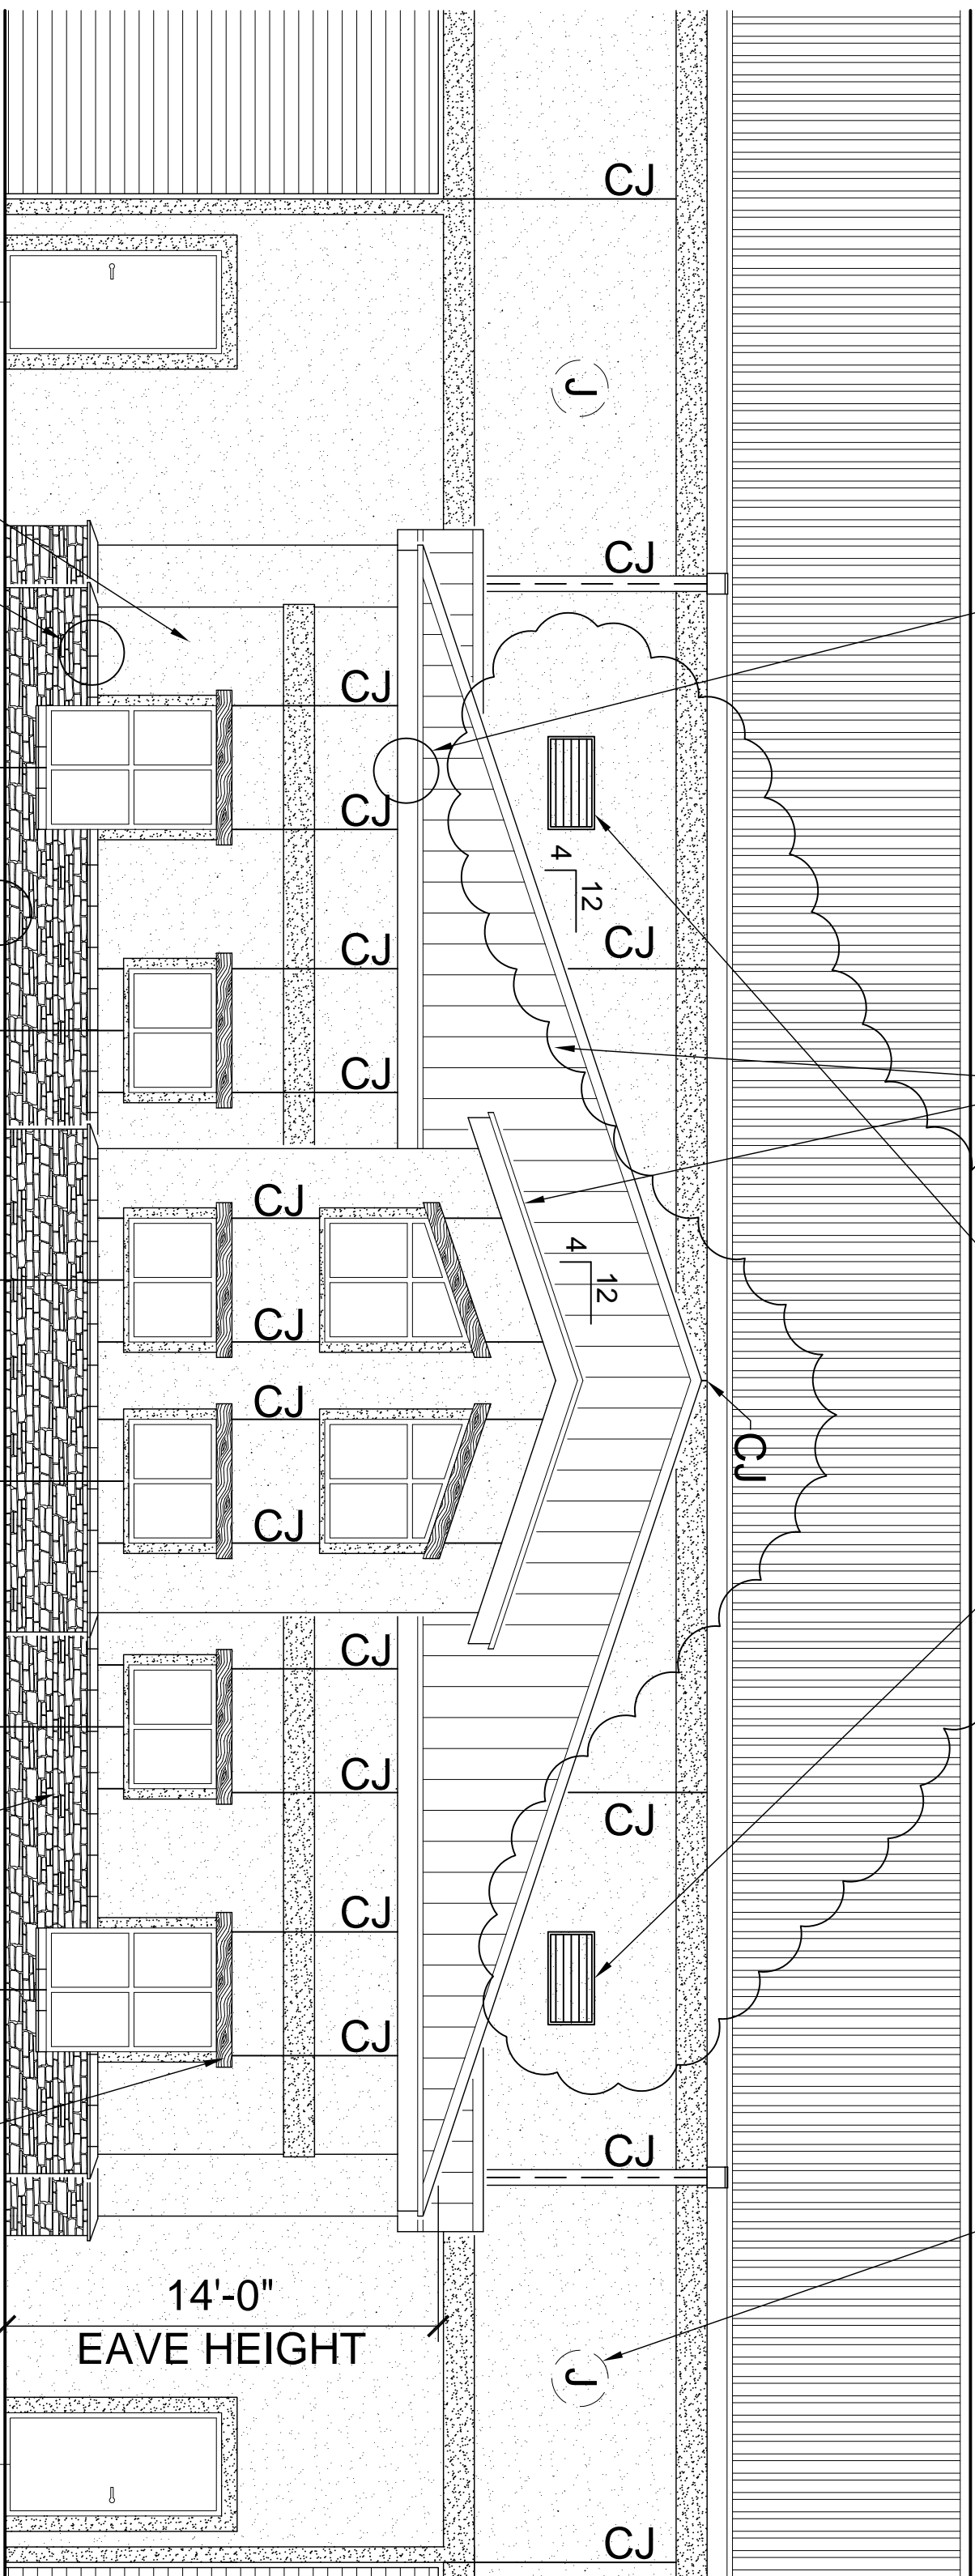

SEE SECTION "B" BELOW

SEE SECTION "A" BELOW

TREATED WOOD SEE DETAIL ON T

EAST ELEVATION