

DAMMON
ENGINEERING, INC.

CHIEF ENGINEER
EMMETT
DAMMON, P.E.

CHIEF ARCHITECT
ROBERT
WILTSE

1095 FLORIDA AVENUE
SLIDELL, LA 70458
OFFICE 985-649-5832
FAX 985-641-5950

WEBSITE
WWW.DAMMONENGINEERING.COM
EMAIL:
DAMMONENG@BLSOUTH.NET

ARCHITECTURE
ENGINEERING
STUDIES
PLANNING
INVESTIGATION
EXPERT WITNESS

OFFICE
RENOVATION /
ADDITION

M NATAL
CONTRACTORS, INC.
394 VOTERS ROAD
SLIDELL, LA

FLOOR

SCALE AS NOTED

DATE: 07-16-08


A-1

OF 12

THIS ROOM WILL BE AN OFFICE NOW. THE DOOR AND THE RATING WILL BE ELIMINATED.

THIS ROOM WILL REMAIN THE SAME NAME AND RATING BUT THE DOOR FROM THE PLAN ROOM HAS BEEN ELIMINATED.

REMOVE DOOR AND CLOSE IN WALL

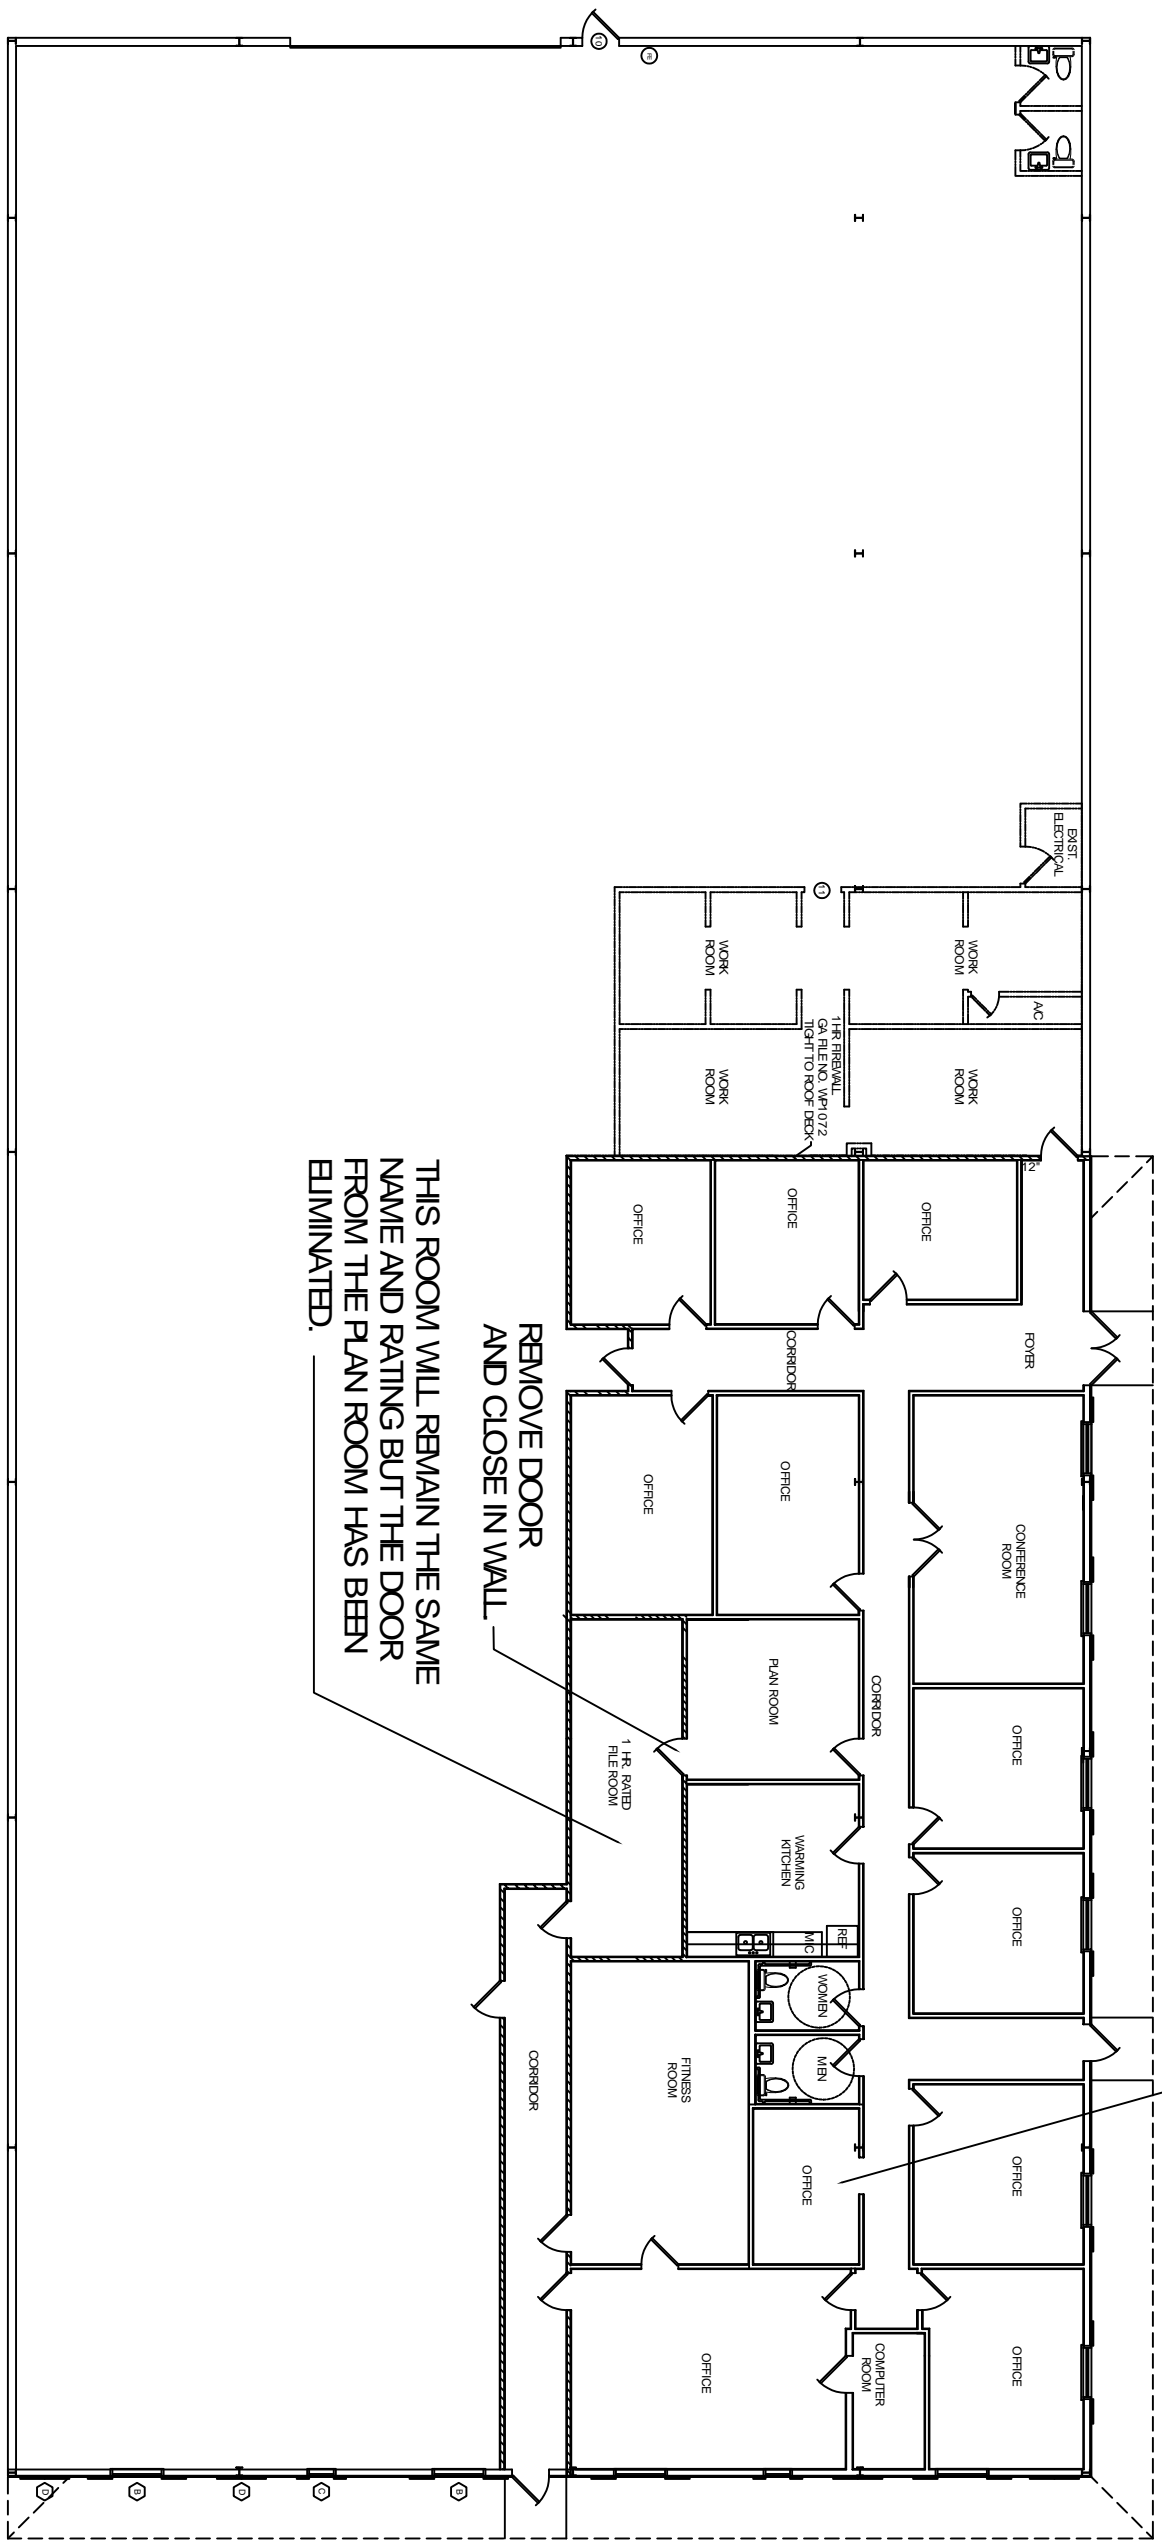

FLOOR PLAN
SCALE: 1/8" = 1'-0"

