




1030 ALL
103

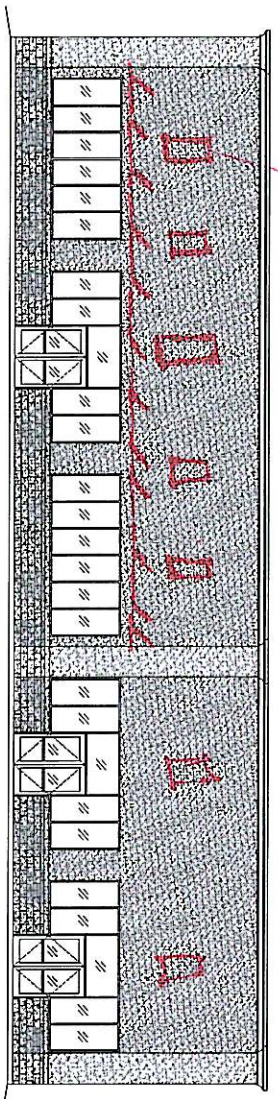


FRONT ELEVATION
SCALE: 3/8" = 1'-0"

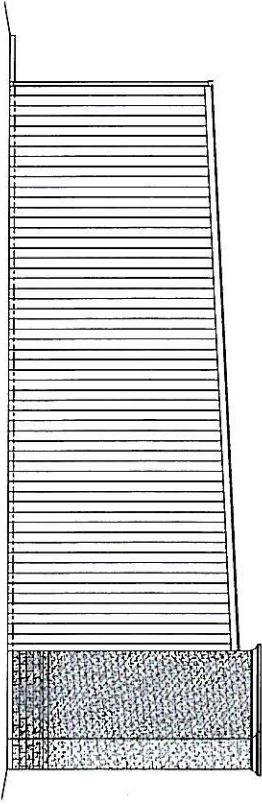

LEFT ELEVATION
SCALE: 3/8" = 1'-0"

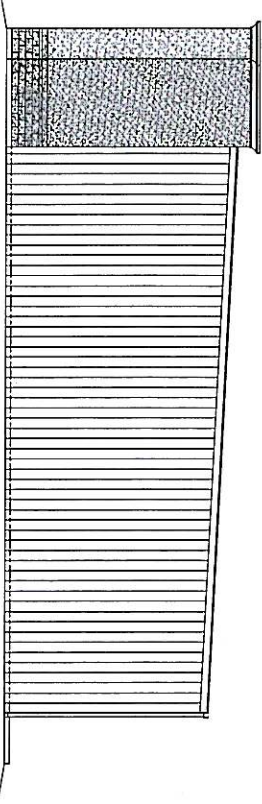

RIGHT ELEVATION
SCALE: 3/8" = 1'-0"

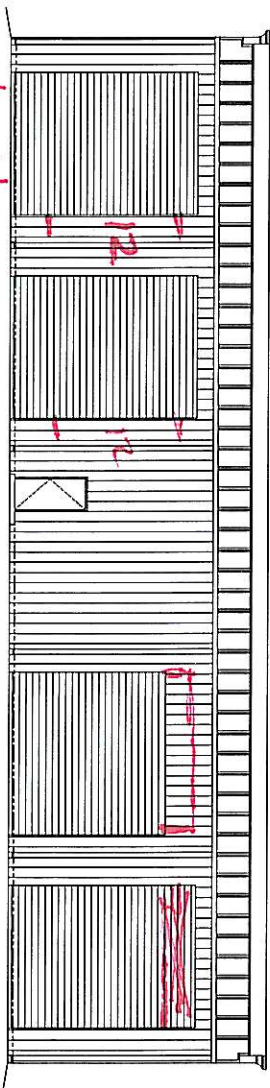

REAR ELEVATION
SCALE: 3/8" = 1'-0"

110' | 112' | 112' | 110'

PRELIMINARY (NOT FOR CONSTRUCTION)



DAMMON
ENGINEERING, INC.
CHIEF ENGINEER
EMANUEL
DAMMON, P.E.
CHIEF ARCHITECT
ROBERT
WILCOE
554 OLD SPANISH TRAIL
SUITE 1A, 70408
ORLANDO, FL 32809
PH: 954-541-5590
FAX: 954-541-5590

WWW.DAMMONENGINEERING.COM

ARCHITECTURE
ENGINEERING
PLANNING
INTERIOR DESIGN

RAY HORVATH
RETAIL
PREMEAUX
AVENUE
SLIDELL, LA

EXTERIOR
ELEVATIONS

REV:	
SCALE:	AS NOTED
JOB#:	2073
DATE:	05-06-11
SHEET:	A-3