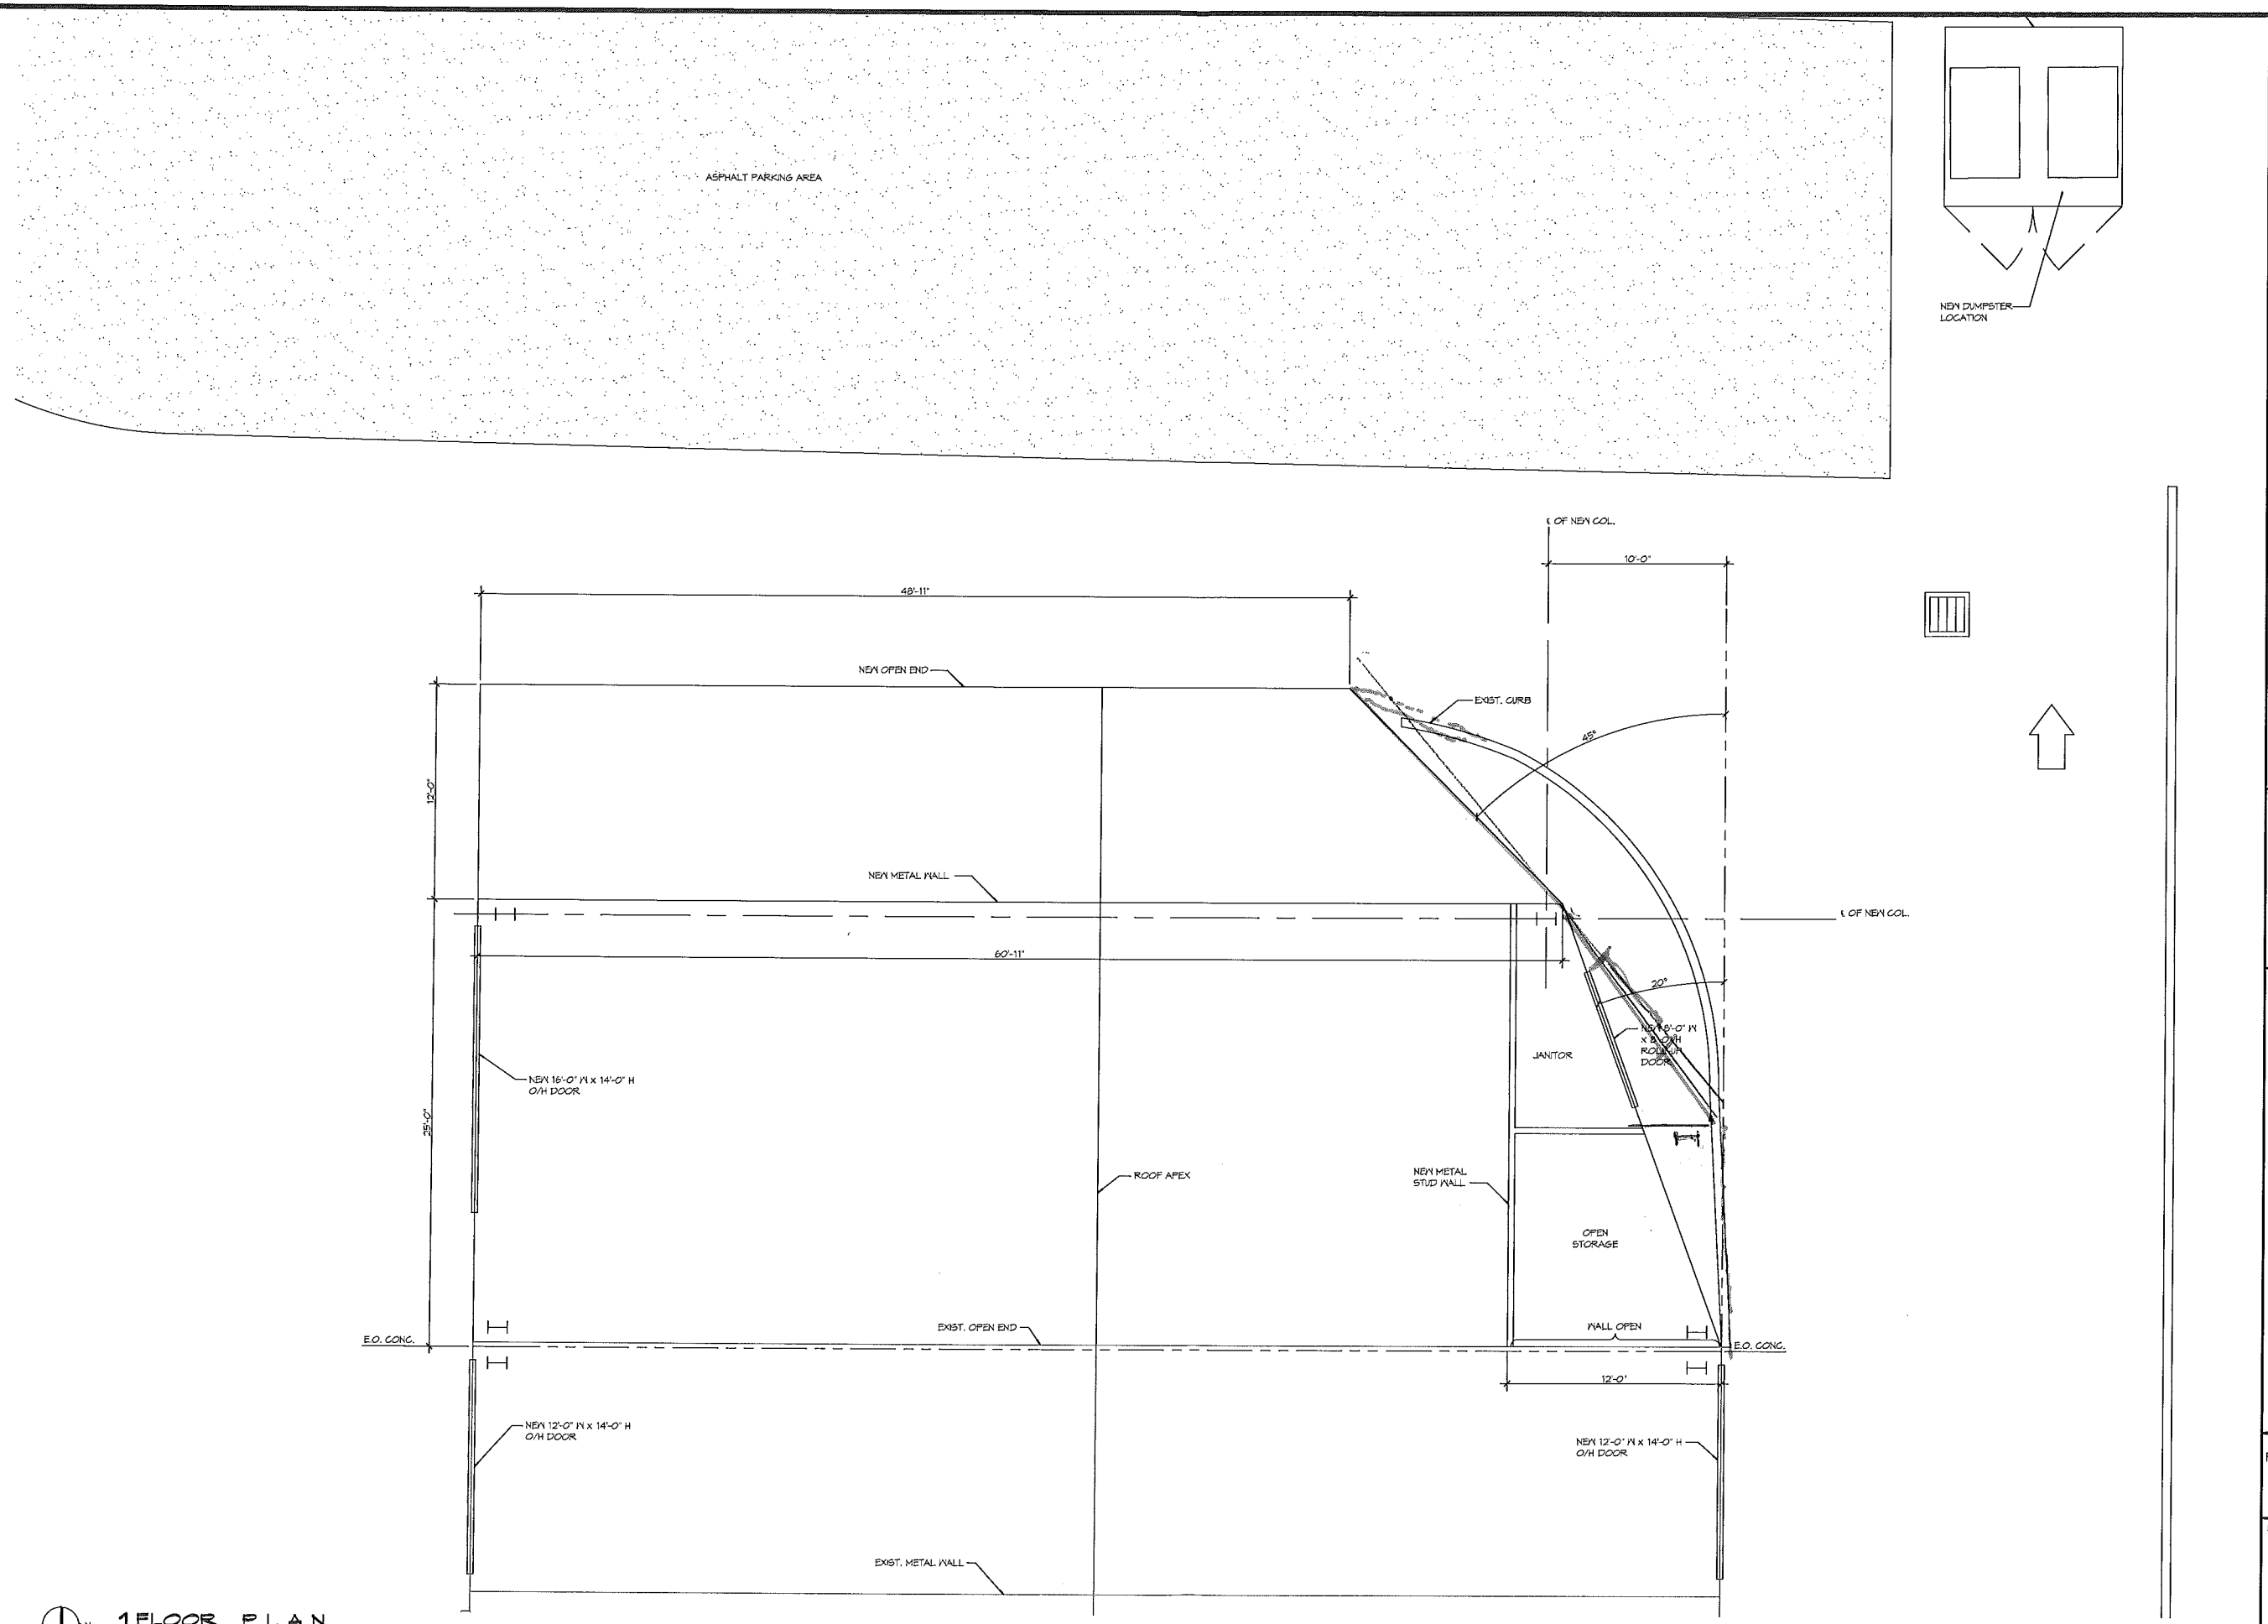

1 FLOOR PLAN
SCALE: 1/4" = 1'-0"

DAMMON ENGINEERING, INC.
LOUISIANA & MISSISSIPPI

Chief Engineer: Brian Mistich, PE
554 Old Spanish Trail
Slidell, LA 70458
www.dammonengineering.com
info@dammonengineering.com
PH: 985.649.5832 F: 985.641.5950

REVISIONS

#	DESCRIPTION	DATE

SEAL:

BUILDING ADDITION FOR
HOTARD BUS GROUP

56396 FRANK PICHON RD.
SLIDELL, LA 70458

JOB No: 22177 DATE: 3/2/2016
DRAWN BY: WHM CHECKED BY: CKD

SHEET TITLE:
FLOOR PLAN

DRAWING NUMBER:
A101

SHEET No: 5 of #