


Elect Service

Hose Bib

Hose Bib  
3' 7" Door

All Ret

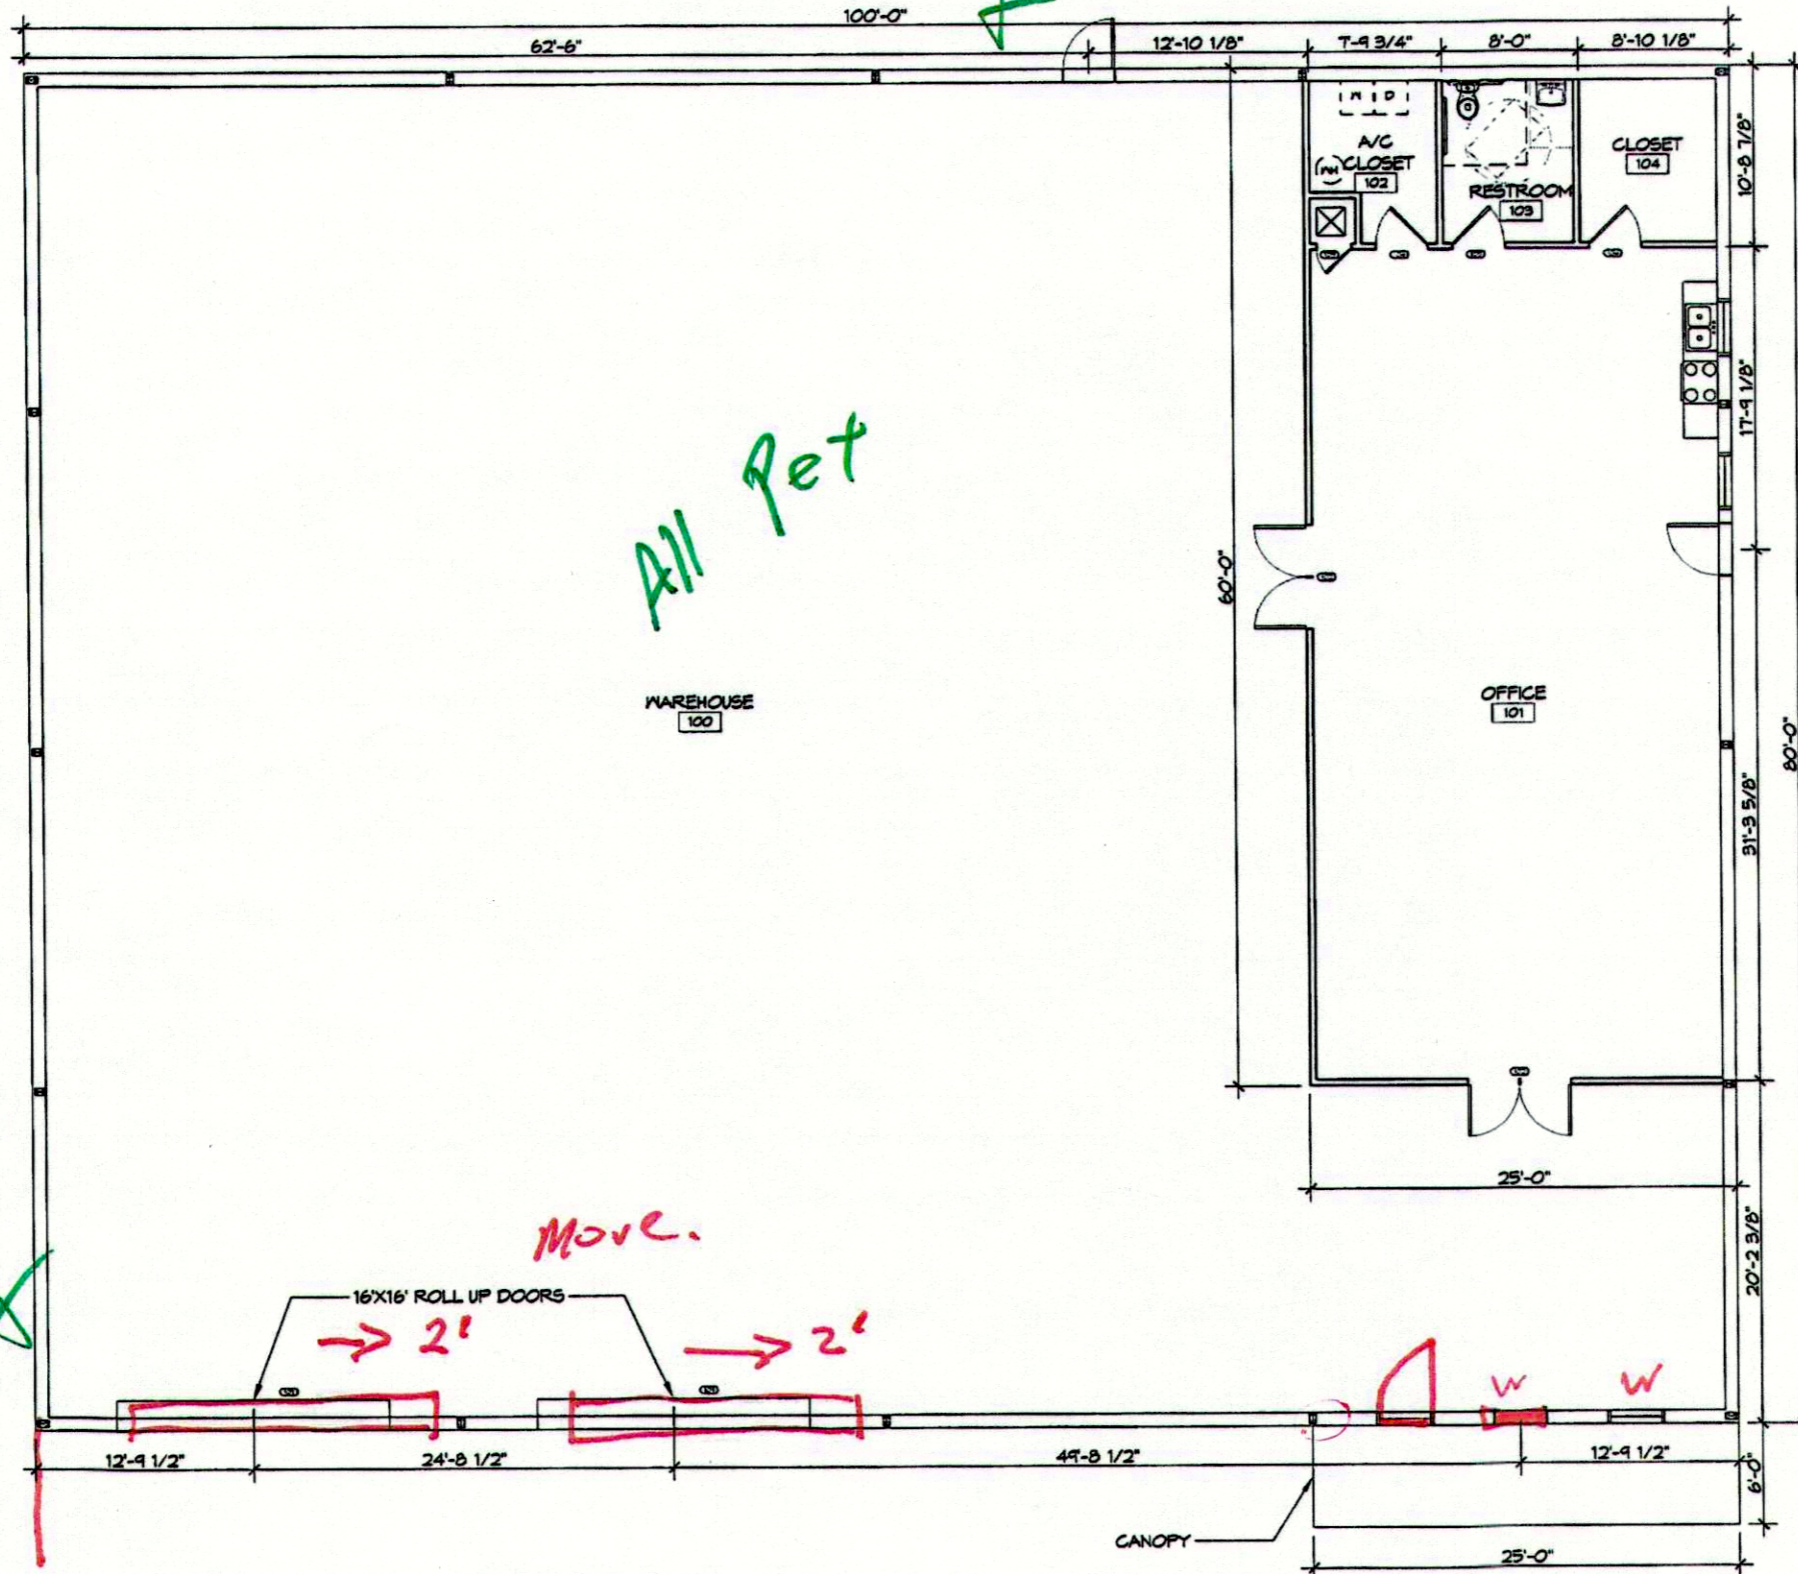

Move.

→ 2'

→ 2'

split faced cmu  
to bottom of Awning.