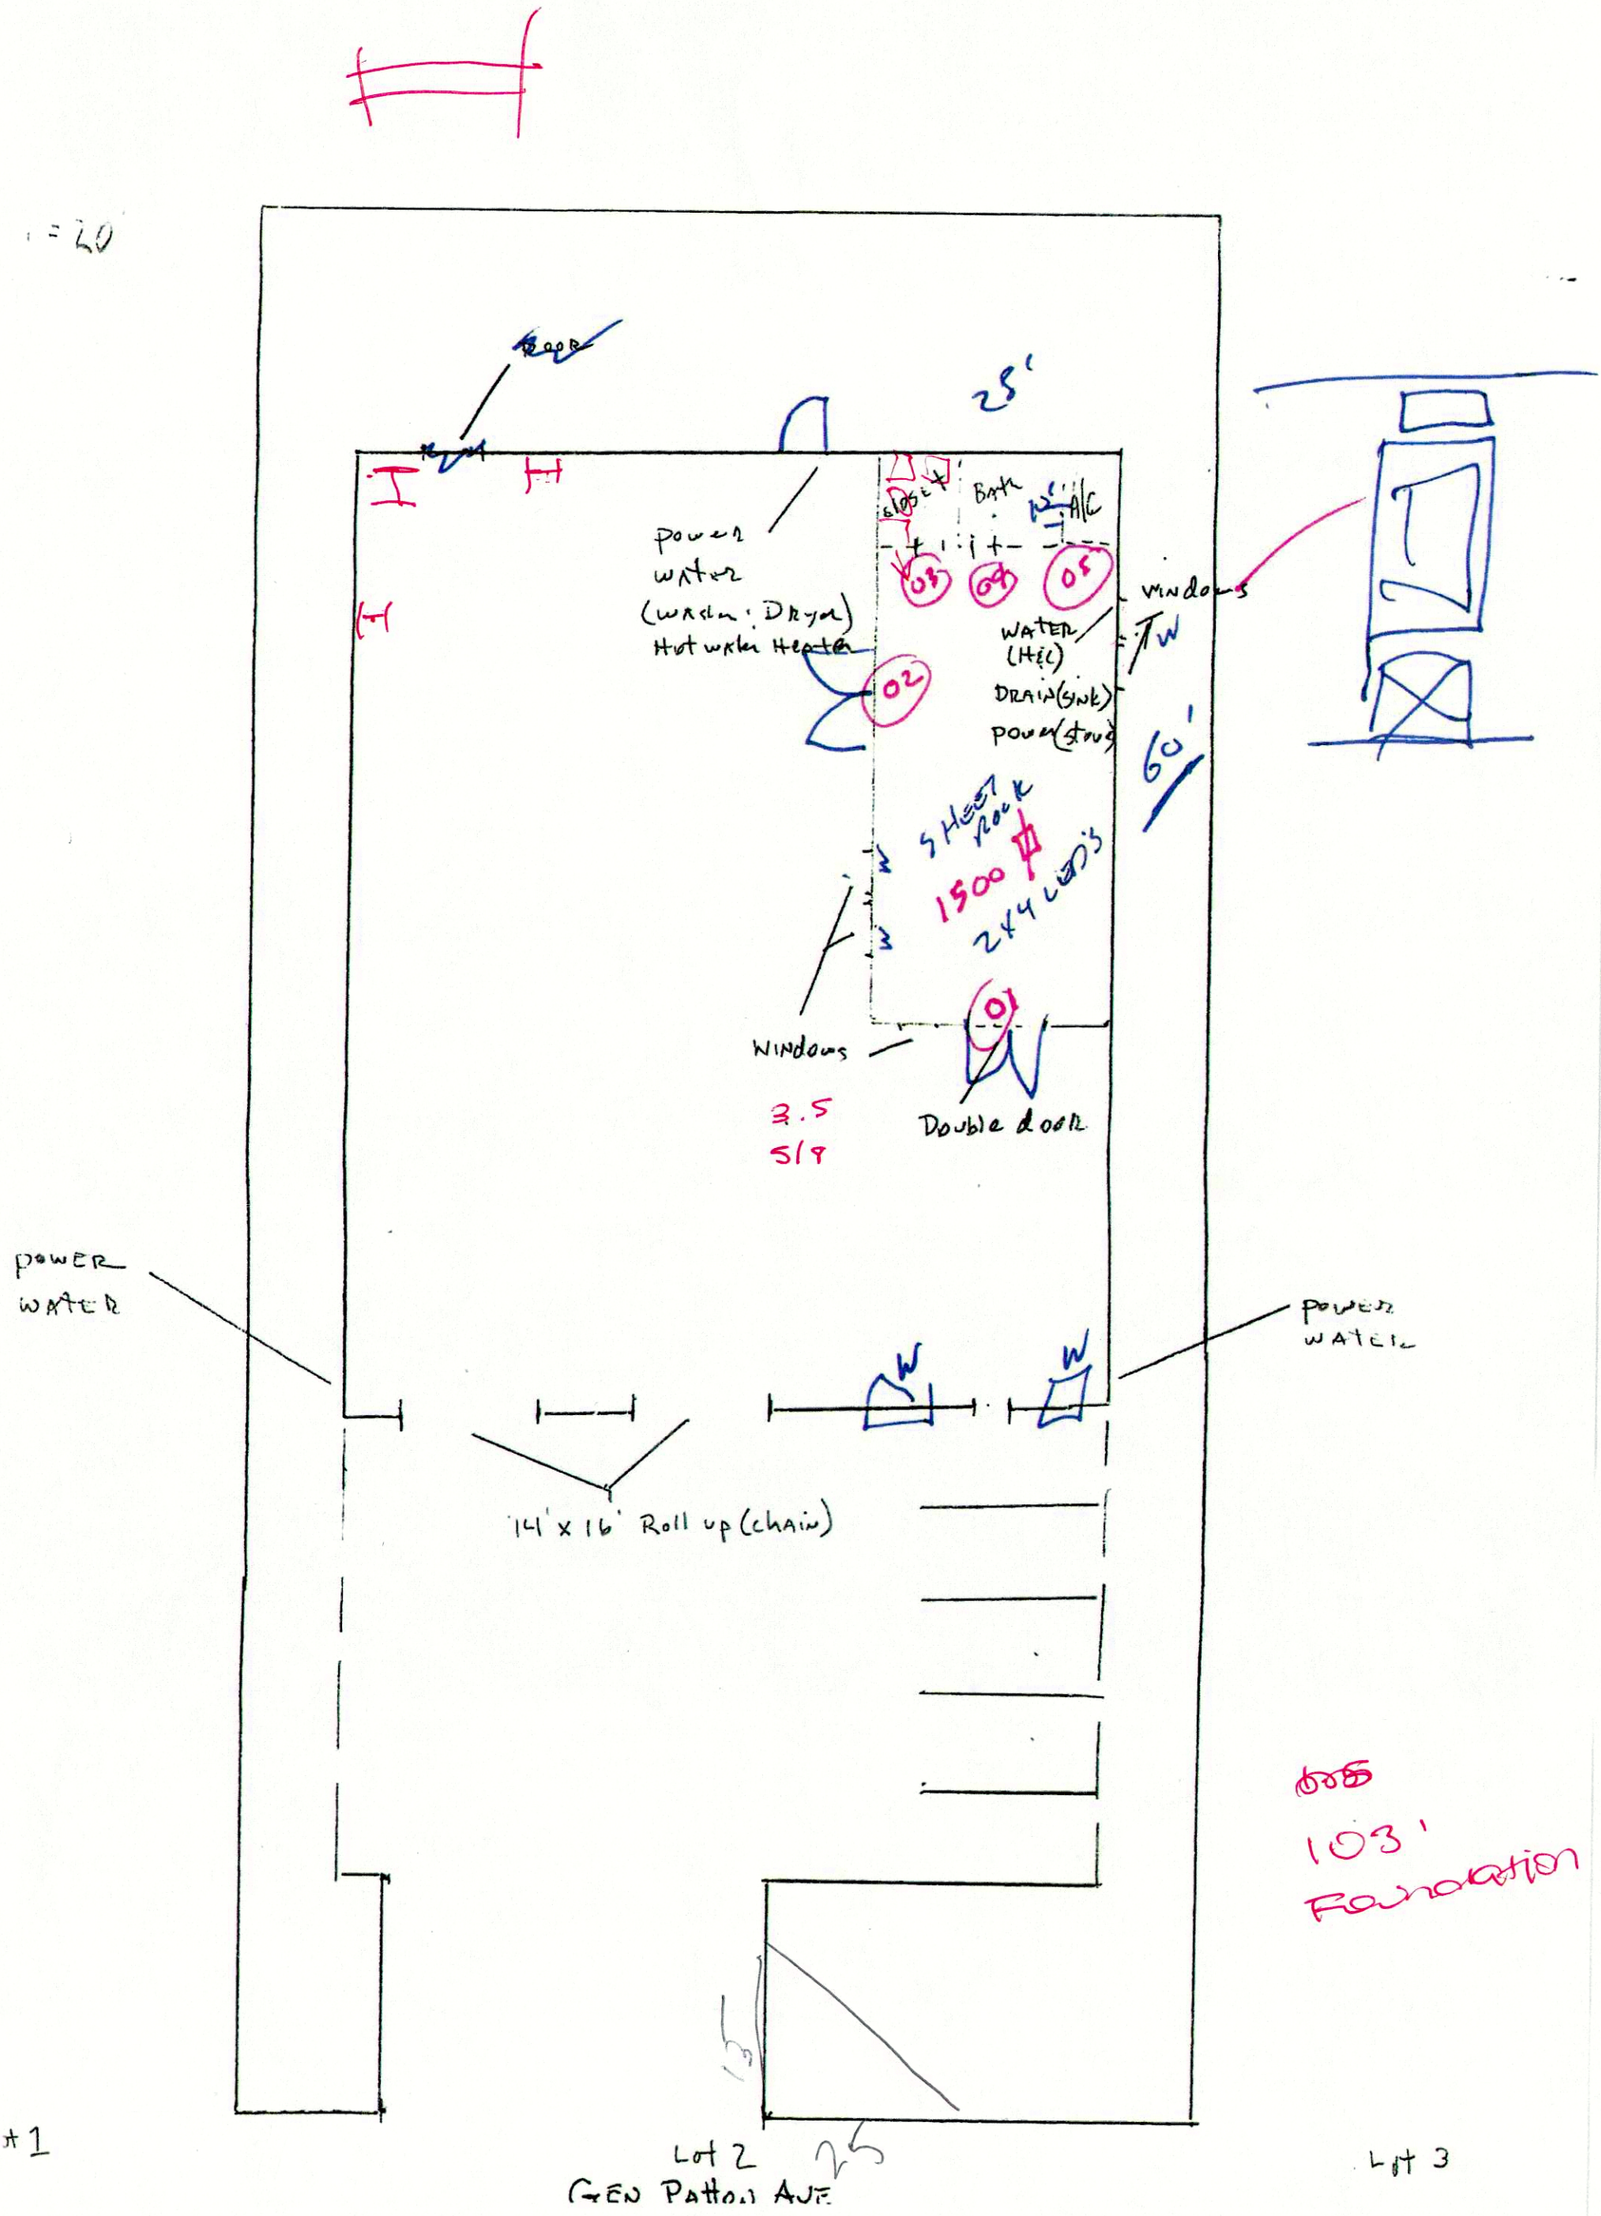
25'
Closet
Bath
A/C
power
water
(washer · Dryer)
Hot water Heater
03
04
05
windows
WATER
(H&C)
DRAIN(sink)
power(stove)
60'
Sheet Rock
1500
2x4 studs
02
01
windows
3.5
5/8
Double door
power
water
power
water
14' x 16' Roll up (chain)
103'
Foundation
#1
Lot 2
Gen Patton Ave
Lot 3