


BLOCK WALL

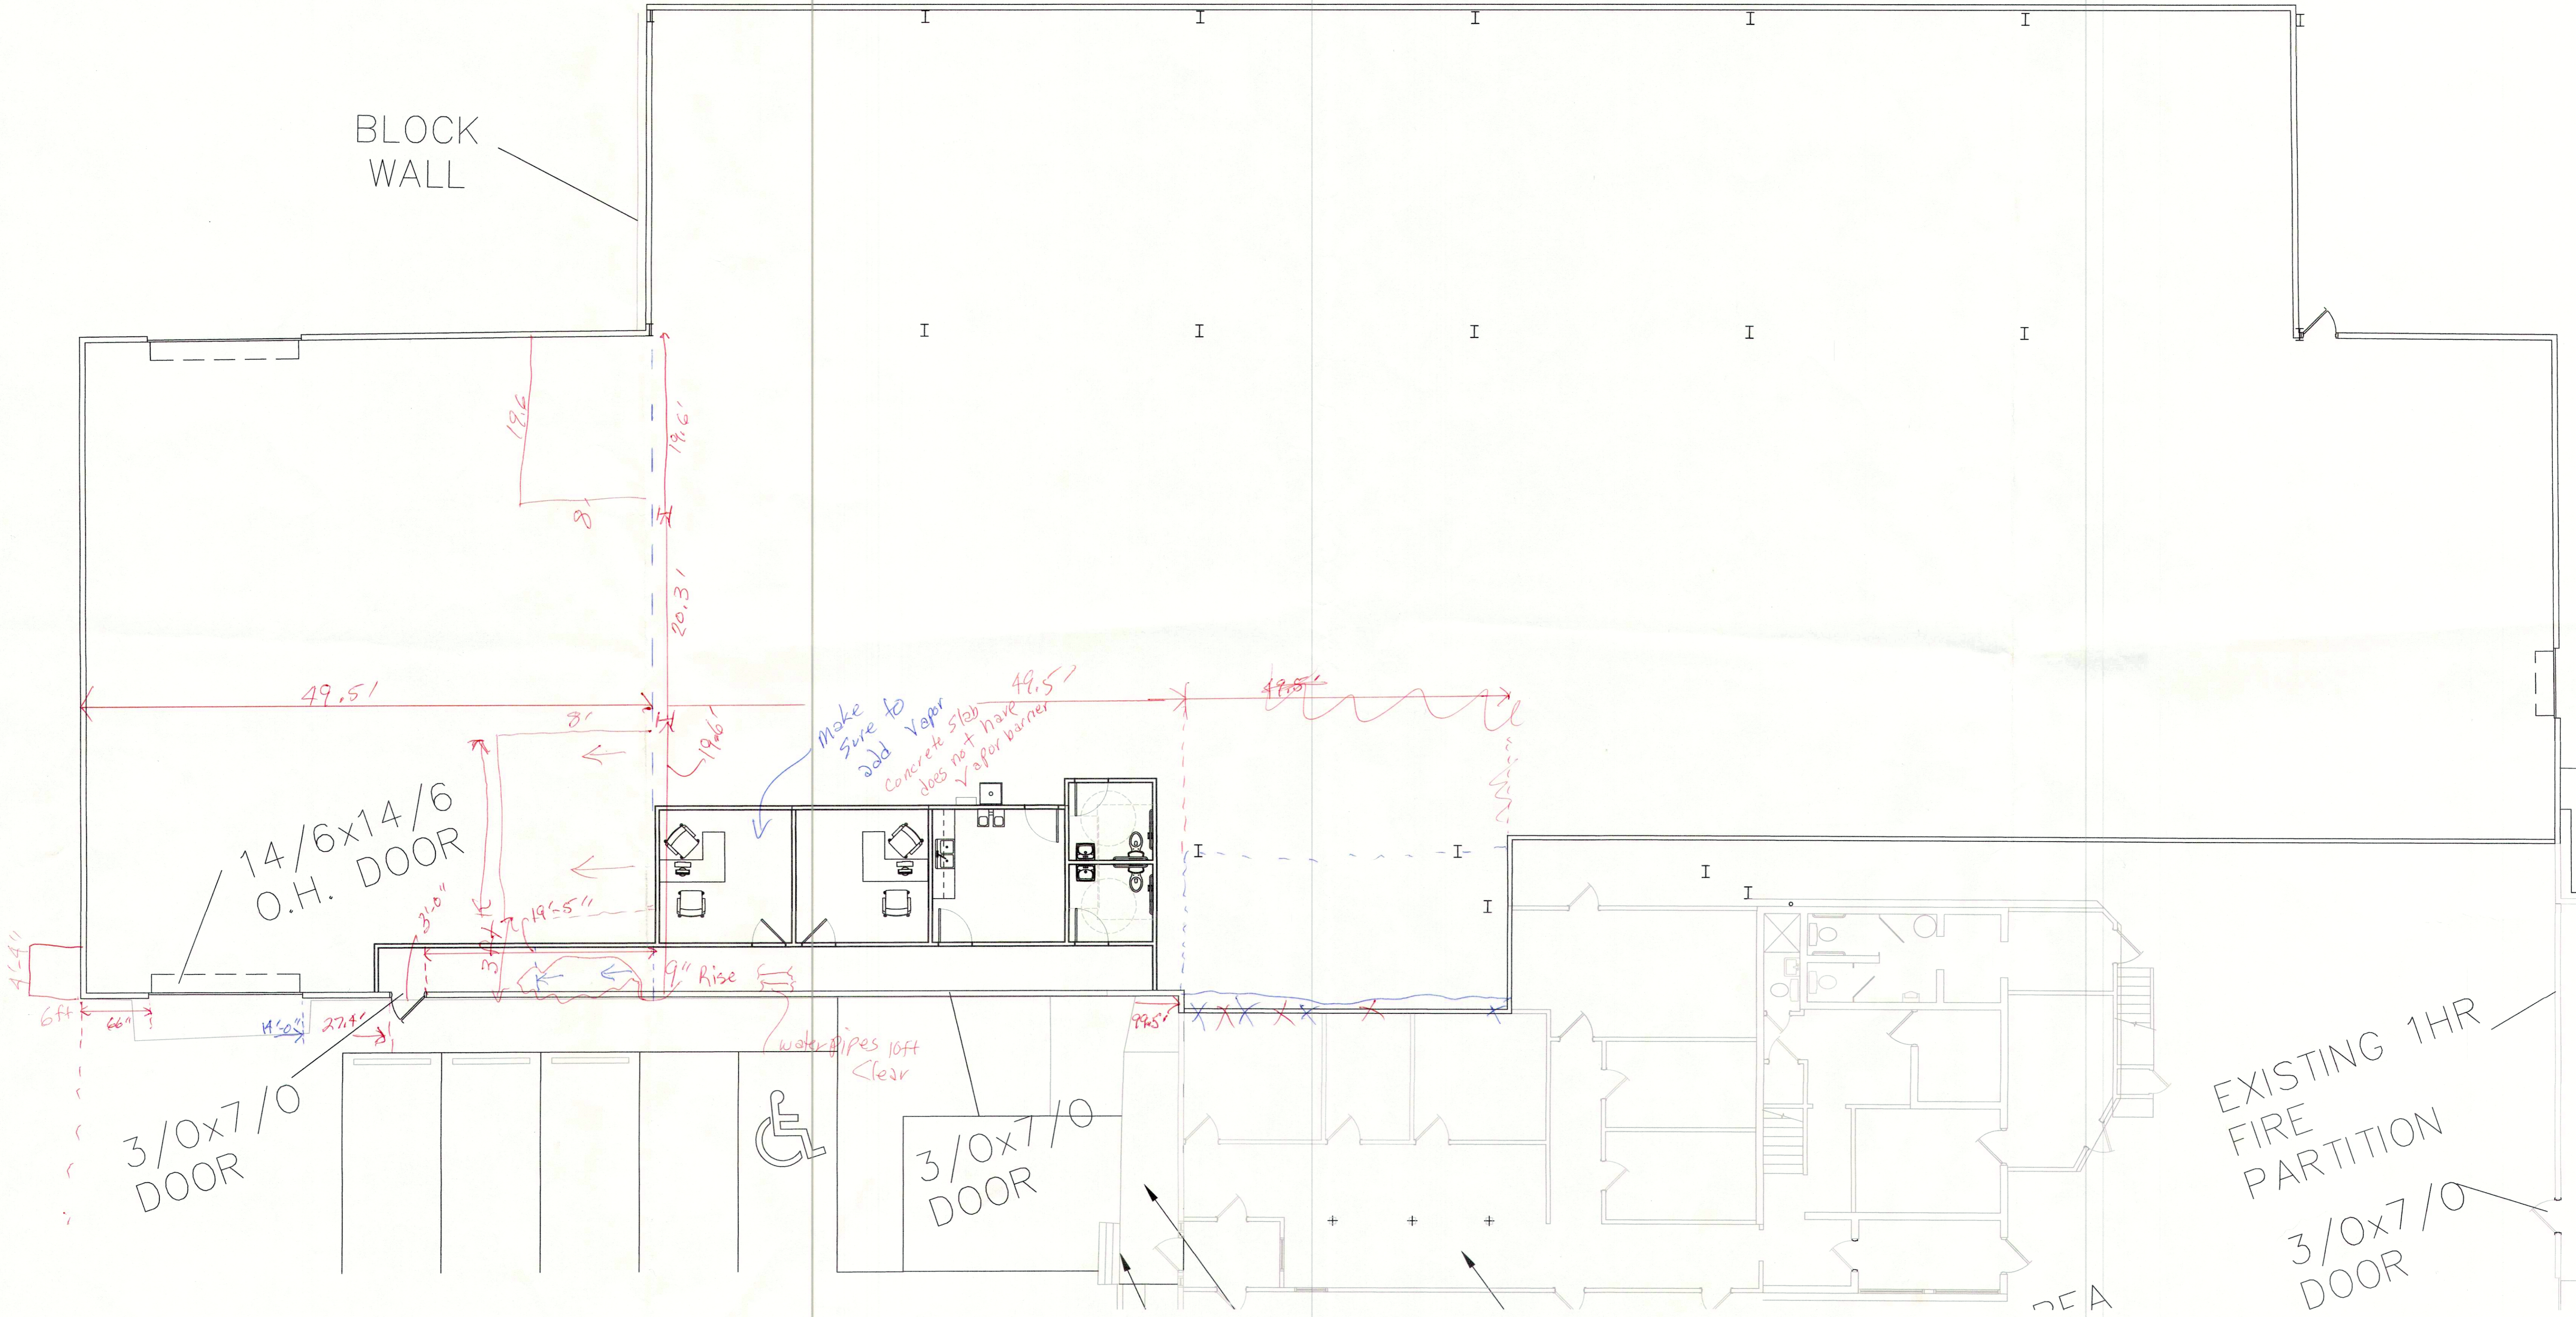

Make sure to add Vapor Concrete Slab does not have vapor barrier

14/6x14/6 O.H. DOOR

3/0x7/0 DOOR

3/0x7/0 DOOR

EXISTING 1HR FIRE PARTITION
3/0x7/0 DOOR



water pipes 10ft clear

9" Rise

4.4'

6ft

66"

14.5'

27.4'

31.6"

37.7"

19'-5"

8'

19.61'

18.6'

81'

20.31'

19.61'

49.51'

49.51'

