

432238  
 REVIEWED FOR  
 STATE FIRE MARSHAL  
 AS PER REVIEW LETTER  
 BY WILLIAM D. JONES, ARCHITECT, CBO  
*William D. Jones*

**DAMMON**  
 ENGINEERING, INC.  
*Architects & Engineers*


dammonengineering.com  
 dammoneng@jpsouth.net  
 PHONE: 985-649-5952  
 FAX: 985-641-5959

CHIEF ENGINEER: EMMETT DAMMON, P.E.  
 CHIEF ARCHITECT: KEVIN KINCHEN  
 554 OLD SPANISH TRAIL  
 SUDBELL, LA 70458

**BULK SYSTEMS' NEW OFFICE/WAREHOUSE BUILDING**  
 1226 FREMAUX AVENUE  
 SUDBELL, LOUISIANA 70458

JOB No: 2173 DATE: 04-23-2013  
 DRAWN BY: JTL CHECKED BY:

#	DESCRIPTION	DATE

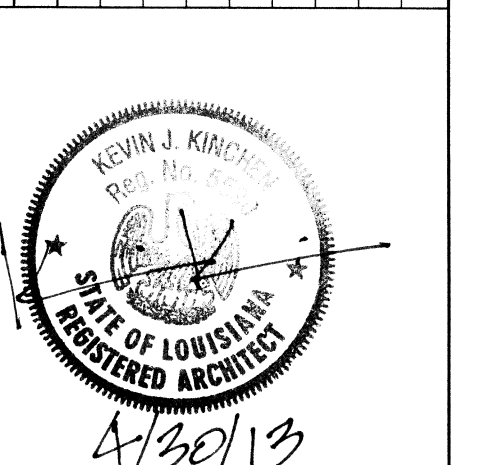

EXTERIOR ELEVATIONS

SHEET No: 11 OF 20  
**A3**