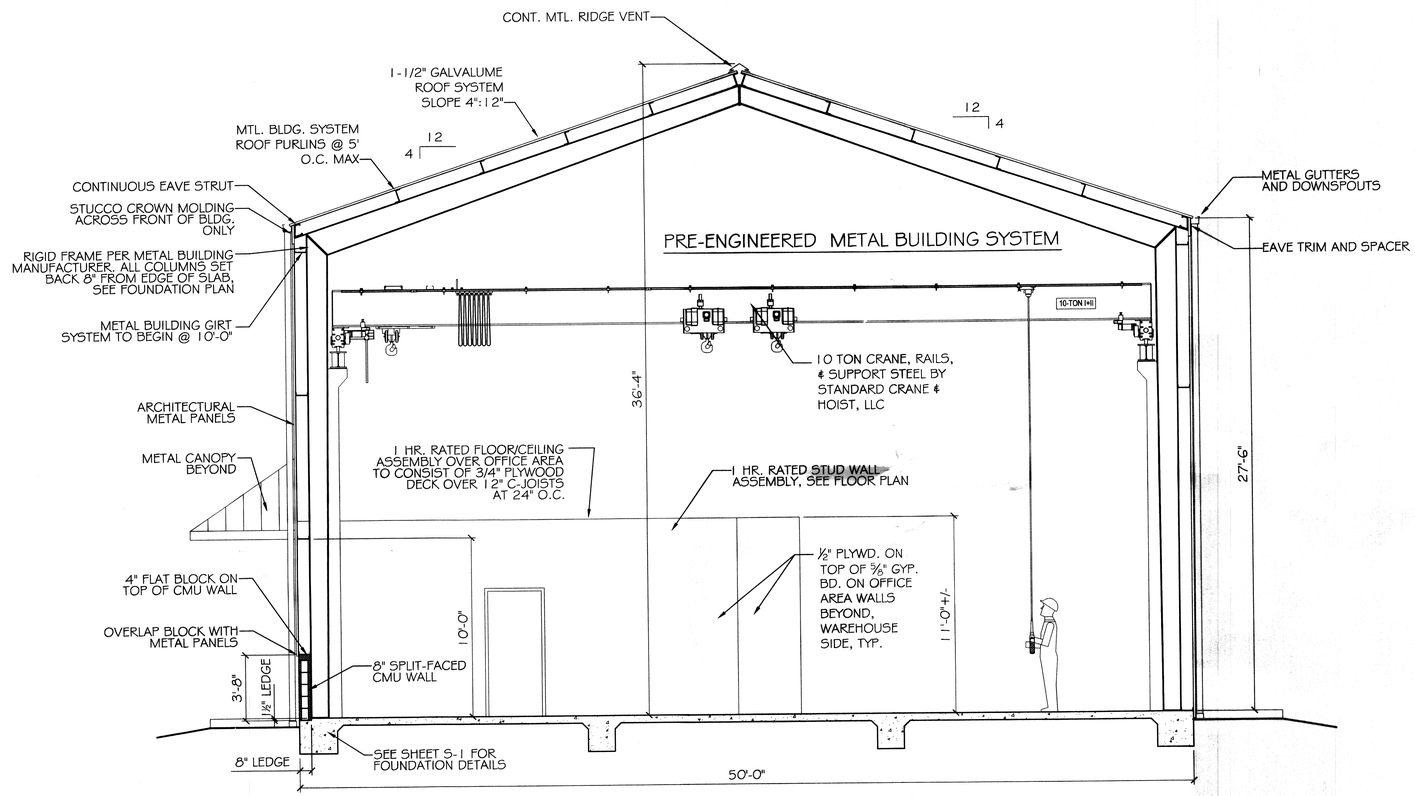

CROSS SECTION

SCALE: 1/4"=1'-0"

432238
REVIEWED FOR
STATE FIRE MARSHAL
AS PER REVIEW LETTER
BY: WILLIAM D. JONES, ARCHITECT, CBO

DAMMON ENGINEERING INC
Architects & Engineers

CHIEF ENGINEER: EMMETT DAMMON, P.E.
CHIEF ARCHITECT: KEVIN KINCHEN
554 OLD SPANISH TRAIL
SLIDELL, LA 70458

BULK SYSTEMS NEW OFFICE/WAREHOUSE BUILDING

1226 FREMEAUX AVENUE
SLIDELL, LOUISIANA 70458

04-18-2013
2173
JTL

The above drawings and specifications, designs and arrangements shown on and indicated thereon are and shall remain the property of Dammon Engineering, and no part thereof shall be used for any purpose except as made in connection with the work or projects for which they are prepared and delivered, which, upon completion of the work or projects for which they are prepared and delivered, shall be returned upon request. The reproduction of these drawings or specifications for unauthorized use is prohibited.

#	DESCRIPTION	DATE

REVISIONS

KEVIN J. KINCHEN
Reg. No. 32238
STATE OF LOUISIANA
REGISTERED ARCHITECT

4/30/13

BUILDING SECTION AND DETAILS

SHEET No: 13 OF 20

A5