| REVISIONS | | | | | |
|---|---|---|---|---|---|
| REV | DESCRIPTION | DATE | BY | CHK'D | APPRV'D |
| 0 | PER SURVEY (BFM CORP. B-394602004) | 12/21/05 | MC | DH | |

| | | |
|---|---|---|
| (A) | MAIN FILL BUILDING | .... 10,709 SQ. FT. |
| (B) | HYDROTEST | ..... 6,322 SQ. FT. |
| (C) | OFFICES | ..... 310 SQ. FT. |
| (D) | MAINTENANCE BLDG. | ..... 4,080 SQ. FT. |
| (E) | STORAGE BLDG. | ..... 118 SQ. FT. |
| (F) | ELECTRICAL BLDG. | ..... 252 SQ. FT. |
| | TOTAL | 21,791 SQ. FT. |

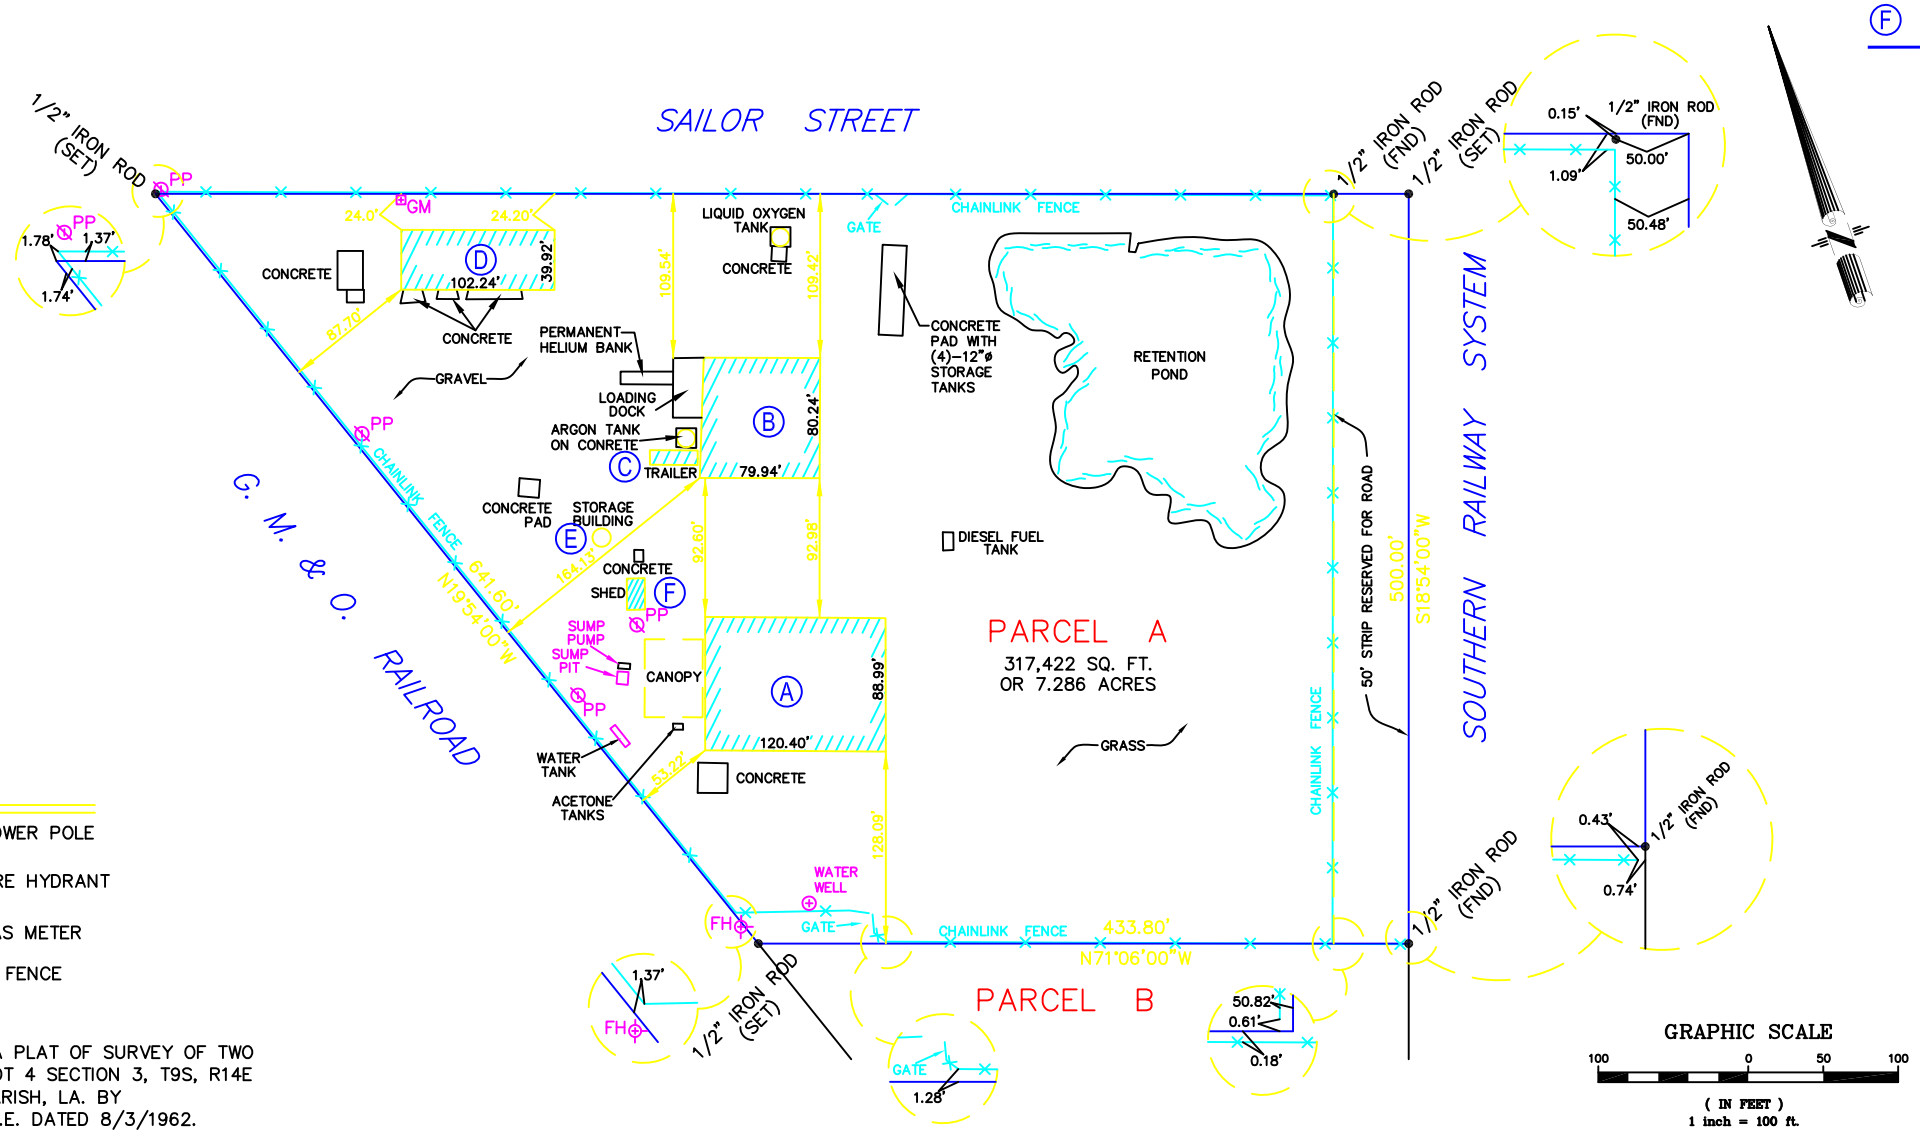


## LEGEND

| | |
|---|---|
| PP | POWER POLE |
| FH | FIRE HYDRANT |
| GM | GAS METER |
| X X X | FENCE |

NOTE:
REFERENCE SURVEY IS A PLAT OF SURVEY OF TWO PARCELS OF LAND IN LOT 4 SECTION 3, T9S, R14E 9THWD ST. TAMMANY PARISH, LA. BY JOHN H. SOLLBERGER, C.E. DATED 8/3/1962.

**WESTERN**
INTERNATIONAL GAS & CYLINDERS, INC.

BUILDING LAYOUT

SLIDELL, LA

| | | | | |
|---|---|---|---|---|
| UNLESS OTHERWISE SPECIFIED ALL DIMENSIONS ARE IN INCHES REMOVE ALL SHARP CORNERS WITH .03R MAX | TOLERANCE UNLESS OTHERWISE SPECIFIED | DRAWN BY MC 12/05 | DWG NO. | |
| THIS DRAWING IS THE PROPERTY OF WESTERN INTERNATIONAL GAS & CYLINDERS, INC. THE INFORMATION HEREIN SHALL NOT BE USED OR COPIED IN ANY MANNER WITHOUT THE WRITTEN PERMISSION OF WESTERN INTERNATIONAL GAS. | .XX ±.015 ANGLES ±1/2° | CHECKED BY DH 12/05 | BL-SL-001 | |
| | | APPROVED BY DH 12/05 | | |
| | .XXX ±.005 FRACTION ±1/16 | SIZE D | SCALE: NONE | SHEET 1 OF 1 REV 0 |

R:\Engineering\Slidell\Plan\BD\SQUARE FOOTAGE.dwg, 1/8/2018 10:57:27 AM, Adobe PDF