



Condenser 2 1/2 ton Heil
 R4A430GKB
 208/230 lph

Airhandler 2 1/2 ton Heil
 FEM4P3000AL
 208/230 lph

heat 10 kW EHK10AKN.
 208/230 lph

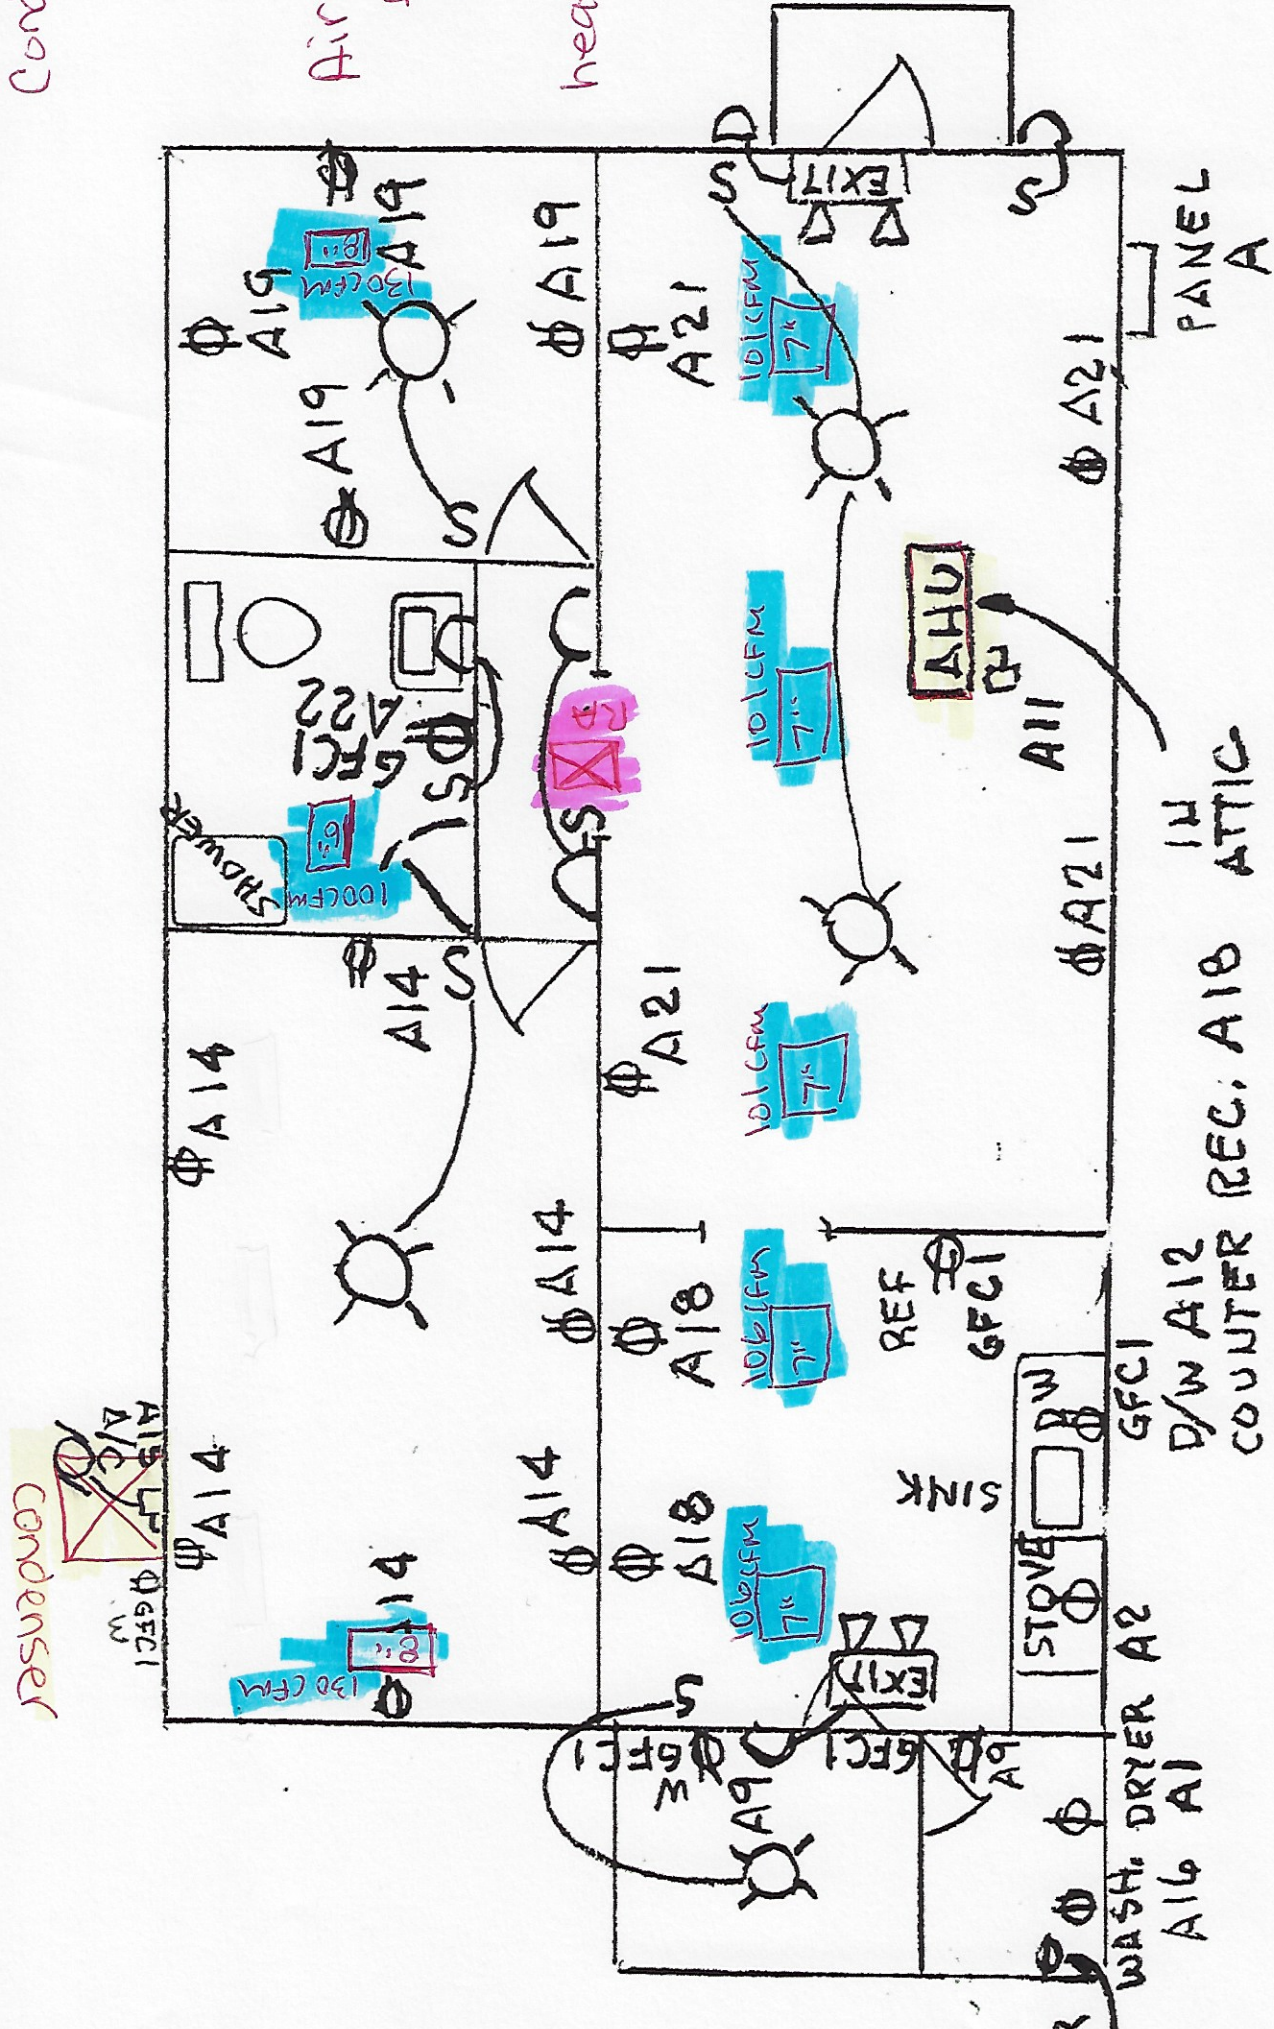

1312 CLEARVIEW PKW
 OFFICE CONVERSION

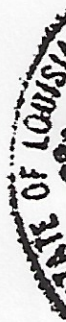

