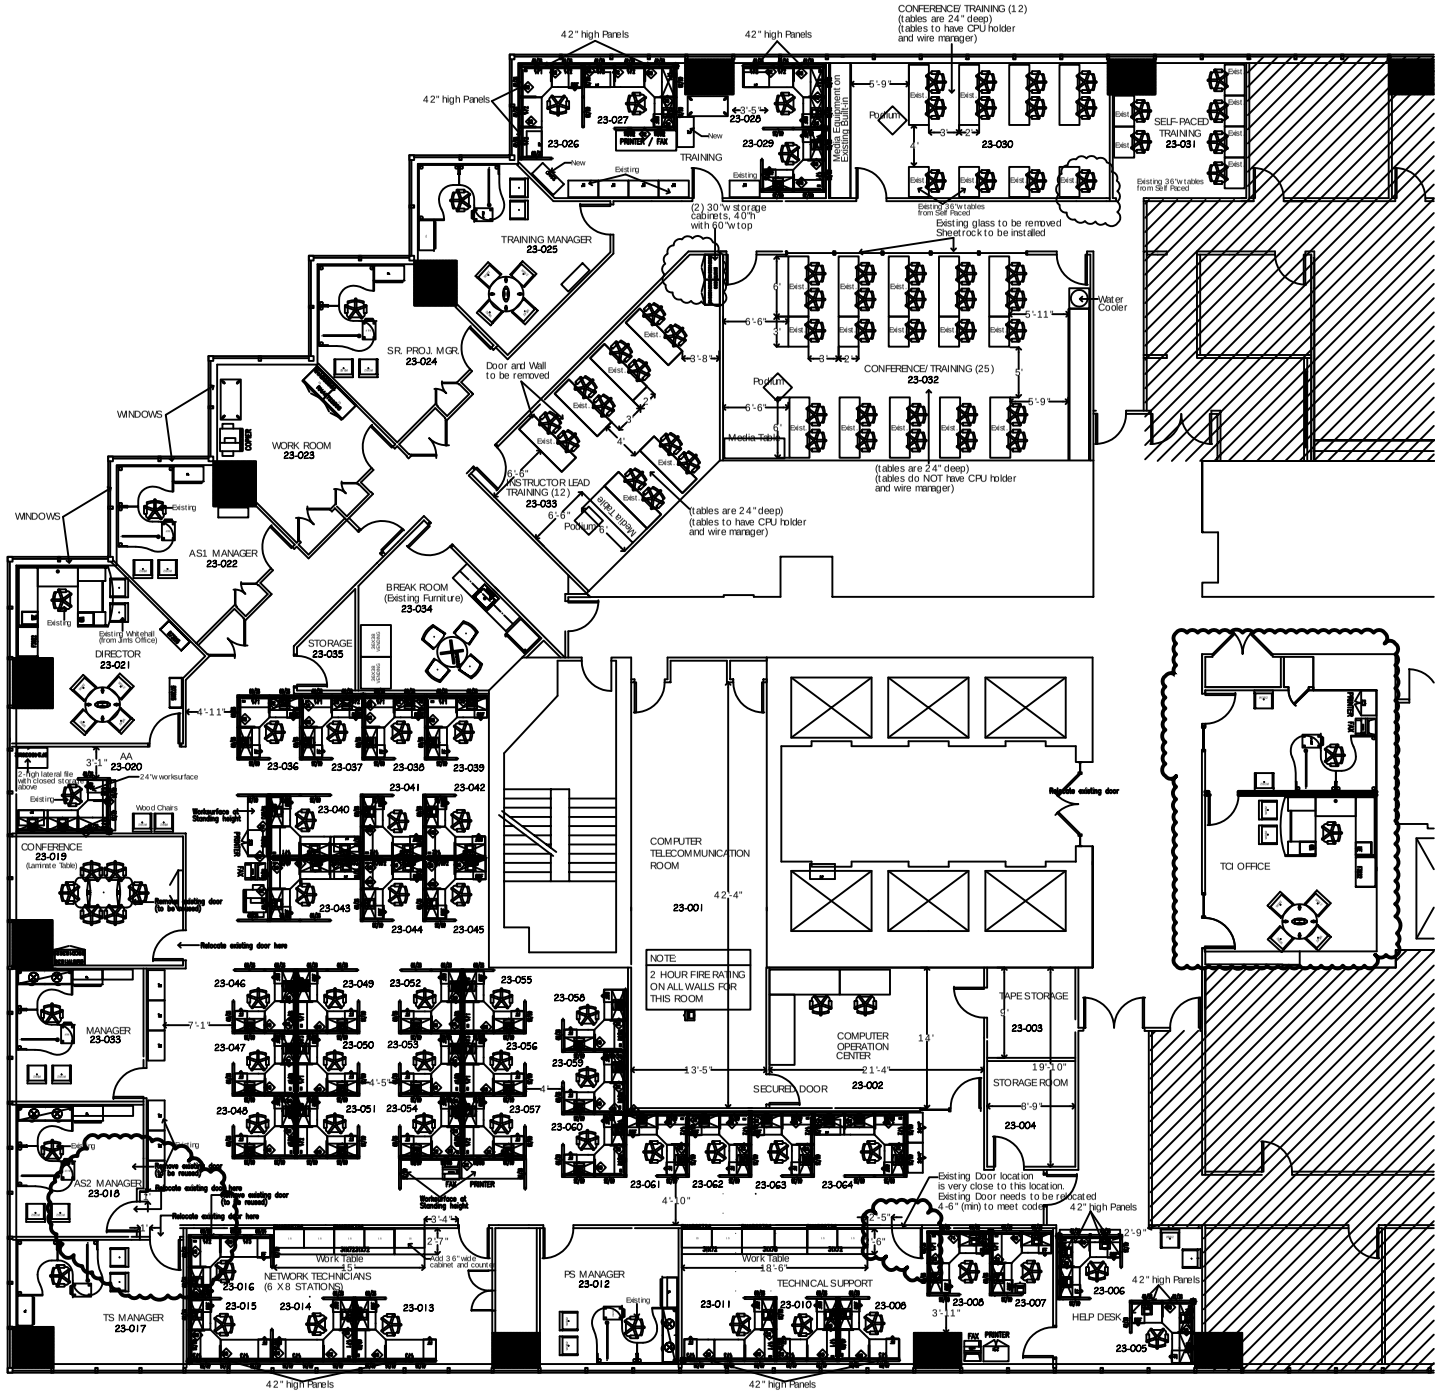

23RD FLOOR

20' 15' 10' 5' 0' 5'

TWENTY-THIRD FLOOR PLAN

Wall Legend	
Existing Wall	
New Construction	
Demo Wall	