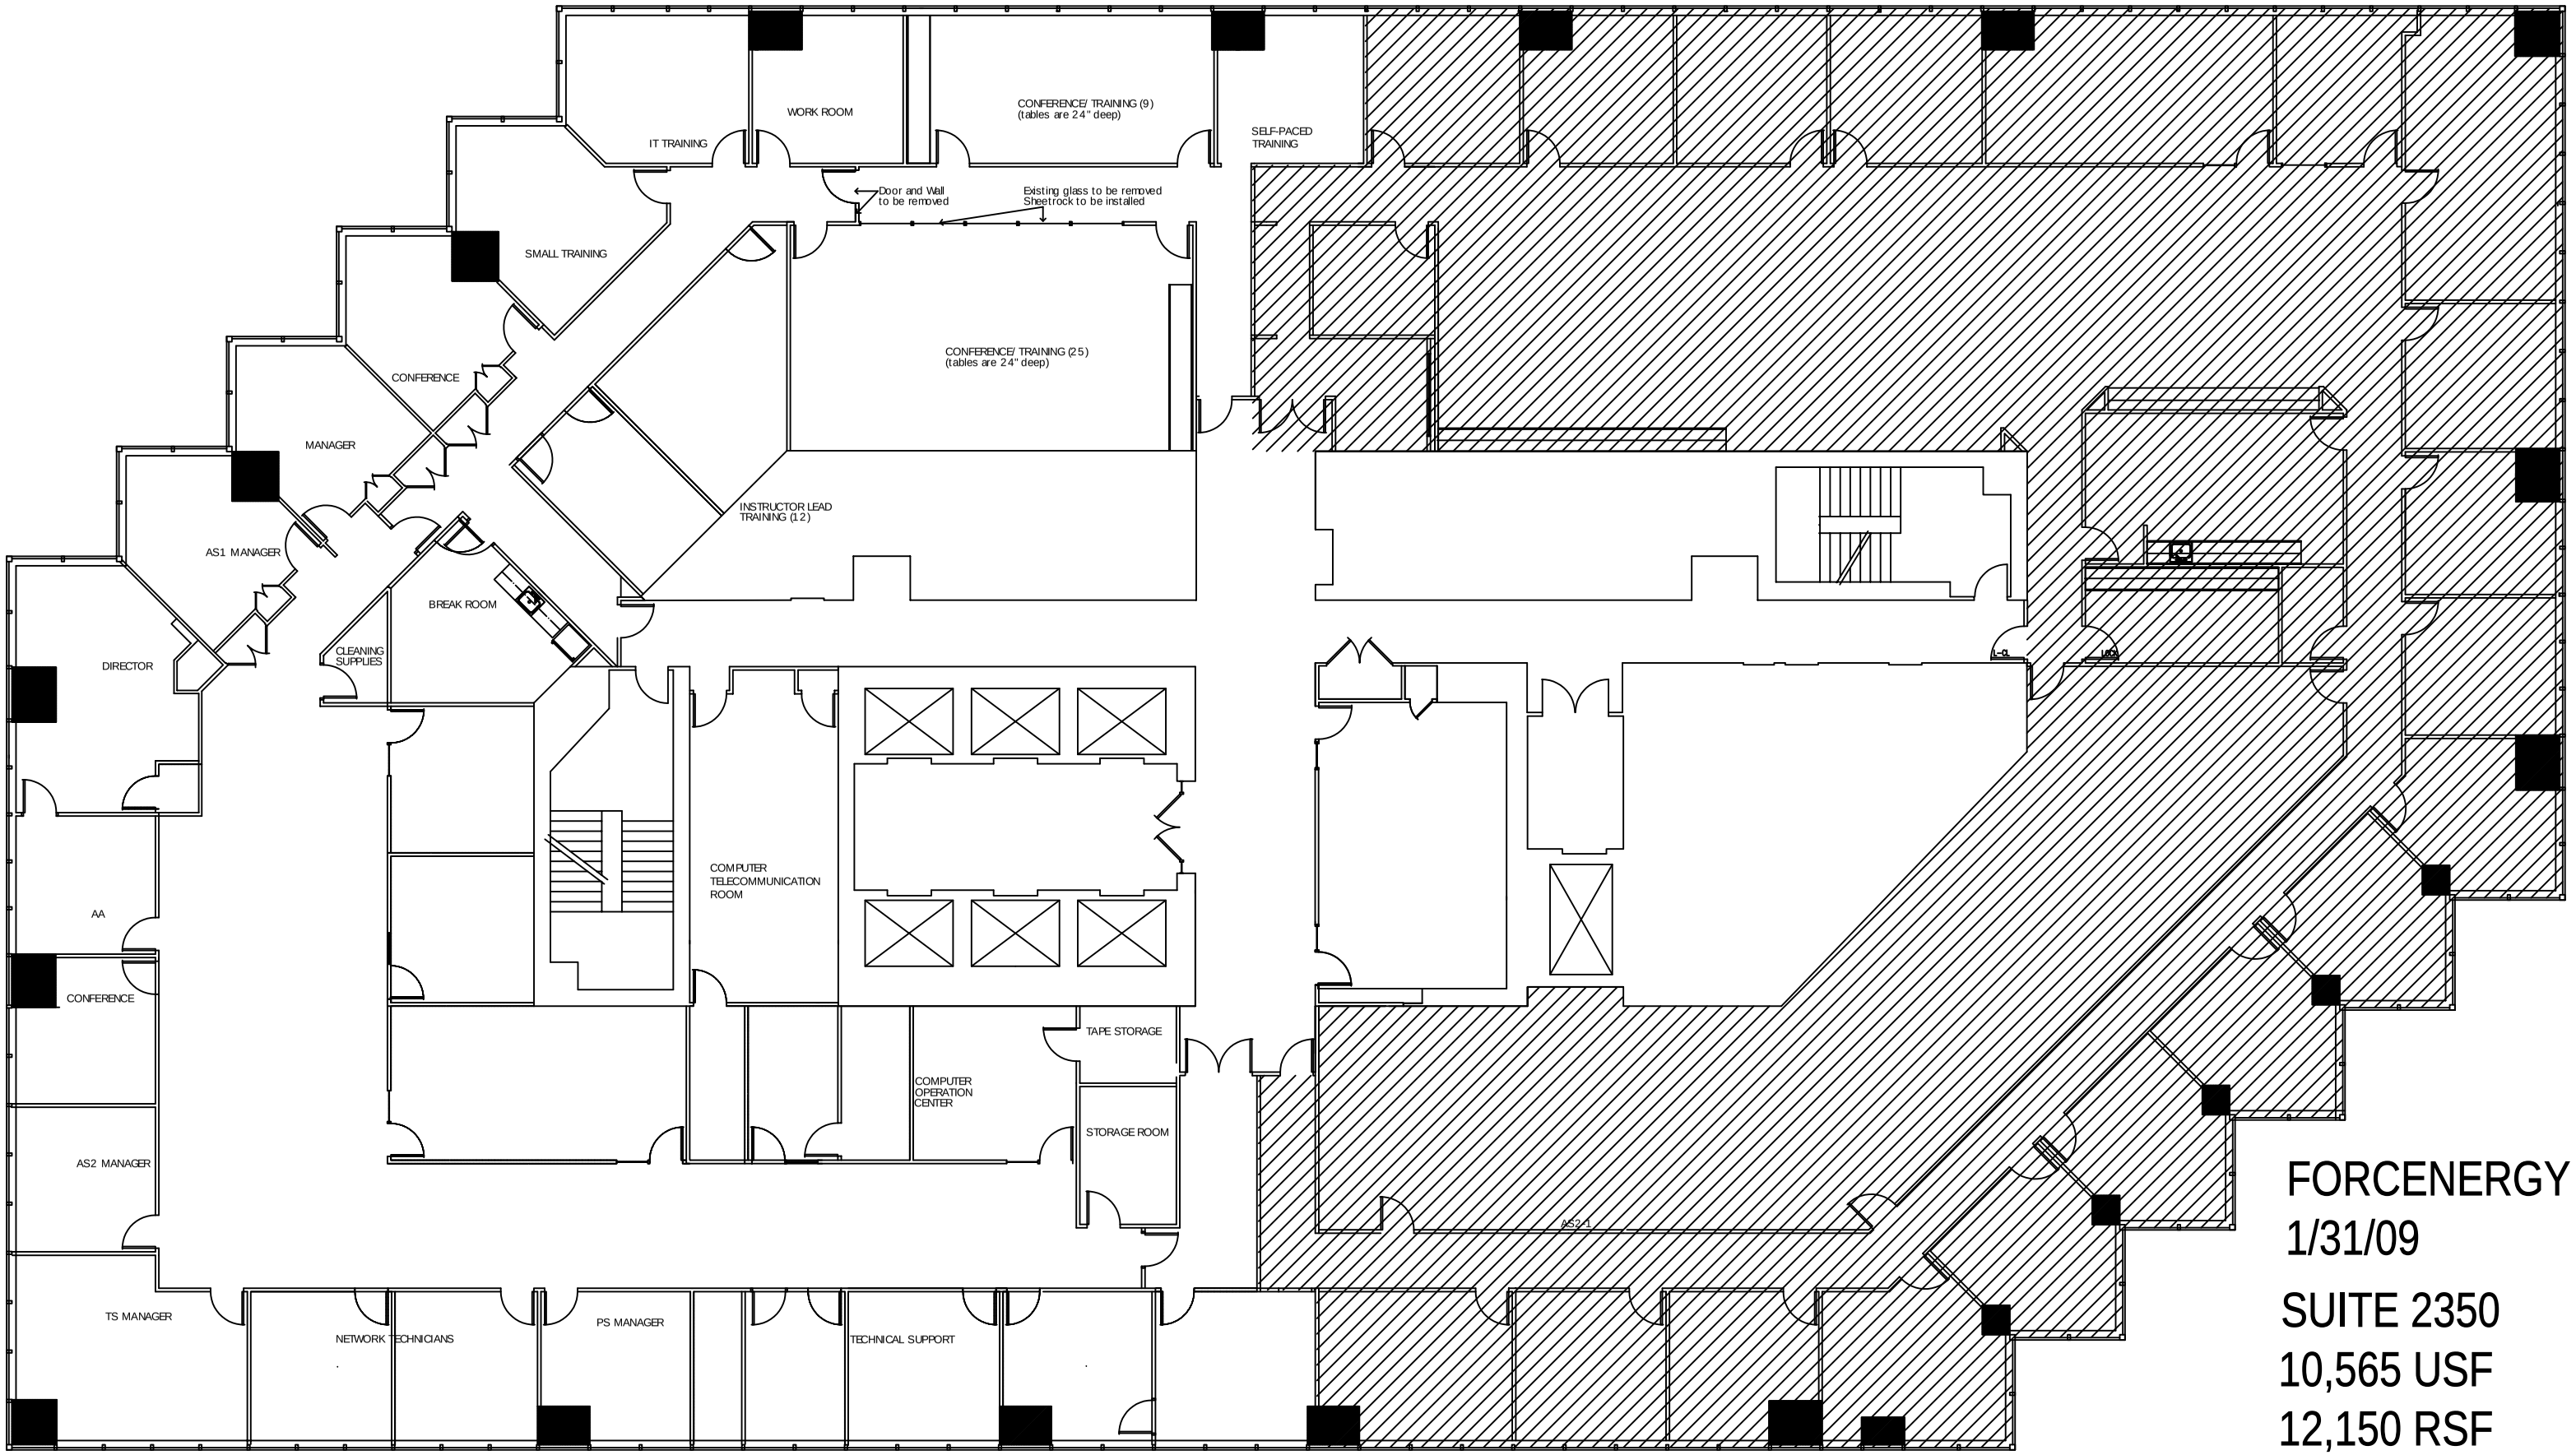

FORCENERGY
1/31/09

SUITE 2350
10,565 USF
12,150 RSF

Wall Legend	
Existing Wall	
New Construction	
Demo Wall	

23RD FLOOR

20' 15' 10' 5' 0' 5'

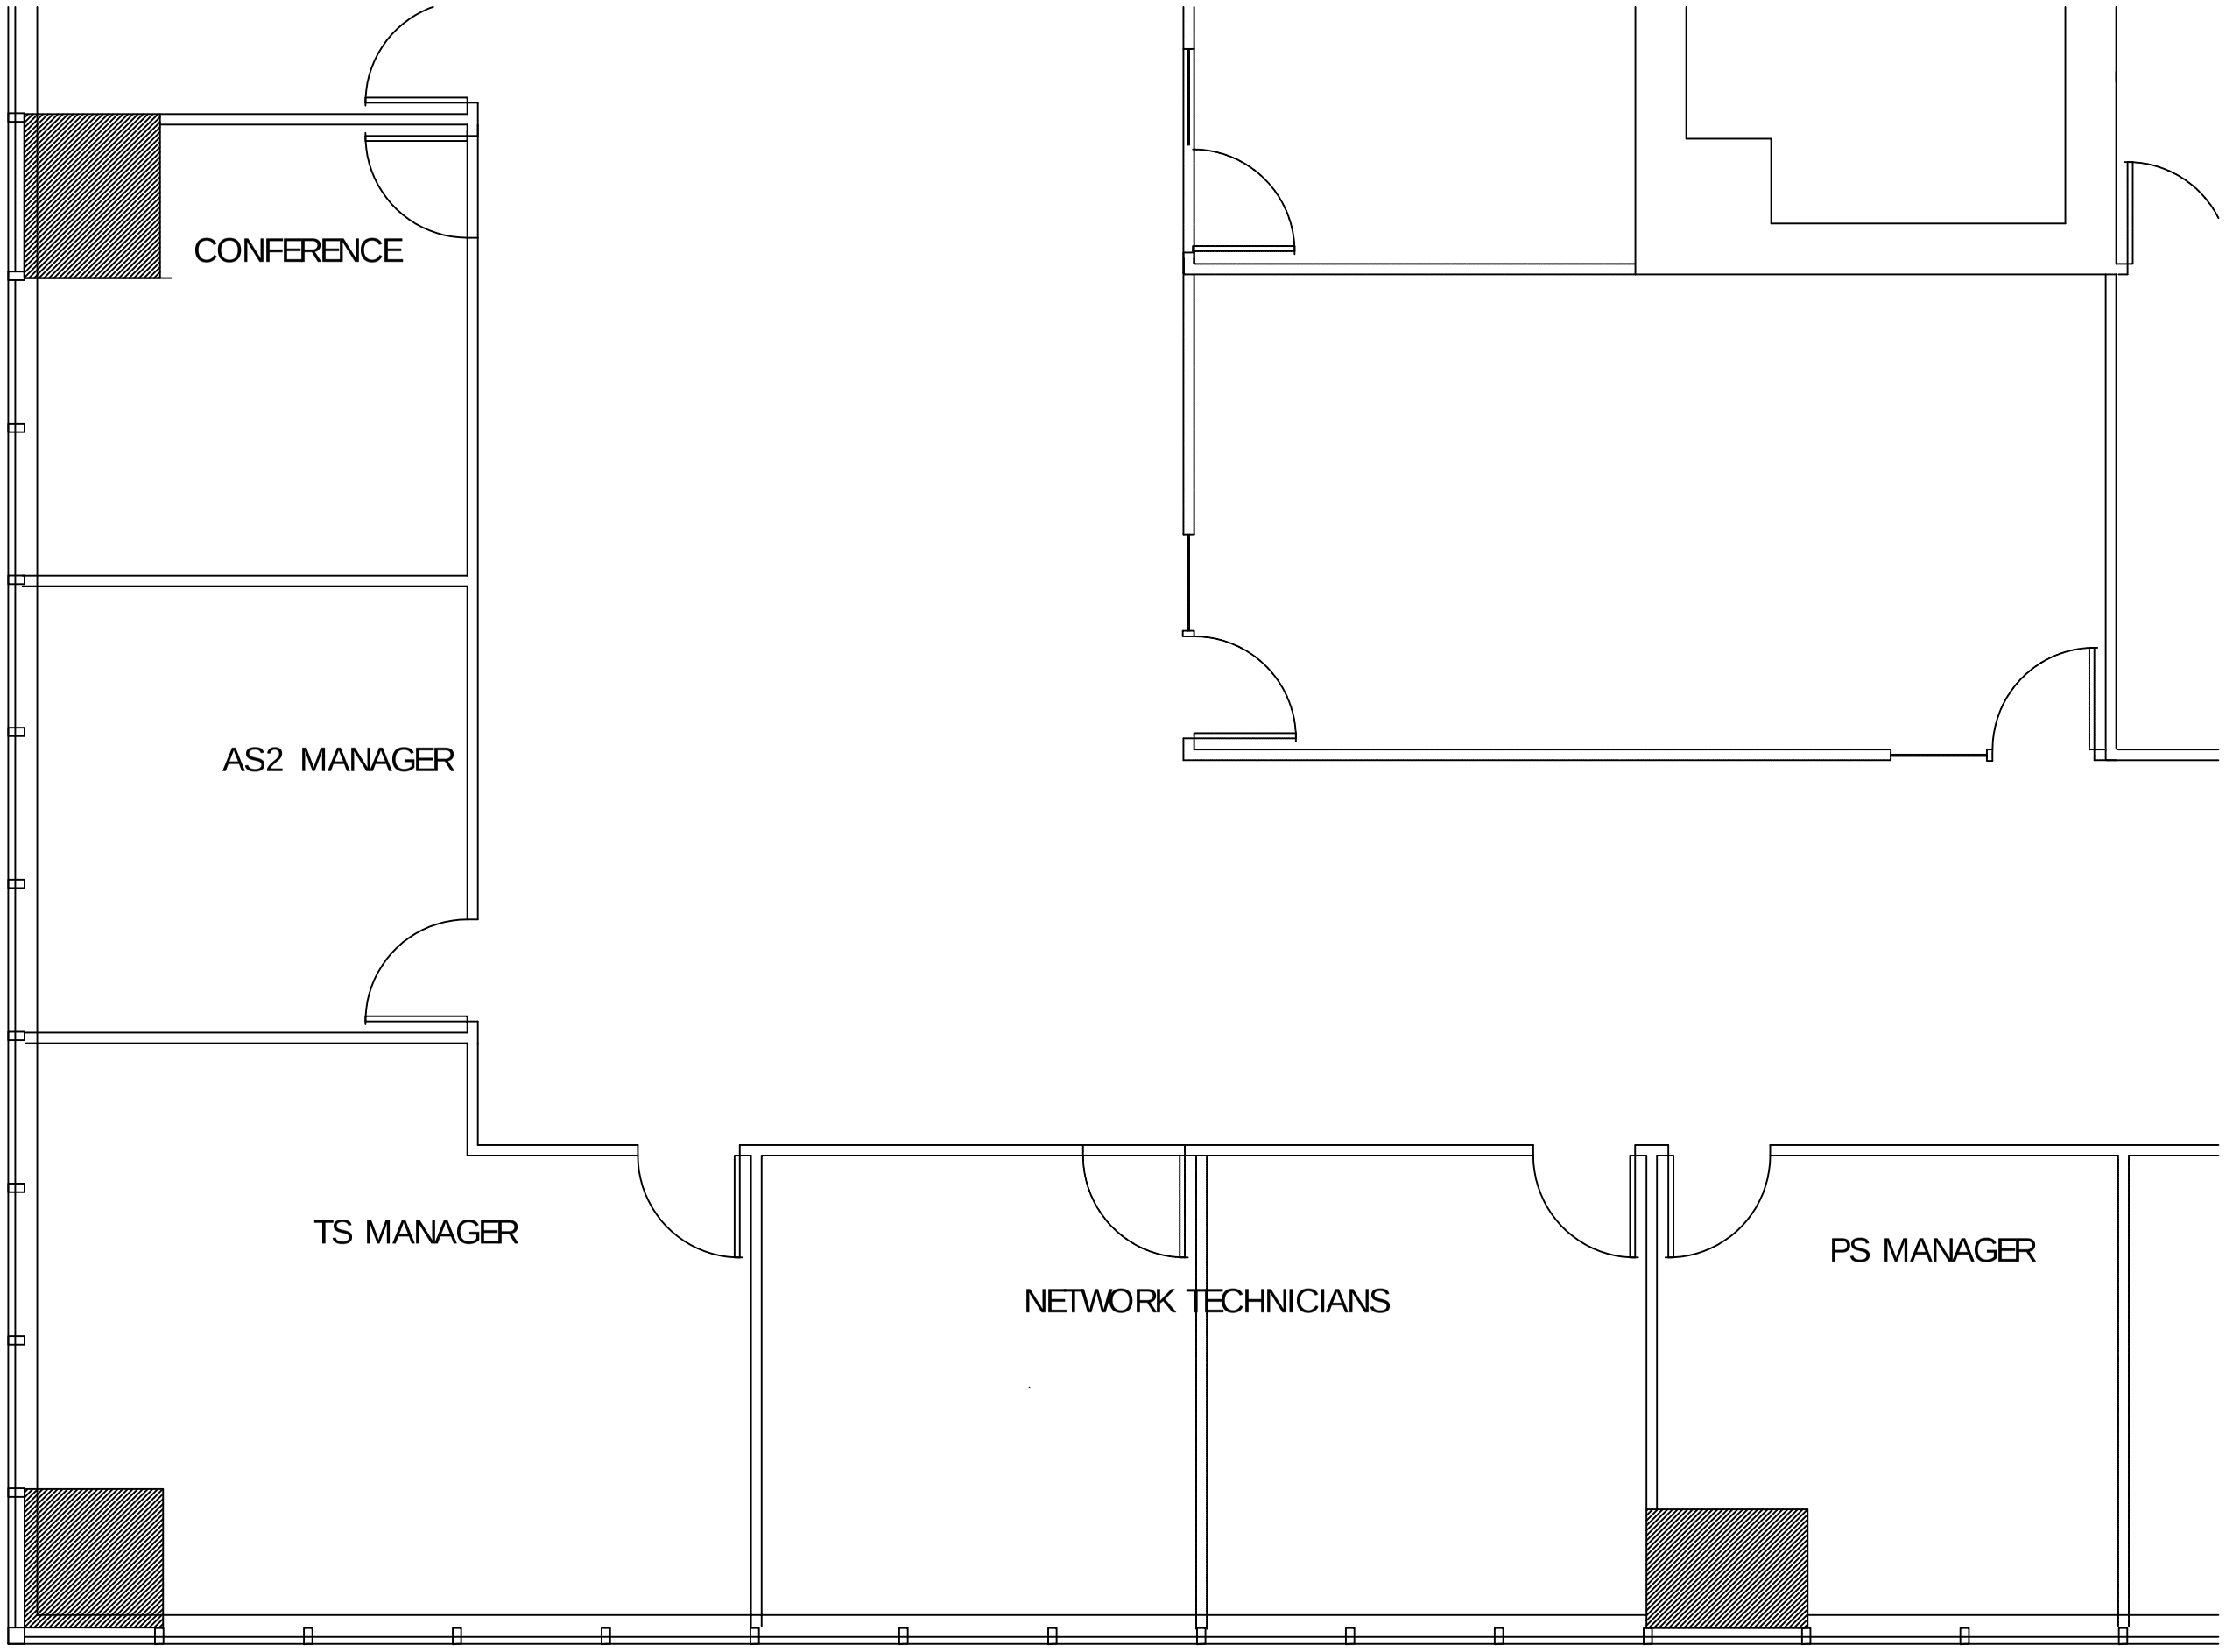
CONFERENCE
AS2 MANAGER
TS MANAGER
NETWORK TECHNICIANS
PS MANAGER