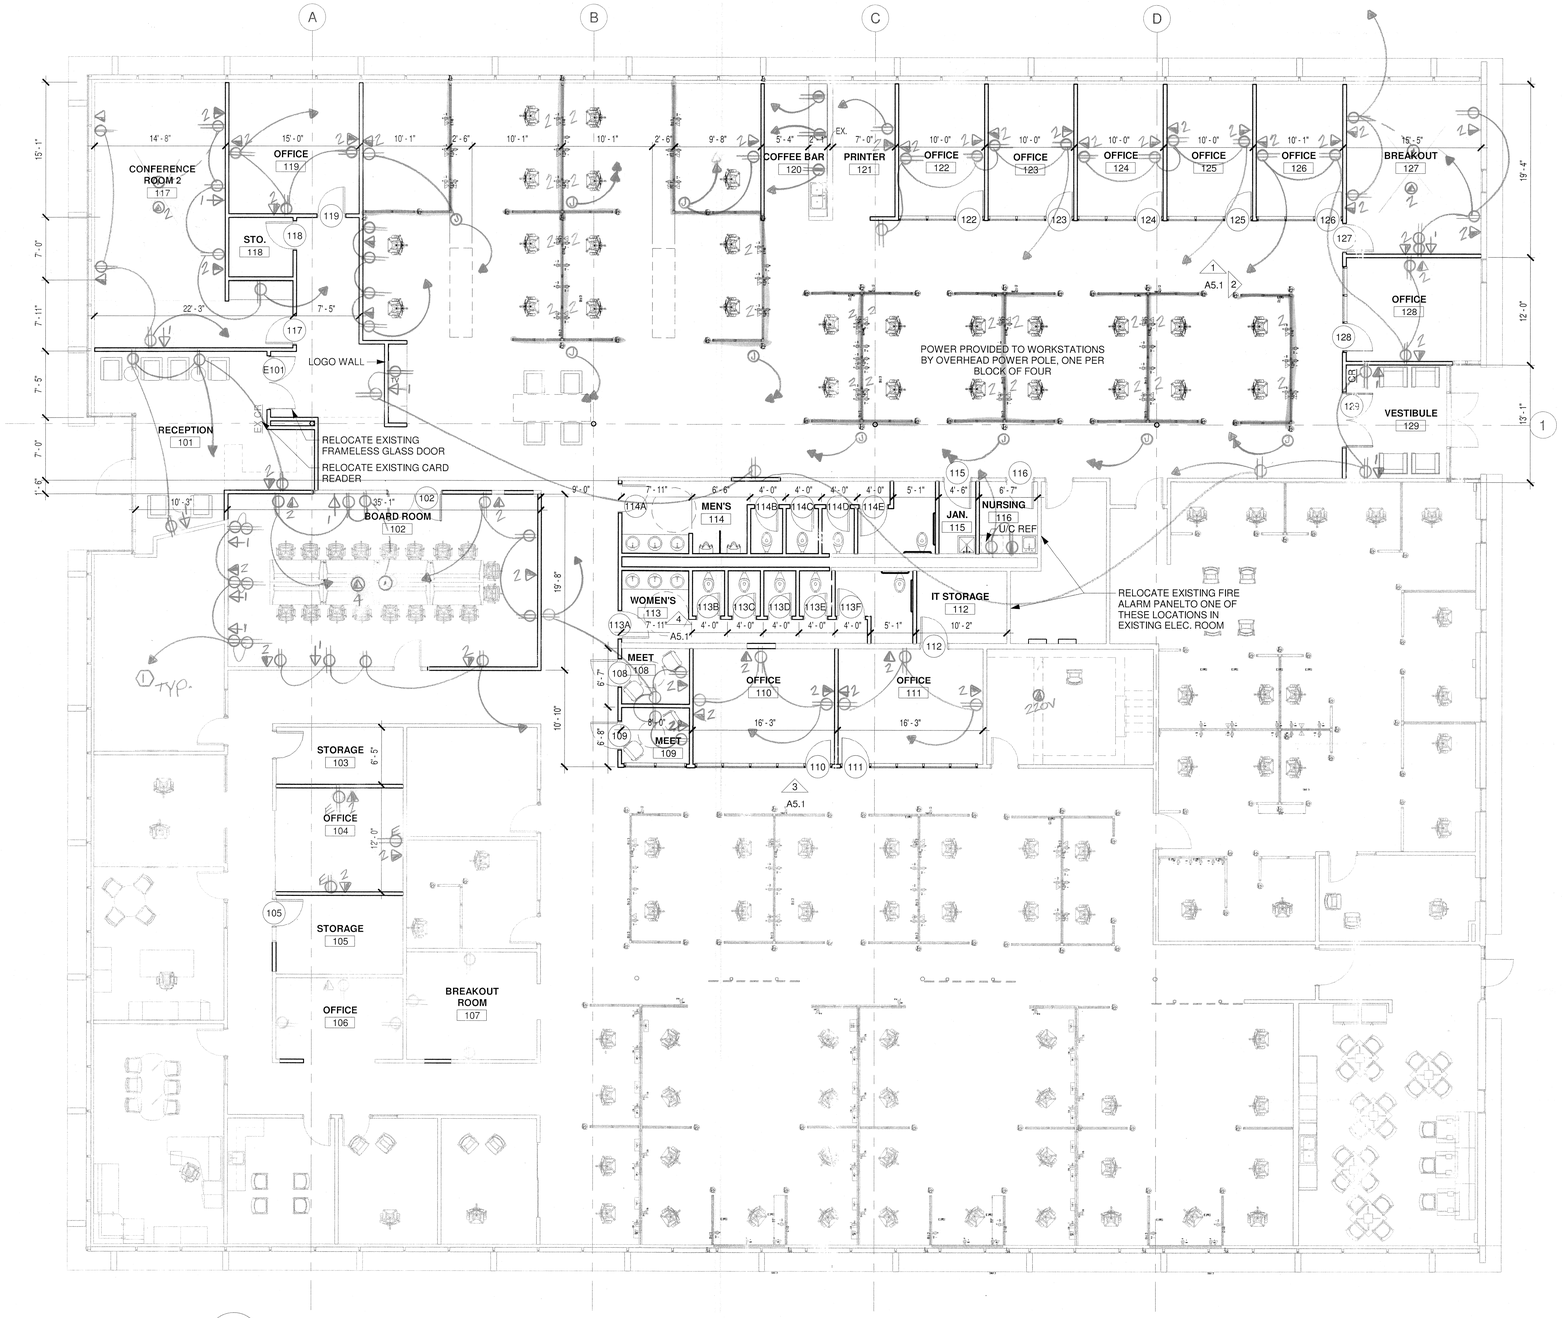

1 A2.2 CANTIUM FLOOR PLAN
1/8" = 1'-0"

1 - CONNECT TO 120V. CIRCUIT MADE AVAILABLE DURING DEMOLITION.

LEGEND

- PATTERN DENOTES AREAS WHERE NEW LVT WILL BE INSTALLED. BASIS OF DESIGN PRODUCT WILL BE MANNINGTON NATURE'S PATHS VIA.
- PATTERN DENOTES AREAS WHERE NEW CARPET TILE WILL BE INSTALLED. CONTRACTOR TO PRICE A TILE THAT IS SIMILAR IN TYPE AND QUALITY TO EXISTING CARPET TILE TO REMAIN.
- TV — WALL MOUNTED TELEVISION. OFCI. POWER AND DATA RECEPTACLE TO BE MOUNTED AT A HEIGHT THAT WILL BE HIDDEN BY INSTALLED TELEVISION.
- FLOOR MOUNTED POWER & DATA. SAWCUT EXISTING SLAB AS NECESSARY TO INSTALL BOX AND RUN CONDUIT.
- CR — NEW CARD READER, MAKE AND MODEL TO BE COMPATIBLE WITH EXISTING CARD READERS.

GENERAL NOTES

ALL WALLS TO HAVE 4" RUBBER WALL BASE

ALL NEW GYPSUM BOARD WALLS TO HAVE FLAT FINISH AND BE PAINTED.

ANY REQUIRED MILLWORK WILL BE PLASTIC LAMINATE FINISH SELECTED FROM MANUFACTURER'S FULL LINE BY ARCHITECT.

ANY REQUIRED COUNTERTOP WILL BE CORIAN SOLID SURFACE CHOSEN FROM MANUFACTURER'S FULL LINE BY ARCHITECT.

RENOVATED RESTROOMS TO HAVE FULL HEIGHT WALL TILE ON ALL WALLS, DESIGN TO BE TYPICAL AS SHOWN ON 4/A5.1.

ALL TOILETS AND URINALS OT BE WALL MOUNTED. ALL FIXTURES TO HAVE FLUSH VALVES. ALL LAVATORIESTO BE UNDERMOUNT OF SOLID SURFACE COPUNTERTOP. OWNER/ARCHITECT TO HAVE FINAL APPROVAL ON ALL PLUMBING SELECTIONS.

ANY EXISTING SIGNAGE NOTING LIFE SAFETY EQUIPMENT OR EXITS THAT MUST BE MOVED DURING CONSTRUCTION SHALL BE REINSTALLED.

ALL RECEPTACLES ABOVE THE COUNTER IN THE BREAK ROOM AREA SHALL BE GFI PROTECTED.

ALL RECEPTACLE LOCATIONS NOTED ON PLAN ARE APPROXIMATE. LOCATIONS WERE INCLUDED SO THAT THE CONTRACTOR MAY ASCERTAIN A NUMBER FOR PRICING. SOME EXISTING AREAS MAY HAVE EXISTING RECEPTACLES THAT WILL SATISFY TENANT REQUIREMENTS. VERIFY WITH TENANT BEFORE REMOVING ANY EXISTING RECEPTACLE OR ADDING ANY NEW RECEPTACLE.

EACH NUMBERED FURNITURE STATION INCLUDED IN THIS PLAN SHALL REQUIRE TWO (2) DATA RECEPTACLES AND FOUR (4) POWER RECEPTACLES, WHICH WILL BE INTEGRAL TO THE FURNITURE. CONTRACTOR TO COORDINATE WITH FURNITURE INSTALLER TO PROVIDE THE REQUIRED WHIPS FOR CONNECTING THE FURNITURE'S POWER.

THE TENANT WILL REQUIRE KEYED LOCKS ON ALL EXECUTIVE OFFICE DOORS, AS WELL AS THE FILE ROOM AS A BACKUP TO CARD READER ACCESS.

CONTRACTOR TO COORDINATE INSTALLATION OF ALL APPLIANCES NOTED ON THIS PLAN, WHICH INCLUDES VERIFYING THAT ALL POWER AND DRAIN LINE REQUIREMENTS WILL BE SATISFIED.

fl+WB architects
a professional corporation In continuous practice since 1991
architecture
planning
interiors
sustainable design
consulting
1404 GREENGATE DRIVE, SUITE 101
COVINGTON, LA 70433
985-893-4100

ISSUE | DATE

CANTIUM EXPANSION

111 PARK PLACE
COVINGTON, LA 70433

THESE DRAWINGS ARE THE SOLE PROPERTY OF FLWB ARCHITECTS, APC AND ARE ISSUED AS INSTRUMENTS OF SERVICE. THESE DRAWINGS SHALL NOT BE COPIED, REPRODUCED OR USED IN ANY MANNER WITHOUT WRITTEN CONSENT OF FLWB ARCHITECTS, APC.

PRELIMINARY DESIGN

Date
18.OCT.19

FLOOR PLAN

Job No. 219043.01

Drawn by PLT | Checked by MJC

Sheet No. A2.2