


2 PLAN

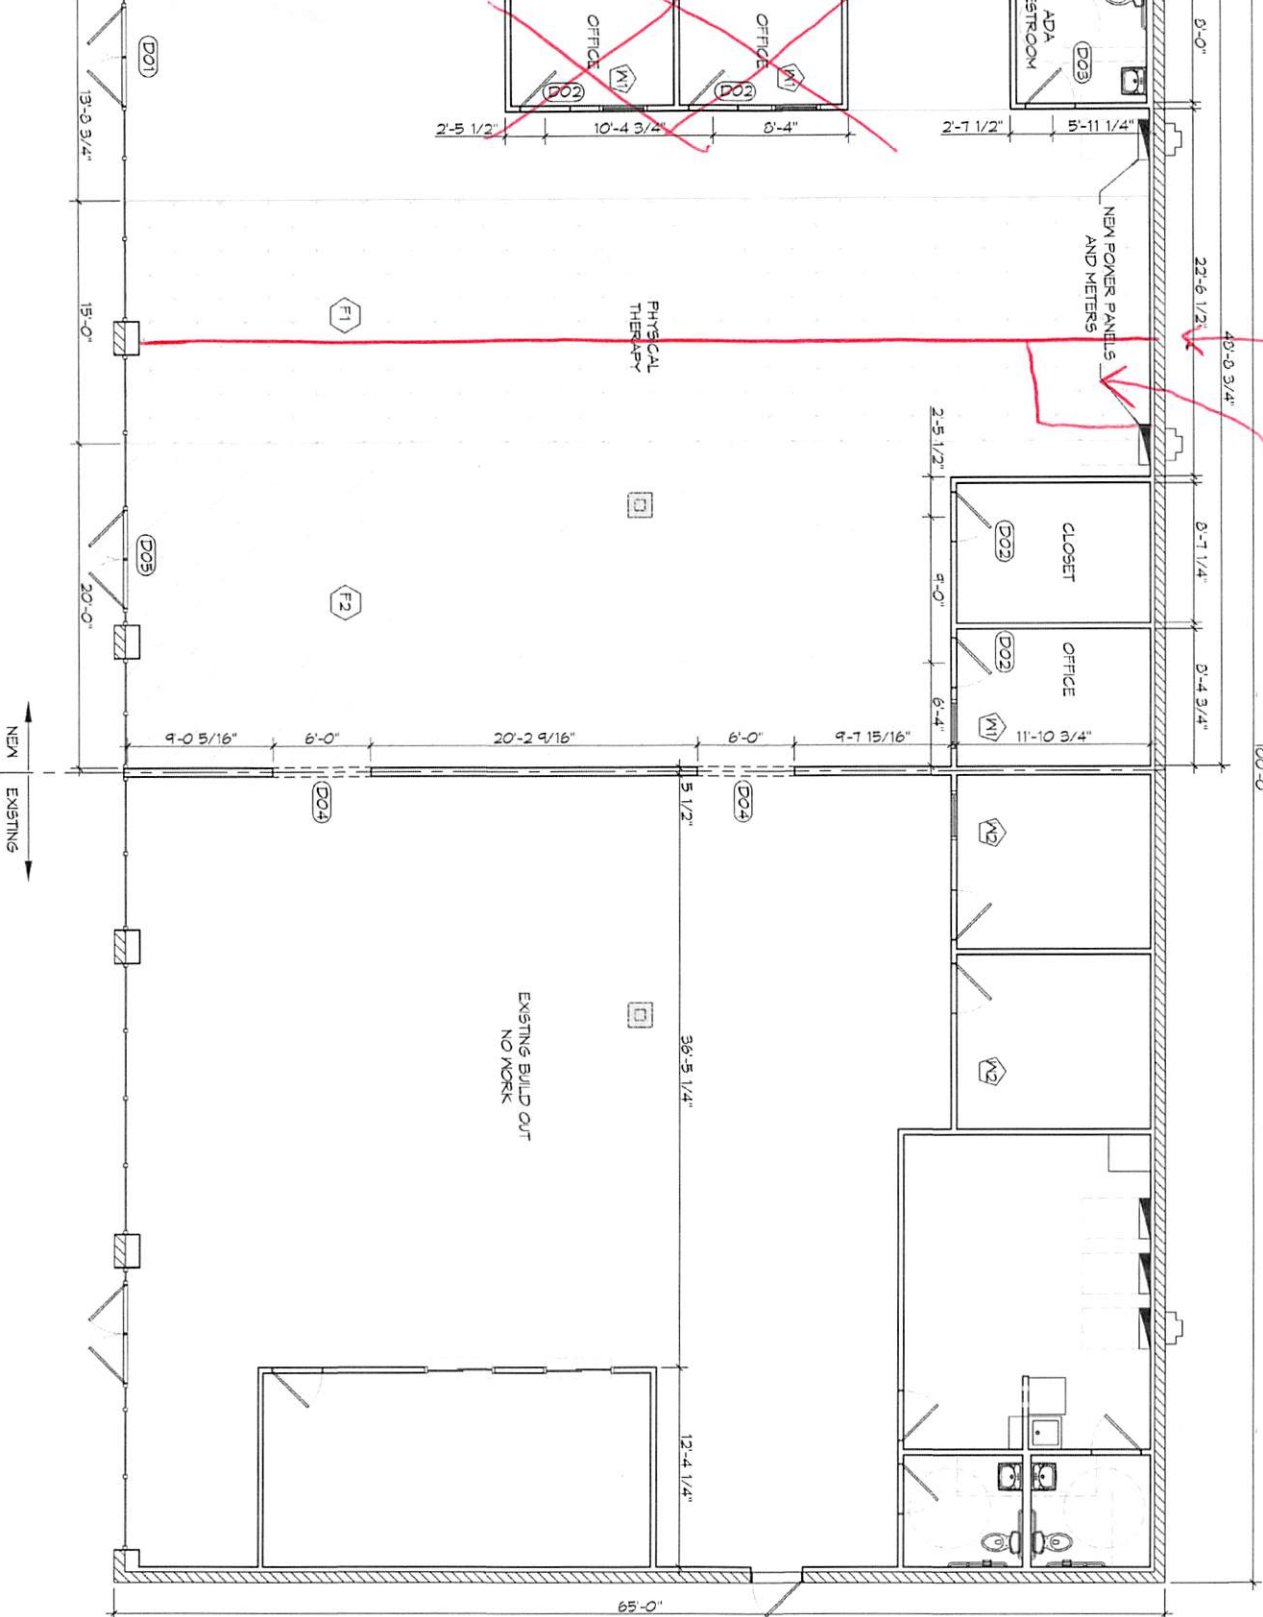

4. CONSTRUCTION SHALL COMPLY WITH ALL APPLICABLE CODES.
5. CONTRACTOR TO GUARANTEE SUBSTANTIAL COMPLETION.
6. CONTRACTOR SHALL FINISH SCHEDULE.
