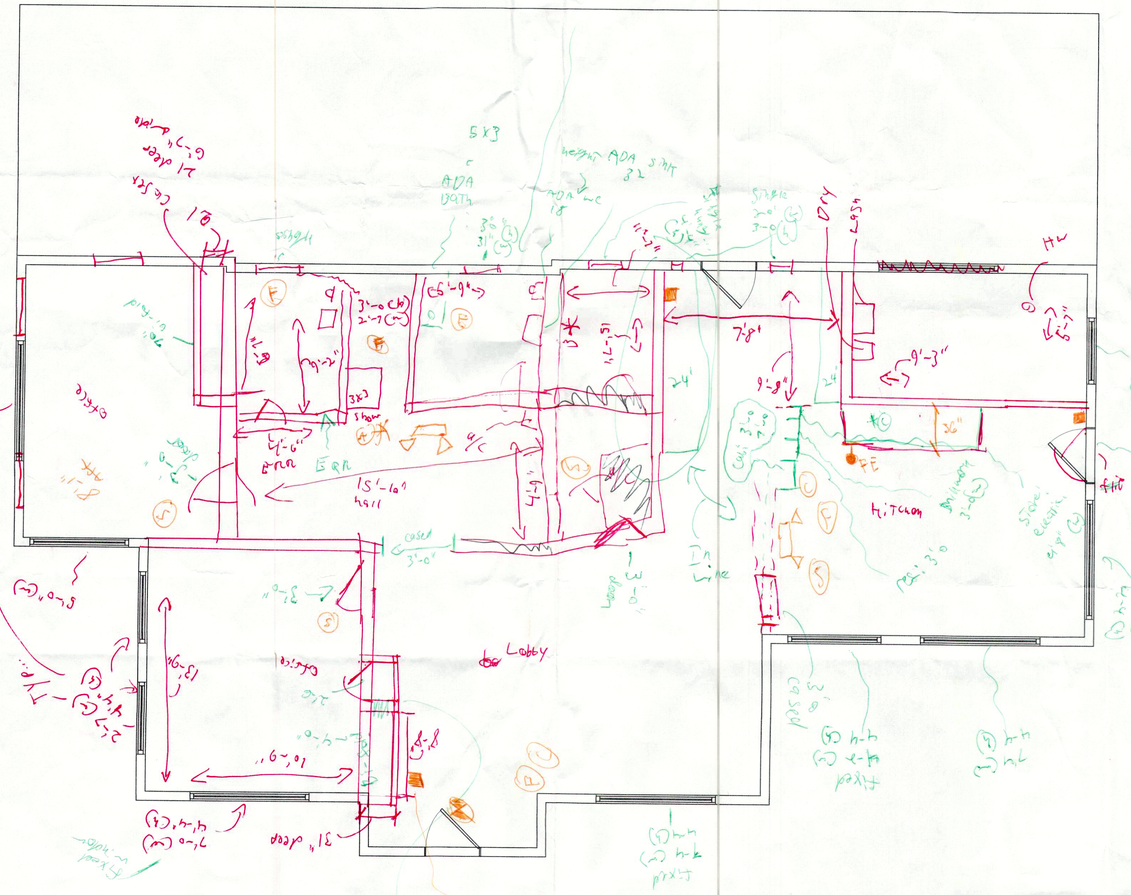

1 FIRST FLOOR PLAN
SCALE: 1/4" = 1'-0"

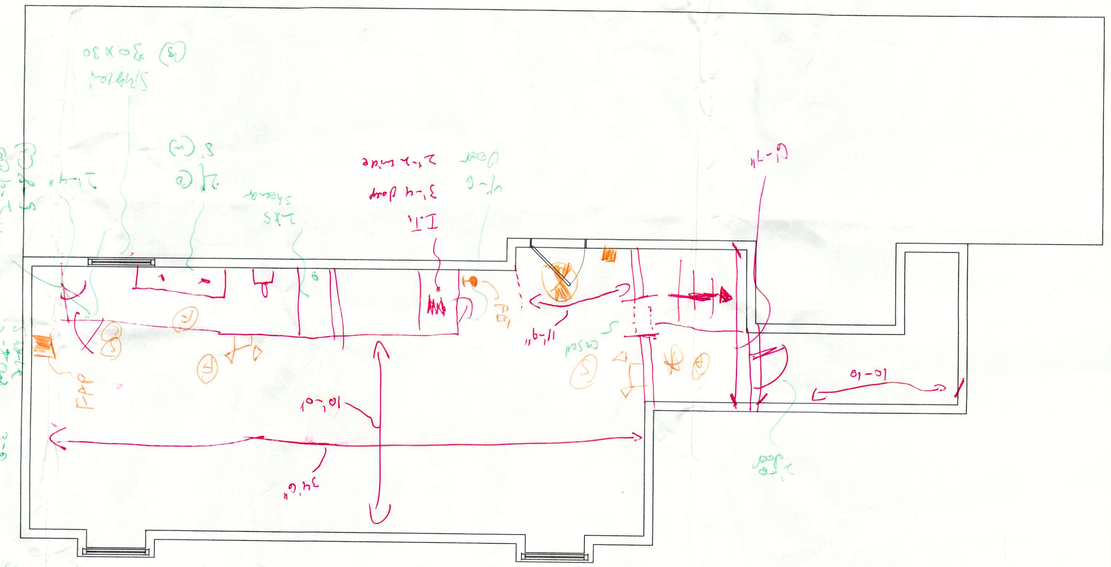

2 SECOND FLOOR PLAN
SCALE: 1/4" = 1'-0"

(A) Smoke, fire, carbon alarm

(B) Closet: 24" Deep, 6'-3" wide, bi fold 6'-0"

(C) Stair Tread: 9 1/2 x 8

DAMMON ENGINEERING, INC.
LOUISIANA & MISSISSIPPI
www.dammonengineering.com
info@dammonengineering.com
PH: 985.649.3832
Chief Engineer: Brian Mistich, PE
554 Old Spanish Trail
Slidell, LA 70458

REVISIONS

#	DESCRIPTION	DATE

SEAL:

EXISTING BUILDING
MIDWIFE GRACE COLLECTIVE
340 BRACKEFIELD ST
SLIDELL, LA 70458

JOB No:	2022	DATE:	08-23-2022
DRAWN BY:	TNT	CHECKED BY:	JMS

The plans, drawings and specifications, designs and other papers, instruments & documents which are prepared or furnished by Dammon Engineering, are the property of Dammon Engineering, and are to be used only for the project for which they are prepared and for which they are furnished by Dammon Engineering. Any other use or reuse by any person or entity, without the express permission of Dammon Engineering, is prohibited. Dammon Engineering, Inc. shall not be held liable for any modifications to the original plans, drawings, specifications, designs, and other papers, instruments & documents, which are not approved by Dammon Engineering, Inc.

SHEET TITLE:
FLOOR PLAN

DRAWING NUMBER:
A101

SHEET No: 4 of 1