


H

17-17

H

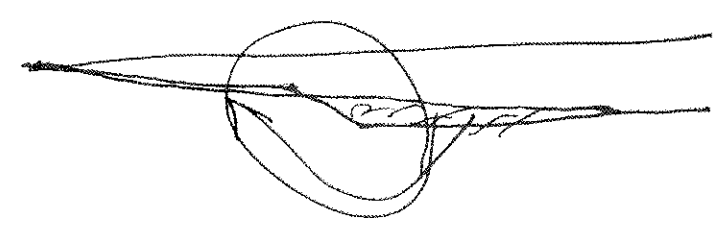

Rate Markup

RCI Peds
 Re-Meeting
 YNCA