

Addendum



Project:
Location:
Date:

Addm. #:

Subject:

To:

From:

Action Required:

Applicable Drawings/Specifications:

Date Required:

Cost Impact:

Schedule Impact:


Question:

Response Date:

Response By:

Response:

UDE IN FAVOR OF
FAMILY PROPERTY
3.49 ACRES ±

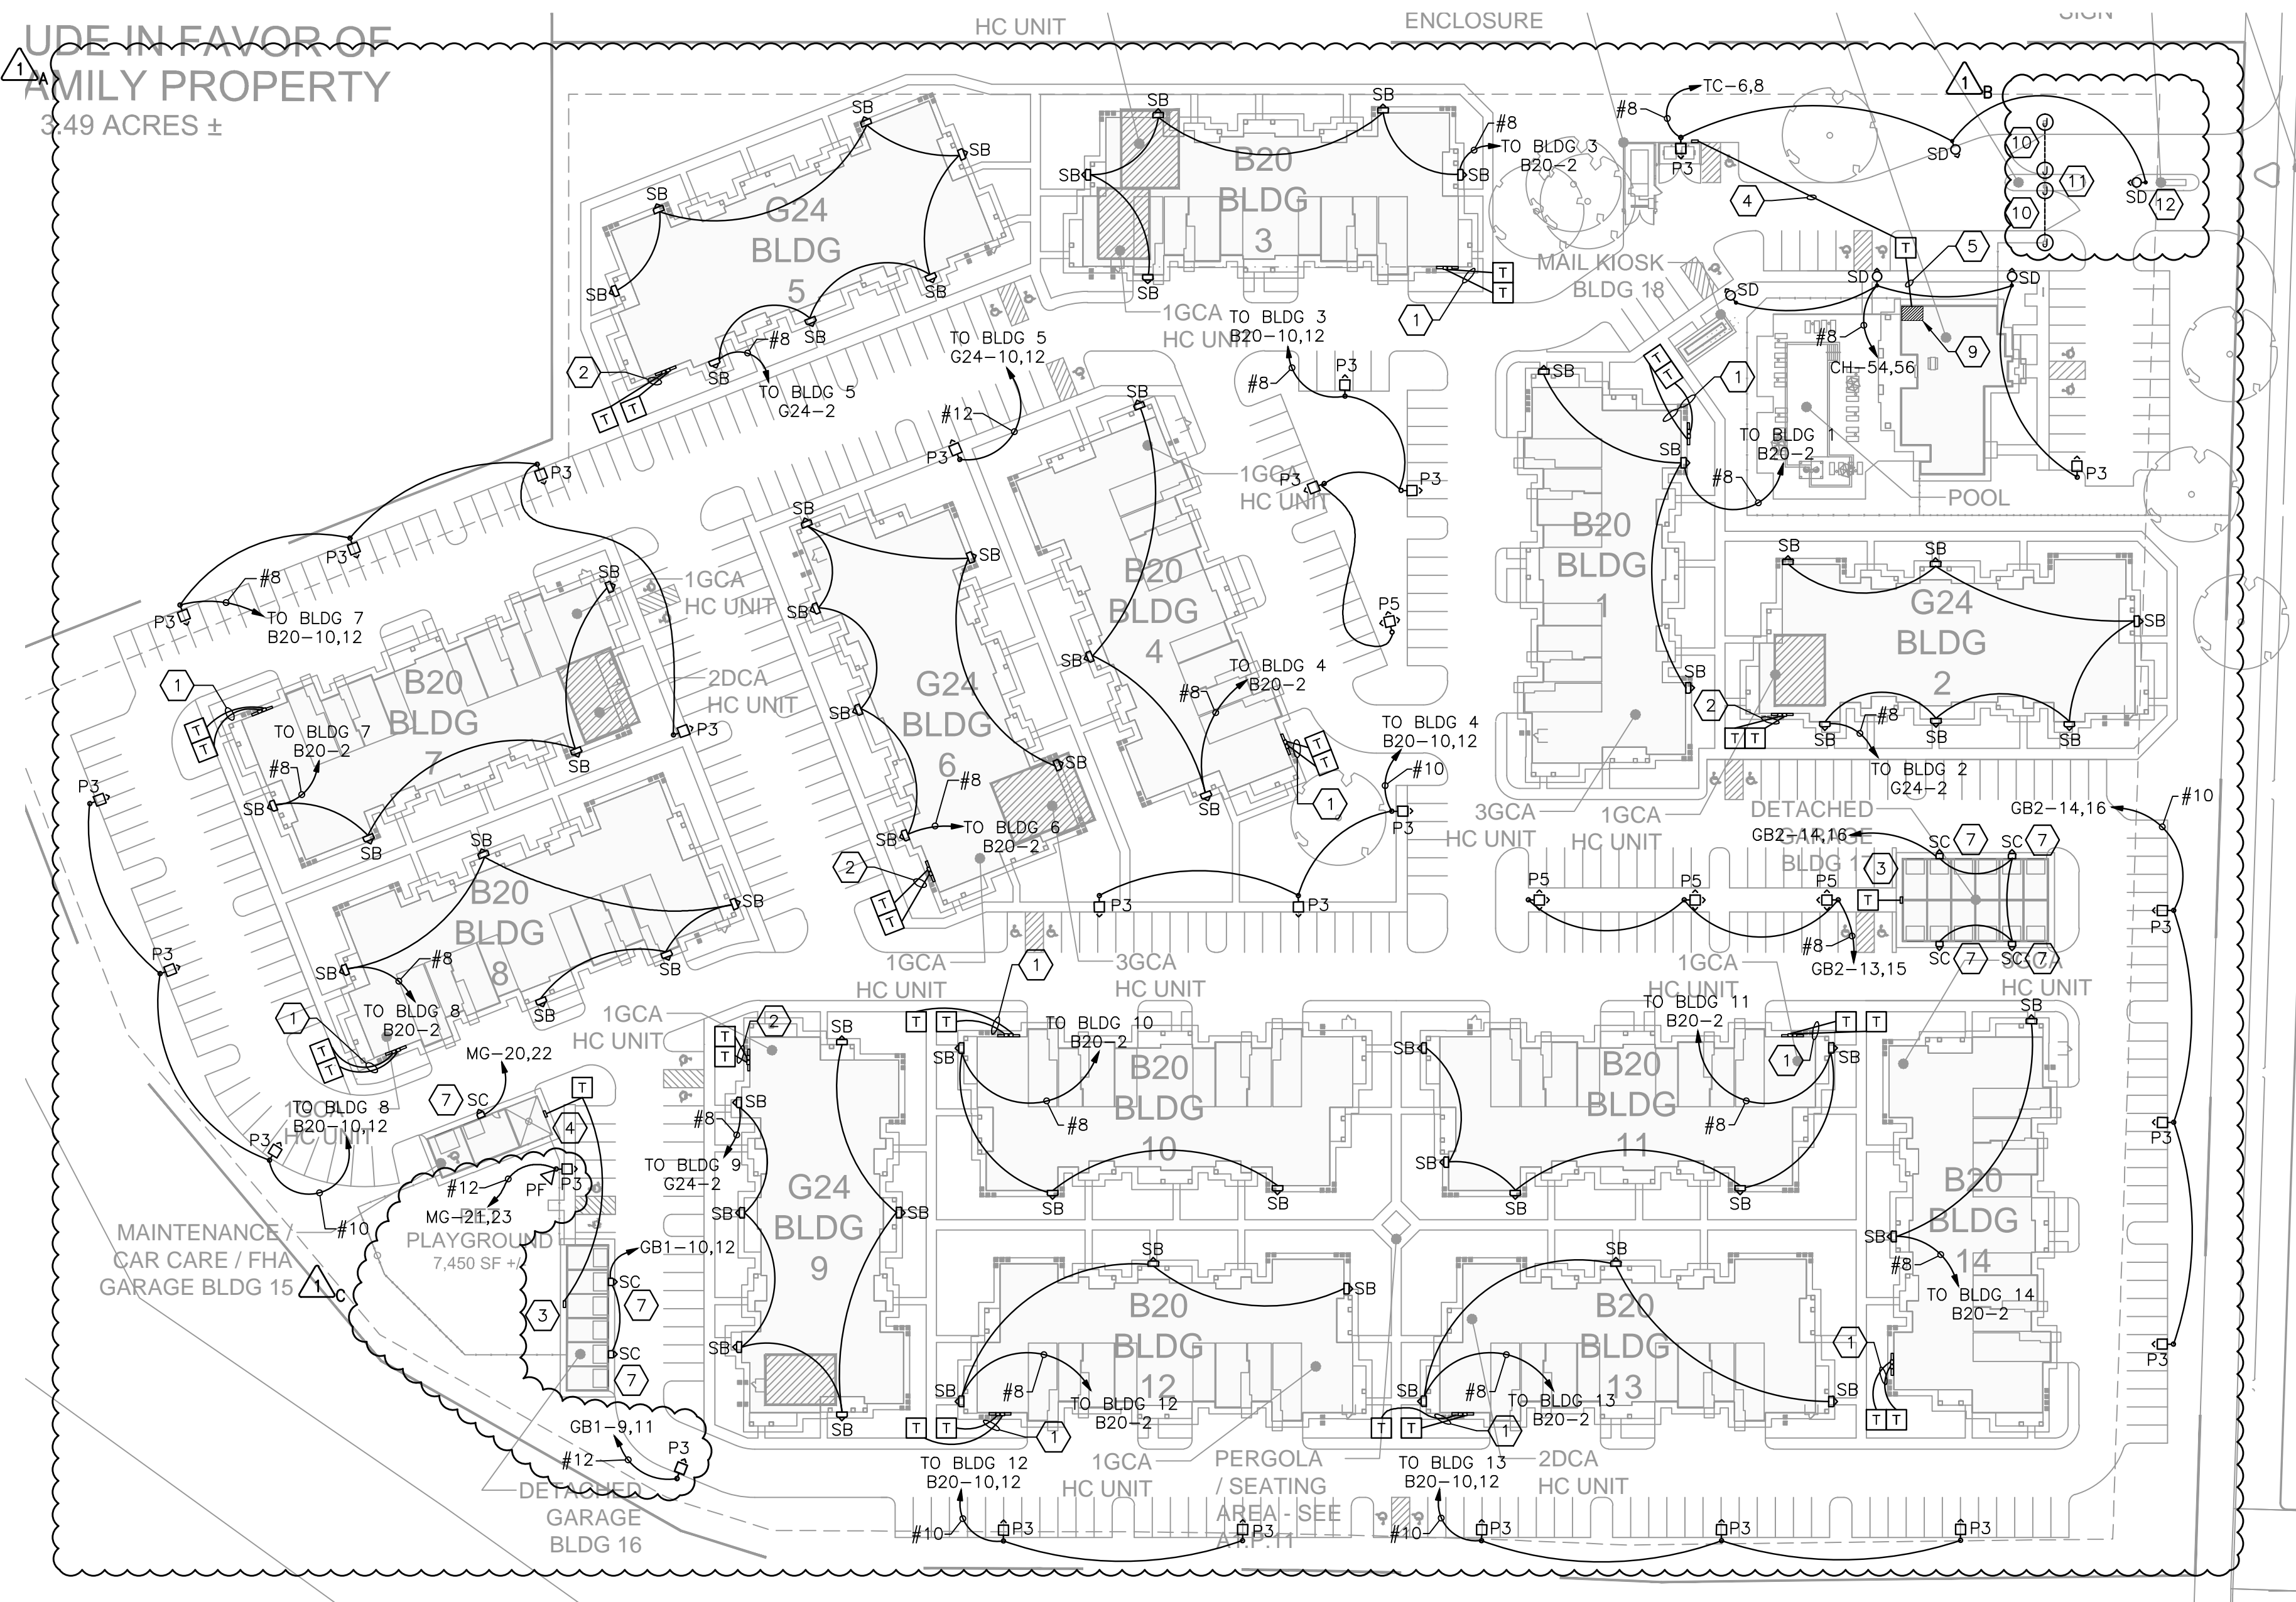

1 ELECTRICAL SITE PLAN
E1.S.10 1" = 60'

SITE LIGHT FIXTURE SCHEDULE

TAG	DESCRIPTION	MANUFACTURER CATALOG NUMBER	LAMP	WATTS	VOLTS	MOUNTING LOCATION	REMARKS
EM	LED EMERGENCY LIGHT	LITHONIA ELM2 LED	LED	-	120	SURFACE	1,2
EMR	LED REMOTE EMERGENCY LIGHT	LITHONIA ELA T QWP L0309	LED	-	120	SURFACE	1,2
F	EXTERIOR WALL SCONCE	PROGRESS P5898-108	(2) 40W T10	80	120	WALL MOUNTED	1
G	SURFACE MOUNTED, UL WET LOCATION LISTED	COLUMBIA LIGHTING LL4-232-EU	(2) 32W T8	70	120	SURFACE MAINTENANCE	1,2
GA	UTILITY GLOBE	HOME STYLE LIGHTING HS31002-30	(1) 43W A19	43	120	CEILING MOUNTED GARAGE	1
P3	POLE MOUNTED LUMINAIRE WITH HORIZONTAL LAMP ORIENTATION	VERSALUX VRS TYPE III 250MH (PULSE START)	(1) 250W MH	290	240	POLE MOUNTED - 20'-0" PARKING LOT	1,2,5,6
P5	POLE MOUNTED LUMINAIRE WITH HORIZONTAL LAMP ORIENTATION	VERSALUX VRS TYPE V 250MH (PULSE START)	(1) 250W MH	290	240	POLE MOUNTED - 20'-0" PARKING LOT	1,2,5,6
PF	POLE MOUNTED FLOODLIGHT WITH HORIZONTAL LAMP ORIENTATION AND GLARE CONTROL	LITHONIA 170S 250MH (PULSE START)	(1) 250W HPS	290	240	POLE MOUNTED - 20'-0" PET PLAYGROUND	1,2,5,6
SA	BUILDING MOUNTED LUMINAIRE WITH VERTICAL LAMP ORIENTATION	LITHONIA TWF1 150M	(1) 150W MH	165	240	BUILDING MOUNTED	1,2,3,4
SB	BUILDING MOUNTED LUMINAIRE WITH VERTICAL LAMP ORIENTATION	LITHONIA TWF1-70M	(1) 70W MH	88	120	BUILDING MOUNTED	1,2,3,4,6
SC	BUILDING MOUNTED LUMINAIRE WITH HORIZONTAL LAMP ORIENTATION	HUBBELL WGM-84F	(2) 42W CFL	84	120	BUILDING MOUNTED	1,2,3,4,6
SD	POLE MOUNTED GOOSENECK FIXTURE WITH HORIZONTAL LAMP ORIENTATION	AMERLUX PT01 / D154-TS20R/HRS	(1) 150W MH	188	240	POLE MOUNTED - 15'-0" PARKING LOT	1,2,6
SE	6" EXTERIOR DOWNLIGHT, WHITE TRIM, FRESNEL LENS	PROGRESS P6132-EB (26watt)/P8034-83	(1) 28W CFL	26	120	RECESSED MAIL KIOSK	1,2
SJ	2-LAMP SURFACE MOUNT LINEAR FLUORESCENT	PROGRESS P7189-30STR (120/277)	(2) 32W T8	64	120	CEILING MOUNTED MAINTENANCE BLDG/ SPRINKLER ROOM	1
SK	PORCELAIN SOCKET FIXTURE, WHITE FINISH	LEVITON R50-09875-000	(1) 150W INCANDESCENT ROUGH SERVICE	150	120	SURFACE ATTIC	1

REMARKS:
 1. SUBSTITUTIONS SHALL BE EQUIVALENT TO MCG NUMBER SHOWN AND APPROVED BY OWNER PRIOR TO PURCHASE.
 2. FIXTURE SHALL BE UL WET LOCATION RATED
 3. FIXTURE SHALL BE SUPPLIED WITH FACTORY INSTALLED PHOTOCCELL.
 4. FIXTURE SHALL BE MOUNTED AT 20'-0" A.F.F. UNLESS NOTED OTHERWISE.
 5. MUST ORDER MATCHING COLOR COMPATIBLE DIRECT BURIAL POLES.
 6. COLOR SHALL BE DARK BRONZE.
 7. SITE LIGHTING POLES SHALL BE FIBERGLASS DIRECT BURIAL TYPE WHERE PERMITTED

LIGHTING CONTROL SCHEDULE

TAG	LOCATION	COIL VOLTAGE	CONTACT VOLTAGE	CONTACT RATING	POLES	CIRCUITS CONTROLLED	SCHEDULE
MG1	MAINTENANCE BUILDING	120	240	30A	6	MG-20,21,22,23	PHOTOCCELL ON/OFF
GB1	8 BAY GARAGE BUILDING	120	240	30A	6	GB1-9,10,11,12	PHOTOCCELL ON/OFF
GB2	12 BAY GARAGE BUILDING	120	240	30A	6	GB2-13,14,15,16,20	PHOTOCCELL ON/OFF
CH1	CLUBHOUSE	120	240	30A	6	CH-1,7,16,58,60	PHOTOCCELL ON/OFF
B20	TYPICAL BLDG B20	120	240	30A	4	B20-2,10,12	PHOTOCCELL ON/OFF
G24	TYPICAL BLDG G24	120	240	30A	4	G24-2,10,12	PHOTOCCELL ON/OFF

REMARKS:
 MECHANICALLY HELD, MULTI-POLE LIGHTING CONTACTORS - NUMBER OF POLES AND CONTACT RATING AS INDICATED.
 SQUARE D TYPE L OR EQUIVALENT.

KEYED NOTES

- 1 SERVICE ENTRANCE CONNECTION TO TYPICAL BUILDING B20. REFER TO SHEET E1.A.11 FOR DETAILS.
- 2 SERVICE ENTRANCE CONNECTION TO TYPICAL BUILDING G24. REFER TO SHEET E1.B.11 FOR DETAILS.
- 3 SERVICE ENTRANCE CONNECTION TO GARAGE UNITS. REFER TO SHEET E2.G.10 FOR DETAILS.
- 4 SERVICE ENTRANCE CONNECTION TO TRASH COMPACTOR/ MAINTENANCE BUILDING. REFER TO SHEET E2.G.11 FOR DETAILS.
- 5 SERVICE ENTRANCE CONNECTION TO CLUB HOUSE. REFER TO SHEET E2.C.01 FOR DETAILS.
- 6 CONNECT TO HOUSE PANEL SERVING THIS AREA.
- 7 LIGHT FIXTURE SHALL BE MOUNTED AT +12'-0" A.F.F.
- 8 LIGHT FIXTURE SHALL BE MOUNTED AT +15'-0" A.F.F.
- 9 LOCATION OF CLUBHOUSE ELECTRICAL ROOM.
- 10 COORDINATE WITH GATE EQUIPMENT SUPPLIER TO PROVIDE AS PART OF THE SYSTEM AN ELECTRIC EYE SAFETY FOR GATE CONTROL.
- 11 CONTRACTOR SHALL RUN (2) 1" CONDUITS TO EACH GATE FOR POWER AND CONTROLS FROM CLUBHOUSE PANEL 'CH.' COORDINATE WITH GATE EQUIPMENT SUPPLIER FOR ALL INSTALLATION REQUIREMENTS.
- 12 CONTRACTOR SHALL RUN A 1/2" CONDUIT AND PROVIDE A DEDICATED TELEPHONE LINE TO MEET INTERCOM DIAL-UP REQUIREMENTS FOR ACCESS GATE. COORDINATE WITH INTERCOM AND GATE SUPPLIERS FOR ALL INSTALLATION REQUIREMENTS.

ADDENDUM #1 SUMMARY

- A. BUILDING NUMBERS AND CIRCUITING REVISED.
- B. ADDED CIRCUITS AND KEYED NOTES FOR GATE EQUIPMENT AND INTERCOM.
- C. POLE FIXTURE REMOVED. POLE MOUNTED FLOODLIGHT ADDED.
- D. NEW FIXTURE 'PF' ADDED TO SCHEDULE.



PHILLIPS

Phone 770.394.1616 Fax 770.394.1314

CONSULTANT



PHILLIPS
NORTH TERRACES
400 PERIMETER CENTER TERRACE
SUITE 650
ATLANTA, GA 30346

SEAL

ISSUE & REVISION RECORD

#	DATE	DESCRIPTION
	07/07/14	BID SET
1	07/22/14	OWNER COMMENTS FOR PERMIT

This document is the property of Phillips Partnership, PC and is considered an instrument of service and is loaned to you for use with respect to the project as indicated below. All rights reserved. This document may not be reproduced without the prior written consent of Phillips Partnership, PC.

PROJECT

SPRINGS AT FREMAUX TOWN CENTER
SLIDELL, LA

CLIENT

CONTINENTAL PROPERTIES
CONTINENTAL 294 FUND LLC
1514 38675 EXECUTIVE PARKWAY
MEMPHIS, TN 38051
262.502.5500 • FAX 262.502.5522

PHILLIPS JOB NUMBER 1333104

ISSUE DATE 07/07/14

DRAWN BY/CHECKED BY JDP

DRAWING TITLE

ELECTRICAL SITE PLAN

SHEET NUMBER

E1.S.10

NORTH TERRACES
400 PERIMETER CENTER TERRACE
SUITE 650
ATLANTA, GEORGIA 30346