

Request for Information



Project:

Location:

Date:

RFI #:

Subject:

To:

From:

Action Required:

Applicable Drawings/Specifications:

Date Required:

Cost Impact:

Schedule Impact:

Question:

Response Date:


Response By:

Response:

Pulletti


CLUBHOUSE BATHROOM TILE ELEVATIONS.

RESTROOM WALL TILE ELEVATION 7.14.2014

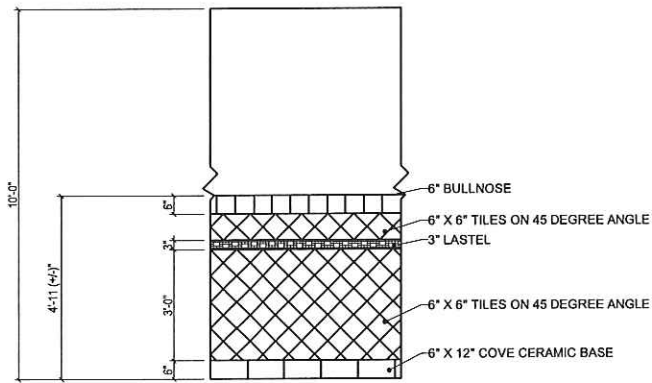

RESTROOM TILE ELEVATION
1/4" = 1'-0"

*ADJUST TILE LINES IN OTHER
RESTROOM ELEVATIONS
ACCORDINGLY*

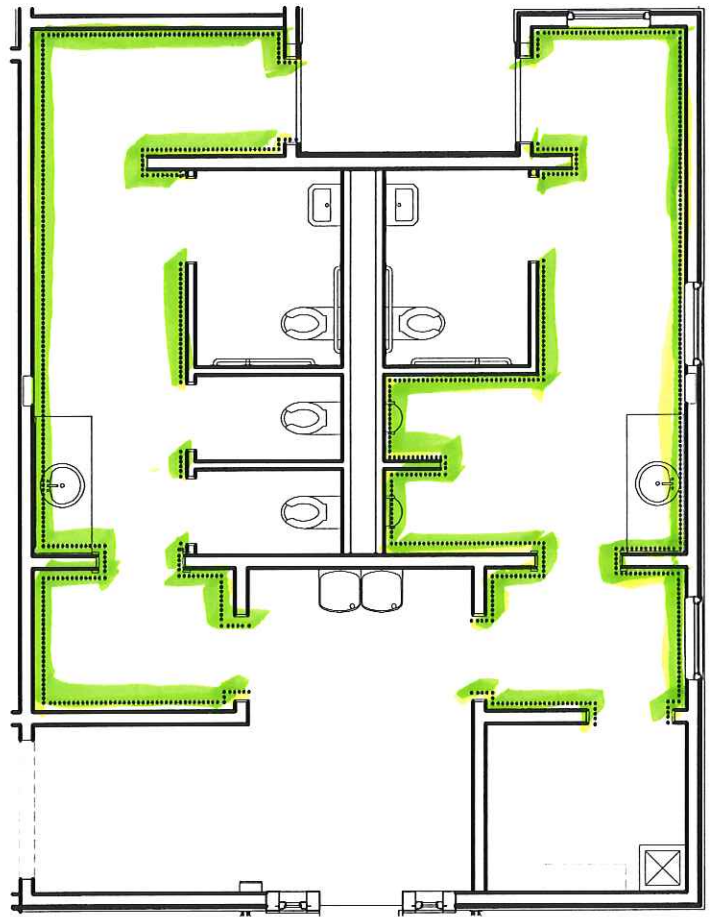

CLUBHOUSE RESTROOM PLAN
3/16" = 1'-0"