


Highlighted area shows where cinder block chain wall will be installed with concrete footing

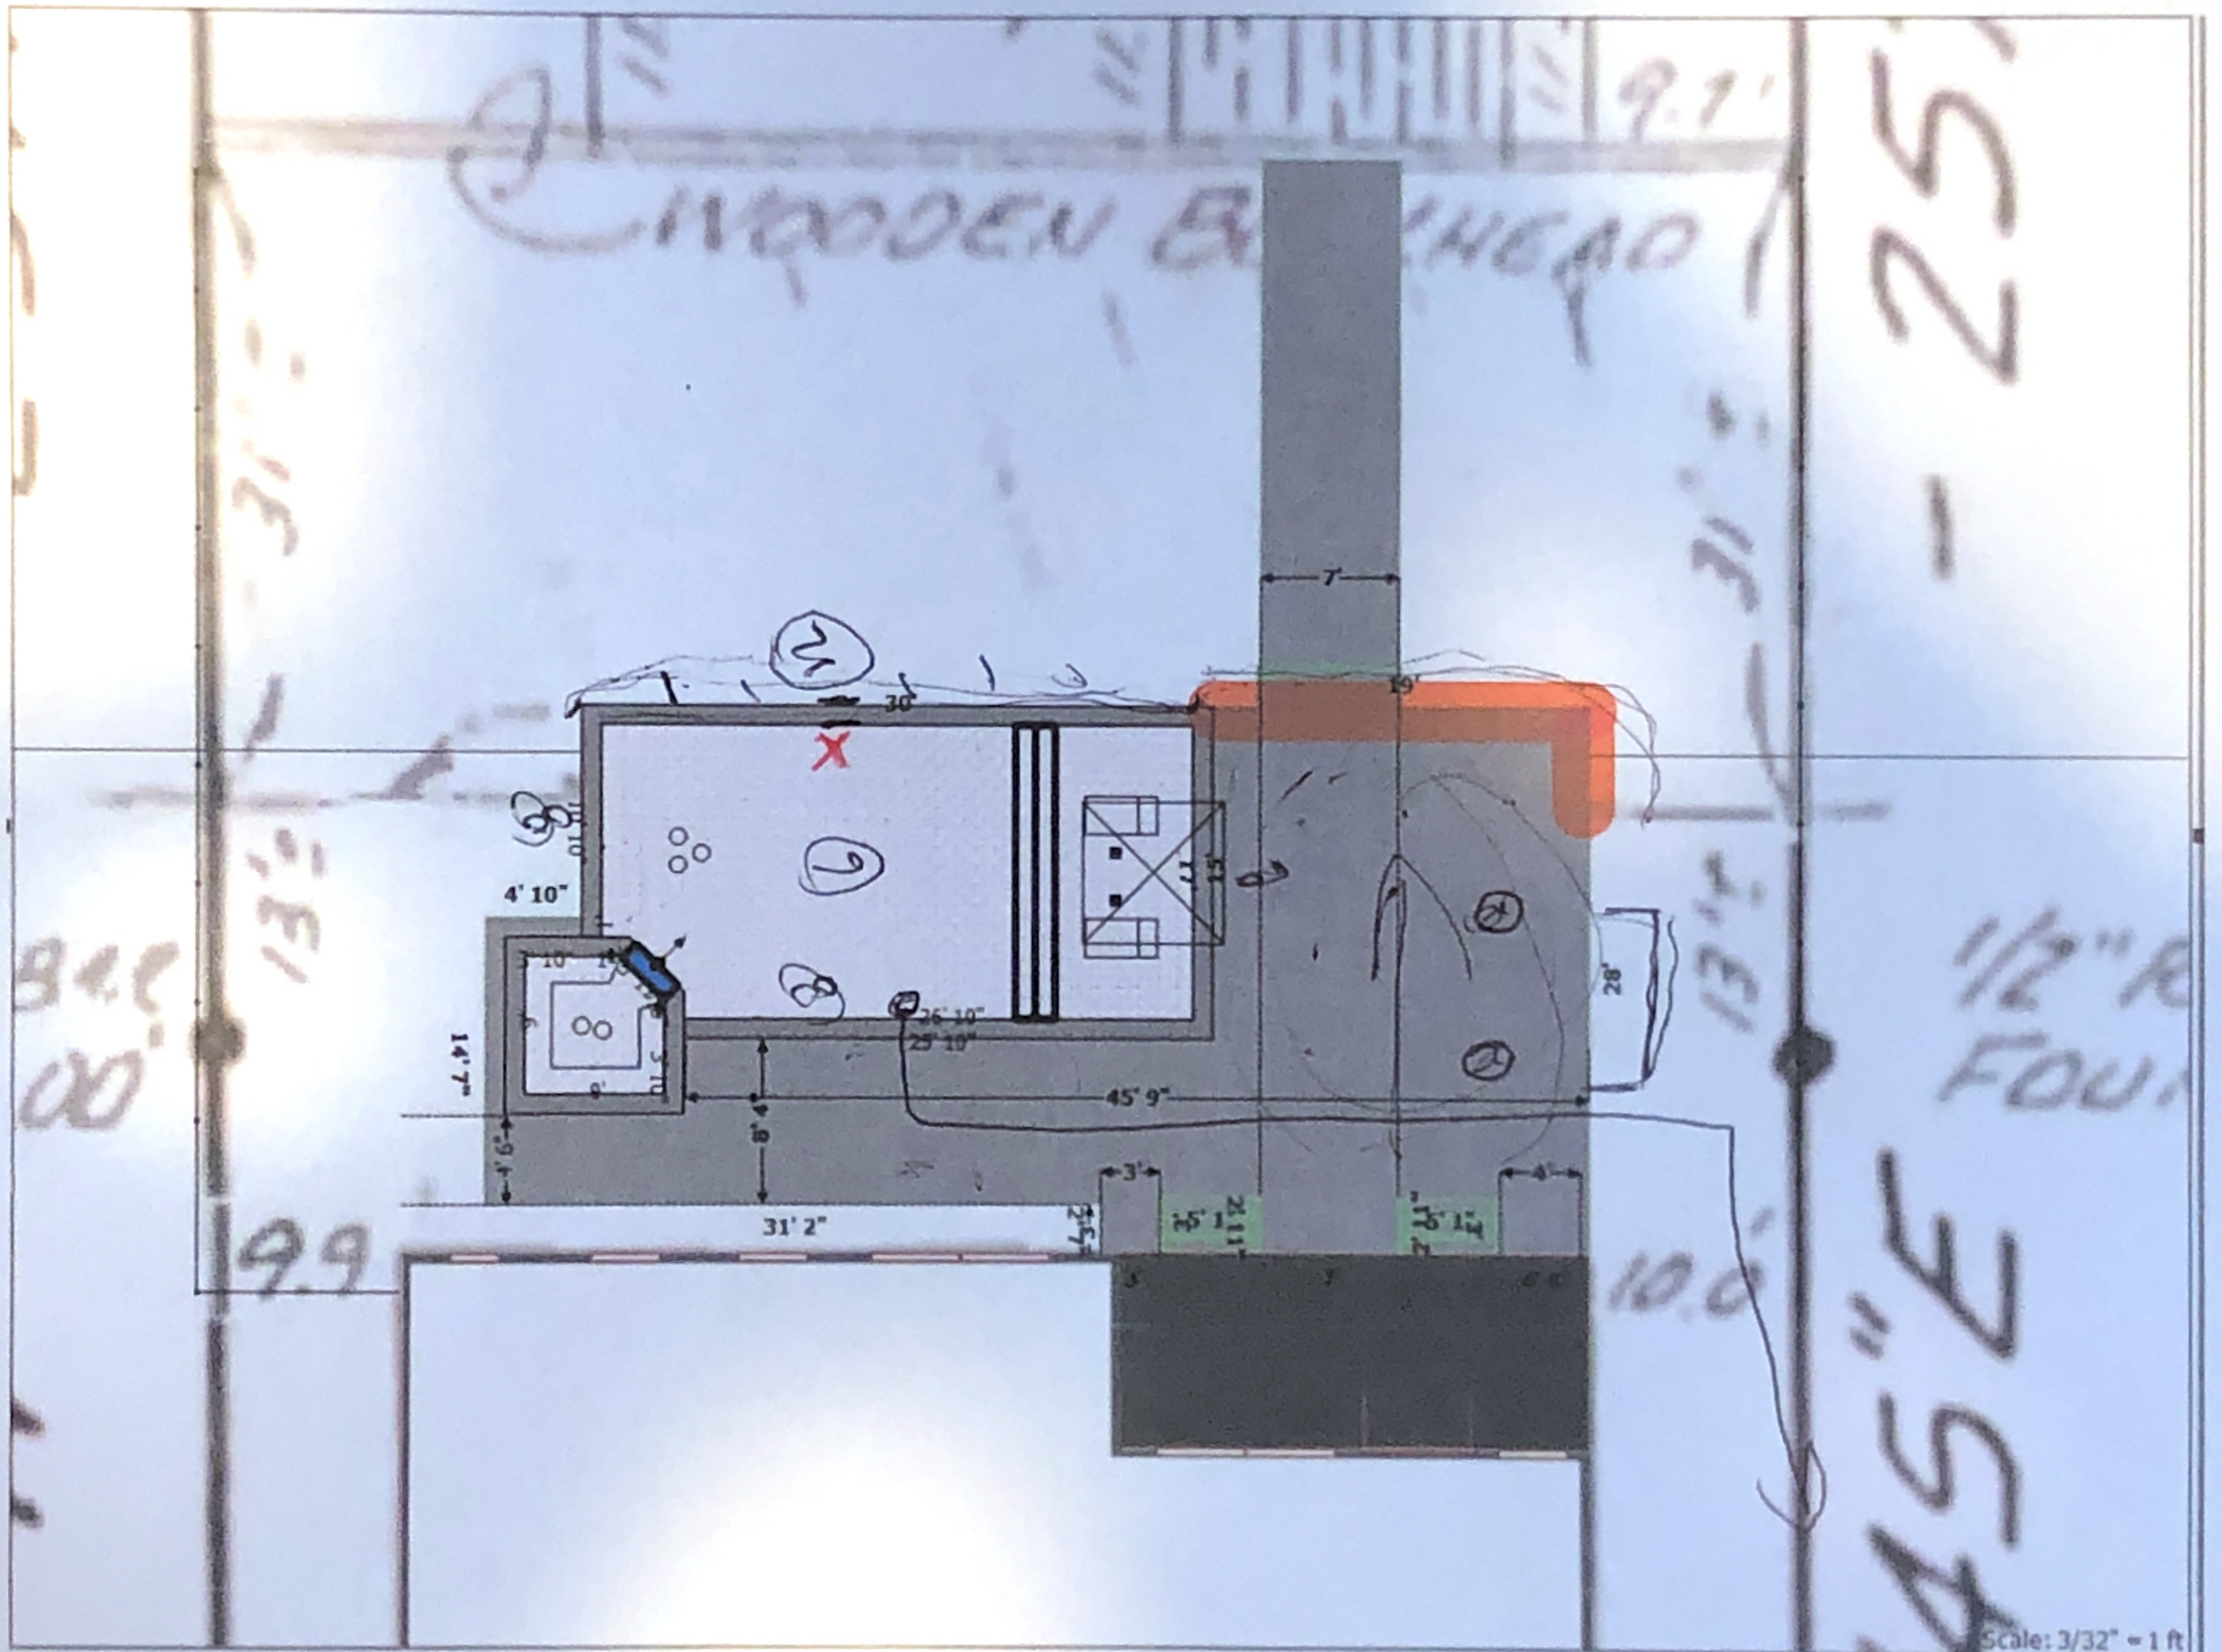

Scale: 3/32" = 1 ft