



B DETAIL
SCALE: N.T.S.
POOL EQUIPMENT DRAIN

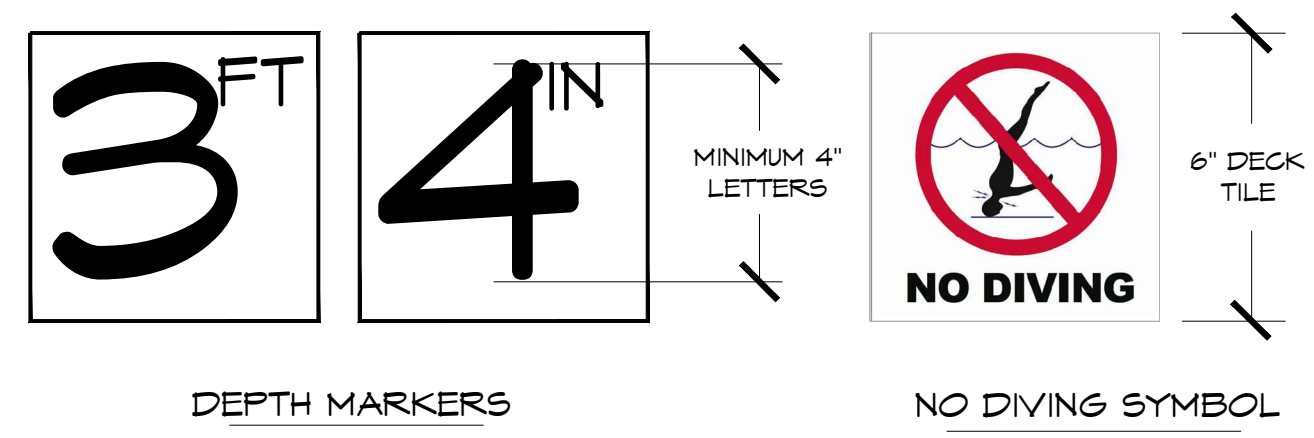


- DEPTH MARKERS**
- MARKER REQUIREMENTS:
1. DEPTH MARKERS BOTH SHOWING FEET AND INCHES
 2. NO DIVING SYMBOL MARKER WITH EACH DEPTH MARKER.
- NOTES:
1. DEPTH MARKERS SHALL BE PLACED ON THE DECK WITH SPACING NOT TO EXCEED 25'-0", NO MORE THAN 2 FOOT OF CHANGE IN SLOPE, AND TO ALSO PLACE A CORRESPONDING DEPTH MARKER IN DUPLICATE ON THE POOL WALL.
 2. DECK TILES TO BE WITHIN 18" OF THE POOL WATER SURFACE
 3. DECK TILES TO BE POSITIONED TO BE READ WHILE STANDING ON THE DECK FACING THE WATER.
 4. DEPTH MARKERS TO BE IN ENGLISH.
 5. NUMERICAL COLOR OF LETTERING TO BE BLACK, ON WHITE BACKGROUND.
 6. "NO DIVING" INTERNATIONAL SYMBOL MARKER TO BE PLACED AT EVERY LOCATION WHERE A DEPTH MARKER IS LOCATED.
 7. ALL DECK DEPTH MARKERS & NO DIVING SYMBOLS ARE TO HAVE A SLIP RESISTANT FINISH TYPICAL.
 8. POOL WALL DEPTH MARKERS & NO DIVING SYMBOLS ARE TO HAVE A SMOOTH FINISH.

C DETAIL
SCALE: N.T.S.
POOL DRAIN

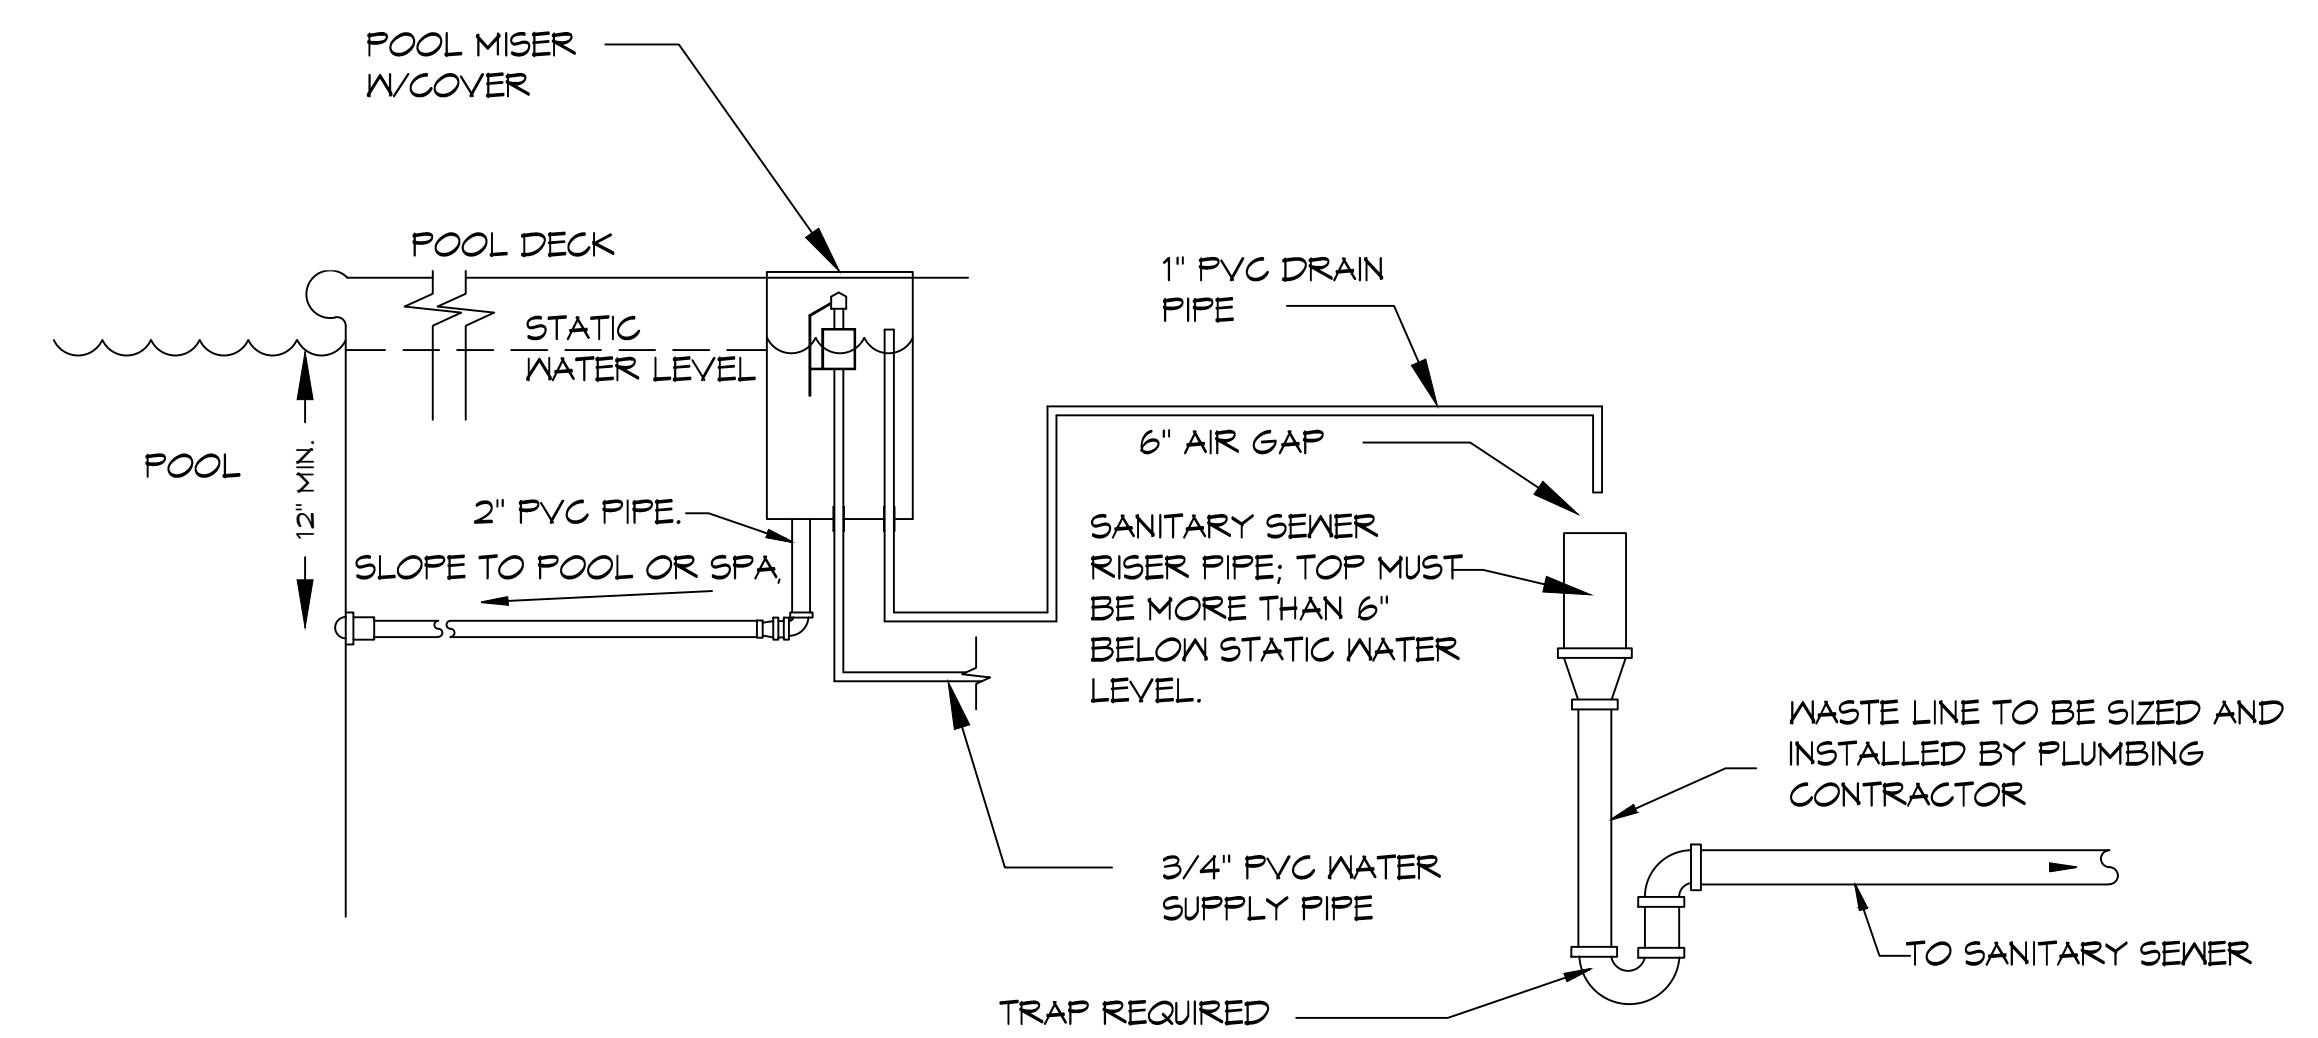


D DETAIL
SCALE: N.T.S.
POOL WATER FEED & OVERFLOW

- NOTES:
1. ANY AND ALL METAL PARTS ASSOCIATED WITH THE POOL WATER CIRCULATION SYSTEM (I.E. PUMPS) SHALL BE BONDED PER NEC ARTICLE 680.
 2. ALL METAL PARTS WITHIN 5 FT. OF THE INSIDE WALL OF THE POOL AND NOT SEPARATED BY A PERMANENT BARRIER ARE REQUIRED TO BE BONDED PER NEC ARTICLE 680.
 3. ALL EQUIPOTENTIAL BONDING TERMINATIONS MUST BE MADE BY EXOTHERMIC WELDING. LISTED PRESSURE CONNECTORS OF THE SET SCREW OR COMPRESSION TYPE, LISTED CLAMPS, OR OTHER LISTED FITTINGS. (NEC ARTICLE 680)

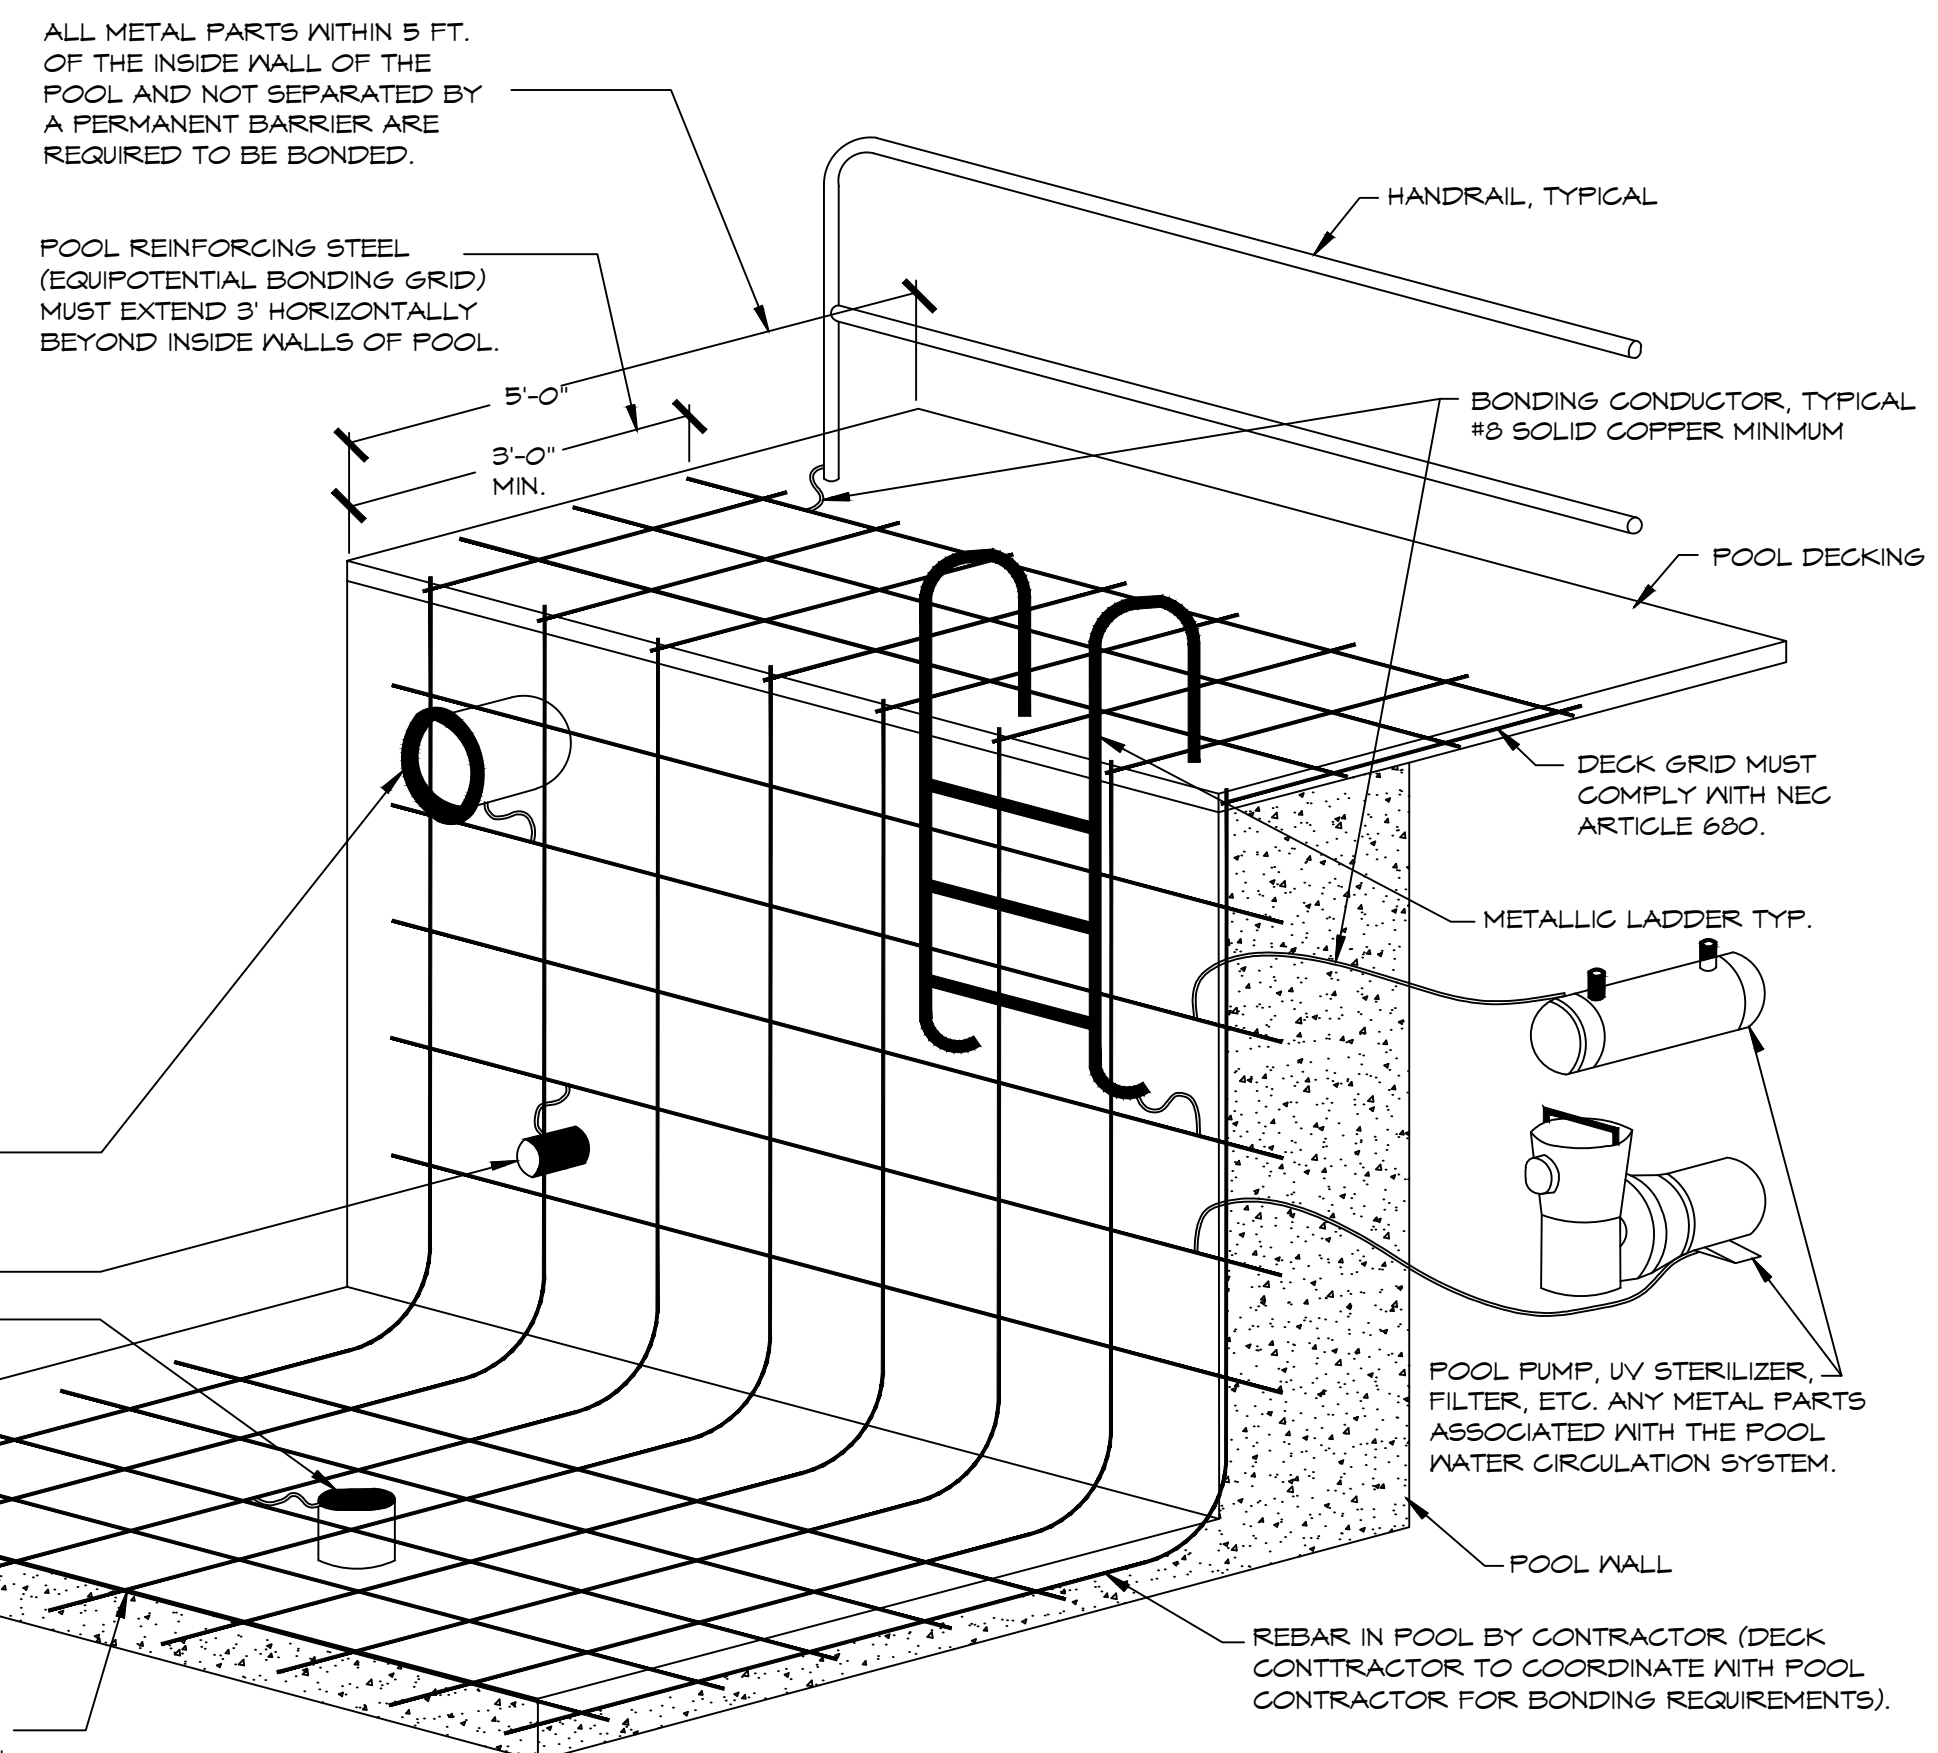

A DETAIL
SCALE: N.T.S.
SECTION

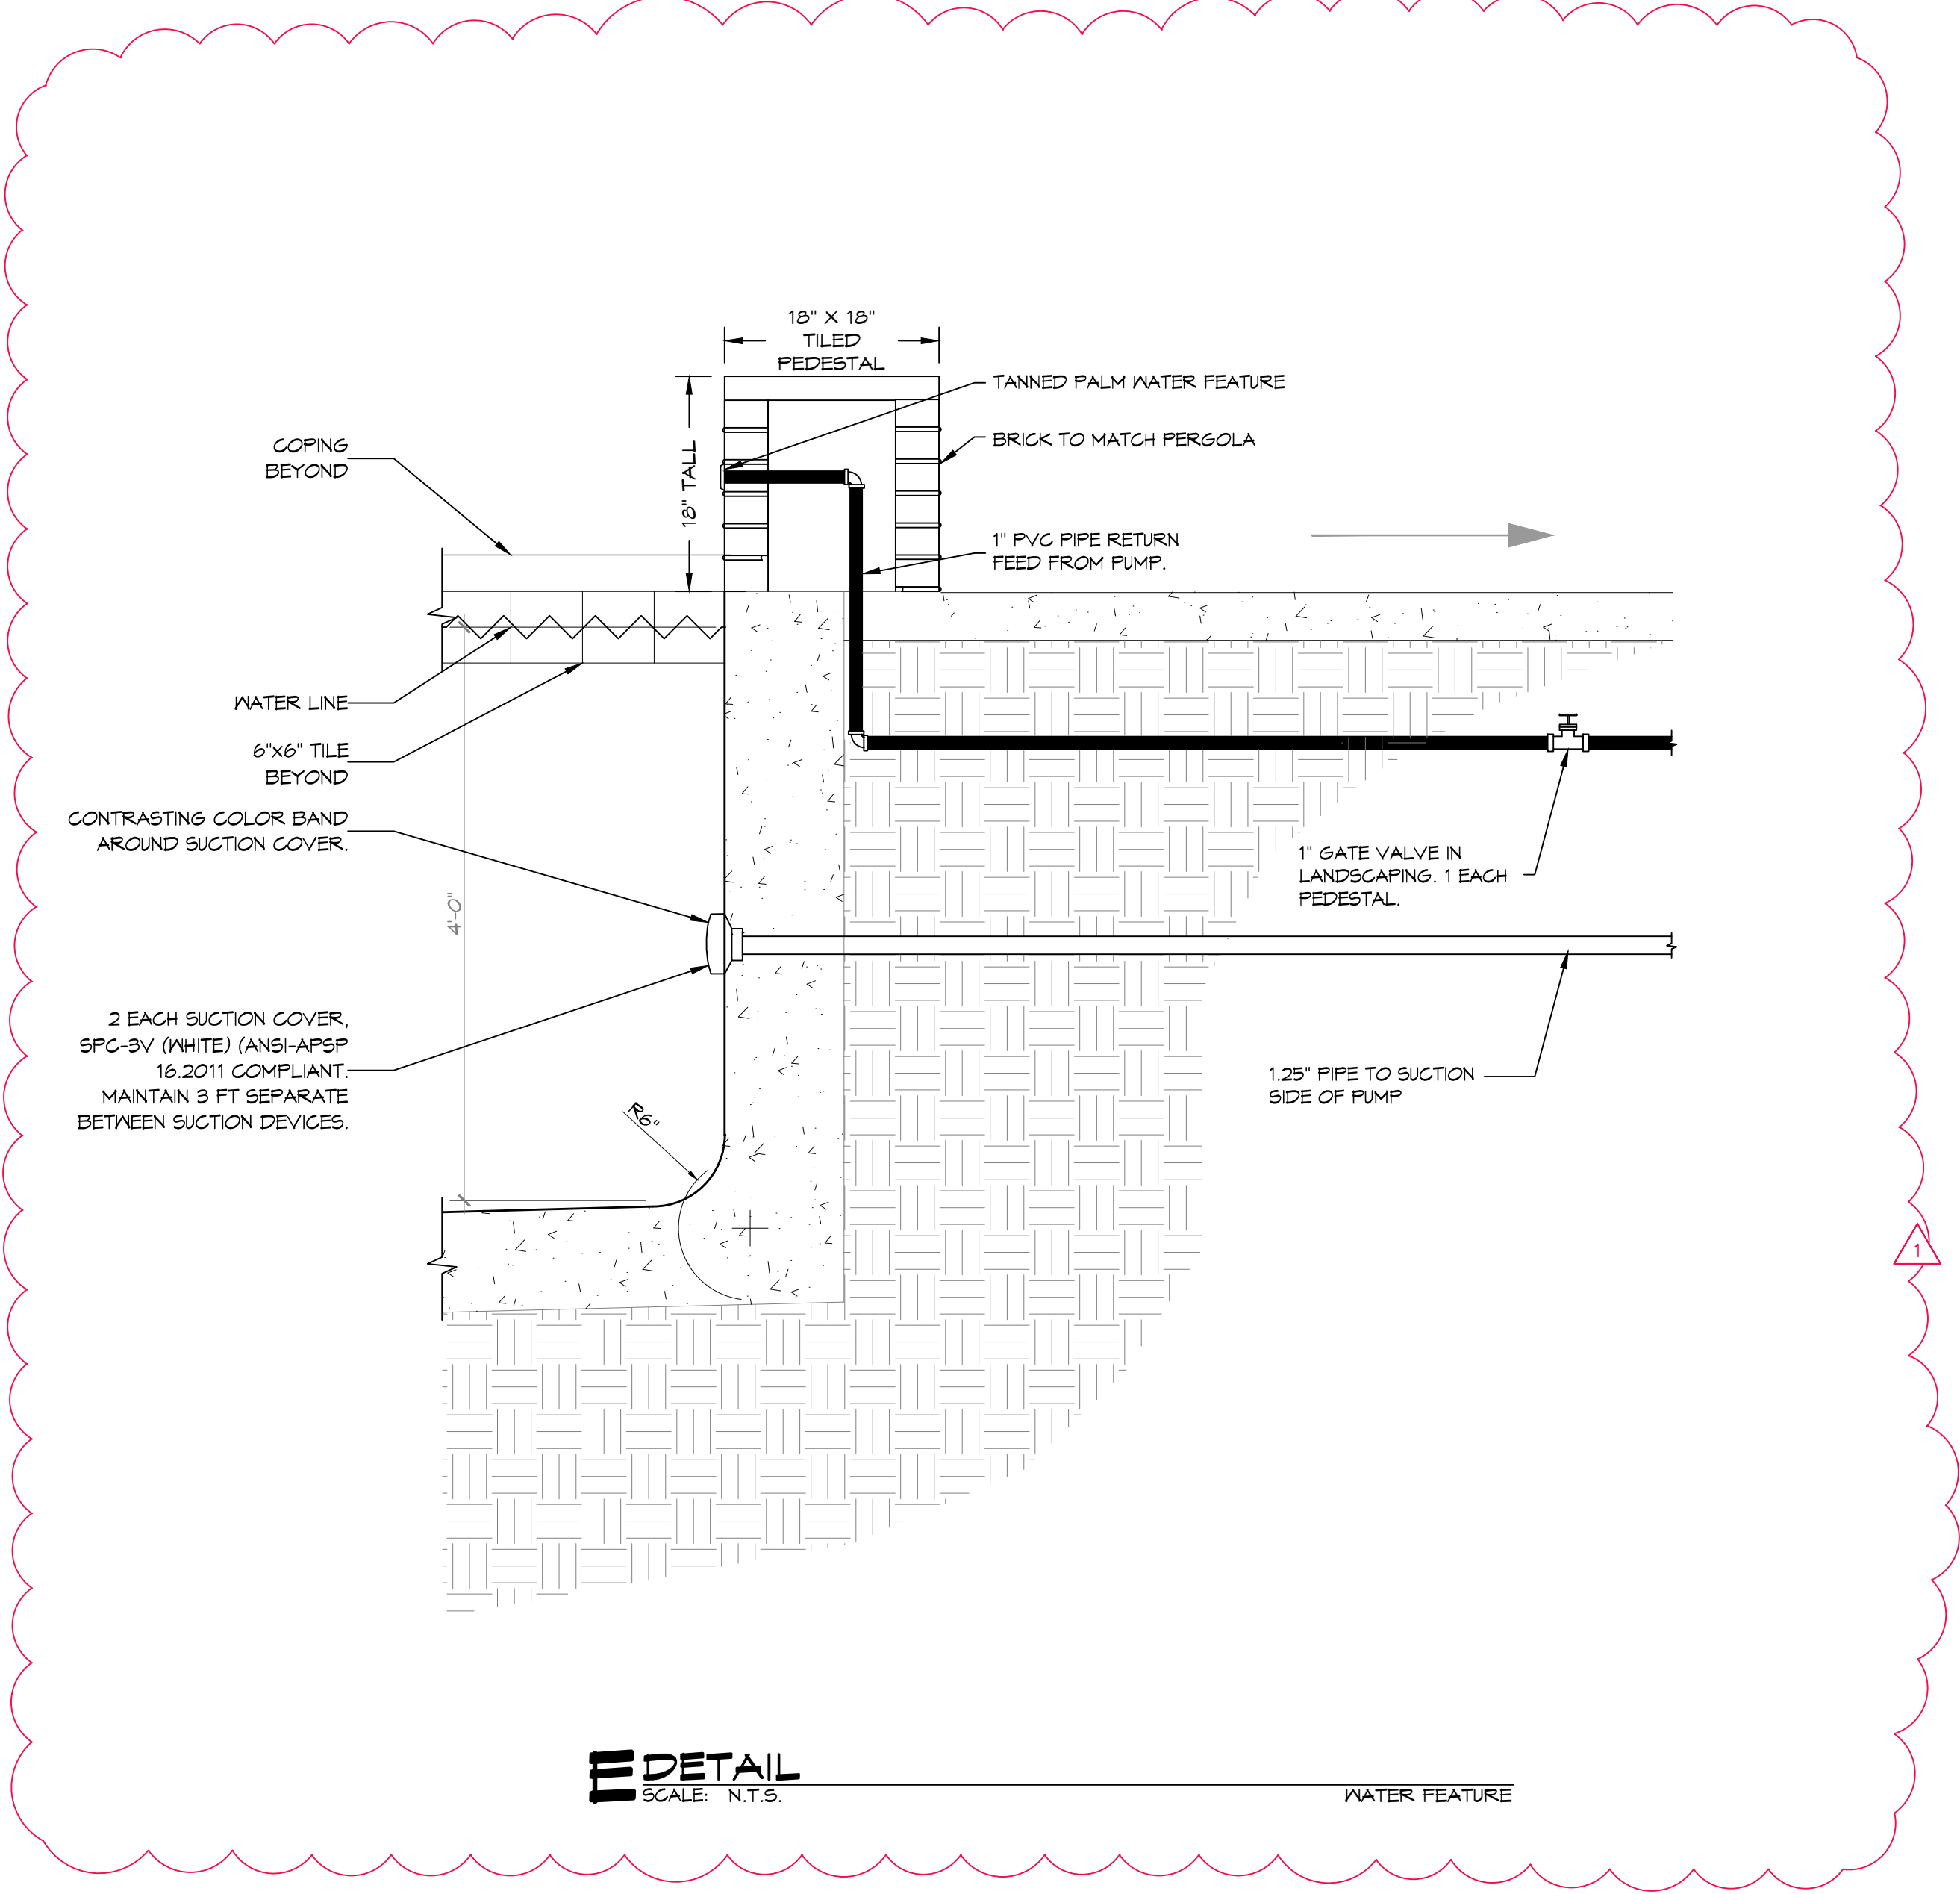

E DETAIL
SCALE: N.T.S.
WATER FEATURE

DAMMON ENGINEERING, INC.
LOUISIANA & MISSISSIPPI

Chief Engineer: Brian Mistic, PE
www.dammonengineering.com
info@dammon.com
554 Old Spanish Trail
Slidell, LA 70488
PH: 985.649.5832

REVISIONS	DATE
1 Revised Water Feature Detail	3/16/2018

SEAL:

NEW POOL
TERRABELLA POOL


SHEET TITLE:
Details

DRAWING NUMBER:
PL-2.1

SHEET No: 4 of 6