POOL ACCENT LIGHTING LEGEND

QTY	DESCRIPTION
1	LIGHTING - THIS DESIGN IS BASED ON INTELLIBRITE 5G LARGE 120V 55W LIGHTING (EQUIVALENT TO 500 W). SUITABLE SUBSTITUTES ARE ACCEPTABLE IF THE LED OR FIBER-OPTICS FIXTURE(S) ARE SPECIFICALLY MANUFACTURED FOR INSTALLATION IN A POOL, DESIGNED FOR UNDERWATER POOL USE AND HAVE A UL LISTING FOR SUCH OPERATION. EACH FIXTURE SHALL OPERATE AT LOW VOLTAGE AND SHOULD DRAW NOT MORE THAN 100 WATTS EACH. EACH FIXTURE SHALL BE CAPABLE OF LIGHTING A MINIMUM OF EIGHTEEN (18) FEET OF WATER (THROW DISTANCE). EACH FIXTURE NICHE SHALL BE CONSTRUCTED OF STAINLESS STEEL AISI 316 HOUSING AND SUPPORT HARDWARE. EACH FIXTURE SHALL BE WARRANTED FOR A PERIOD OF 2 YEARS.
6	INTELLIBRITE 5G LARGE 120V 55W LIGHTING
2	INTELLIBRITE 5G SMALL 120V 18W LIGHTING

POOL EQUIPMENT LEGEND

QTY	DESCRIPTION
2	PENTAIR TRITON TR100 FIBERGLASS SAND FILTER W/PRESSURE GAUGE & HI FLOW BACKWASH VALVE
2	PENTAIR SUPERFLO 1 HP PUMP
1	PENTAIR SUPERFLO 1/2 HP PUMP OPERATING AT LOW SPEED
2	F-30200P BLUE-WHITE 2.0" PVC PIPE IMPACT FLOW METER
2	PENTAIR RAINBOW CHLORINATOR MODEL #300
1	POOL MISER - WATER LEVEL CONTROLLER
2	AUTOMATED pH CONTROLLER; HAYWARD HCC 1000
7	SURFACE SKIMMER; HAYWARD SP10712
4	MAIN DRAIN SUMP AND GRATE ASSEMBLY; WATERWAY 674-2510 & 640-1817 or OTHER ASSEMBLY(S) THAT MEETS VGB REQUIREMENTS ANSI-APSP 16.2011
2	SIDEWALL DRAIN FOR WATER FEATURE; AQUASTAR 6" ROUND HOCKEY PUCK SUMPLESS SUCTION OUTLET COVER or OTHER ASSEMBLY(S) THAT MEETS VGB REQUIREMENTS ANSI-APSP 16.2011
8	1" DIRECTIONAL EYEBALL RETURN; HAYWARD SP1419E & SP10225
10	TRUE-UNION BALL VALVES FOR PIPE SIZES 2"
2	TRUE-UNION BALL VALVES FOR PIPE SIZES 2-1/2"
	SCH 40 PVC PIPE FOR ALL SUCTION, RETURN, AND EQUIPMENT PIPING
1	GLOBAL SUPERIOR S-3505A LIFT
1	TAYLOR TEST KIT K-2006 (DPD METHOD OF TESTING FOR CHLORINE RESIDUALS)
	6X6 DEPTH MARKERS, 4" BLACK LETTERING ON WHITE BACKGROUND (SLIP RESISTANT FINISH)
	6X6 INTERNATIONAL "NO DIVING" SYMBOL
	LIFE SAVING EQUIPMENT
1	12FT. LONG STRONG POLE WITH SHEPARD'S HOOK (LIFESAVING HOOK)
1	60 FT. THROWING ROPE AND RING BUOY
1	TELEPHONE WITH POSTED EMERGENCY NAMES AND NUMBERS.

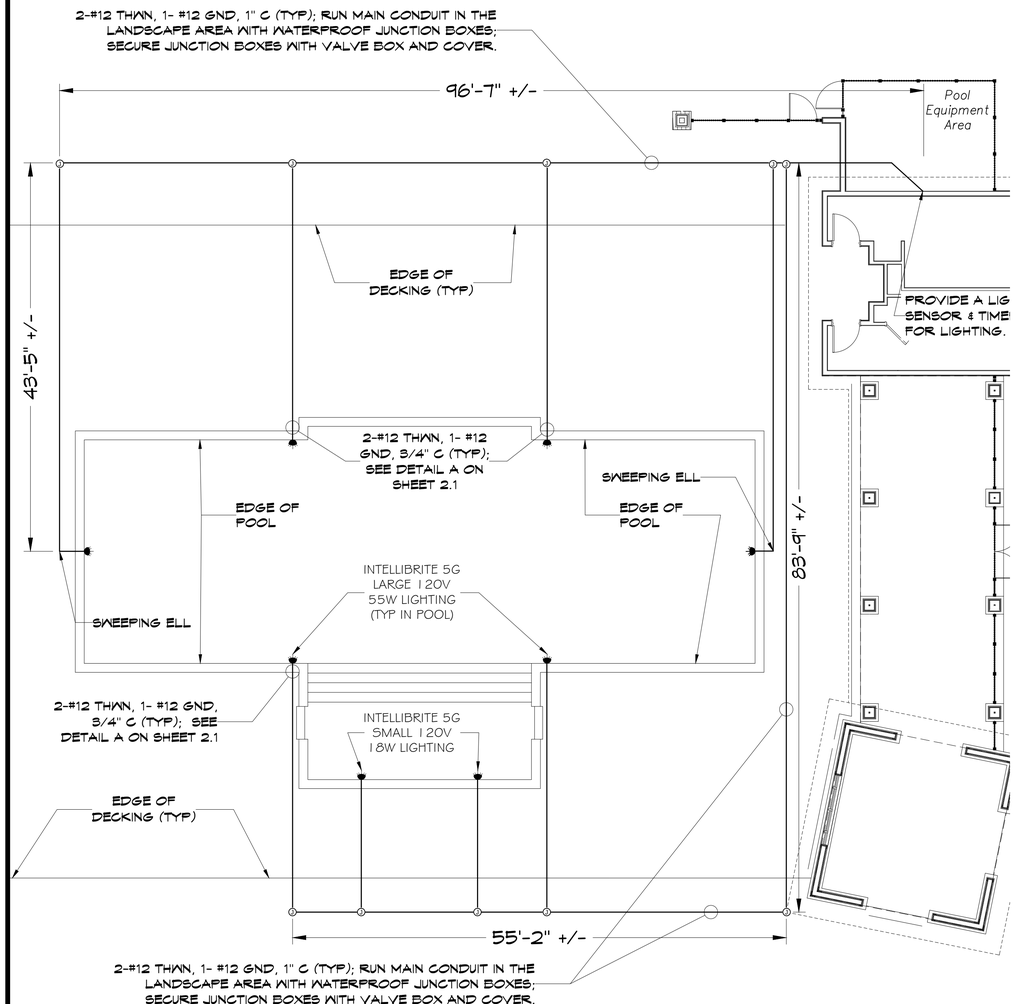

2 POOL LIGHTING PLAN
SCALE: 1/8" = 1'-0"

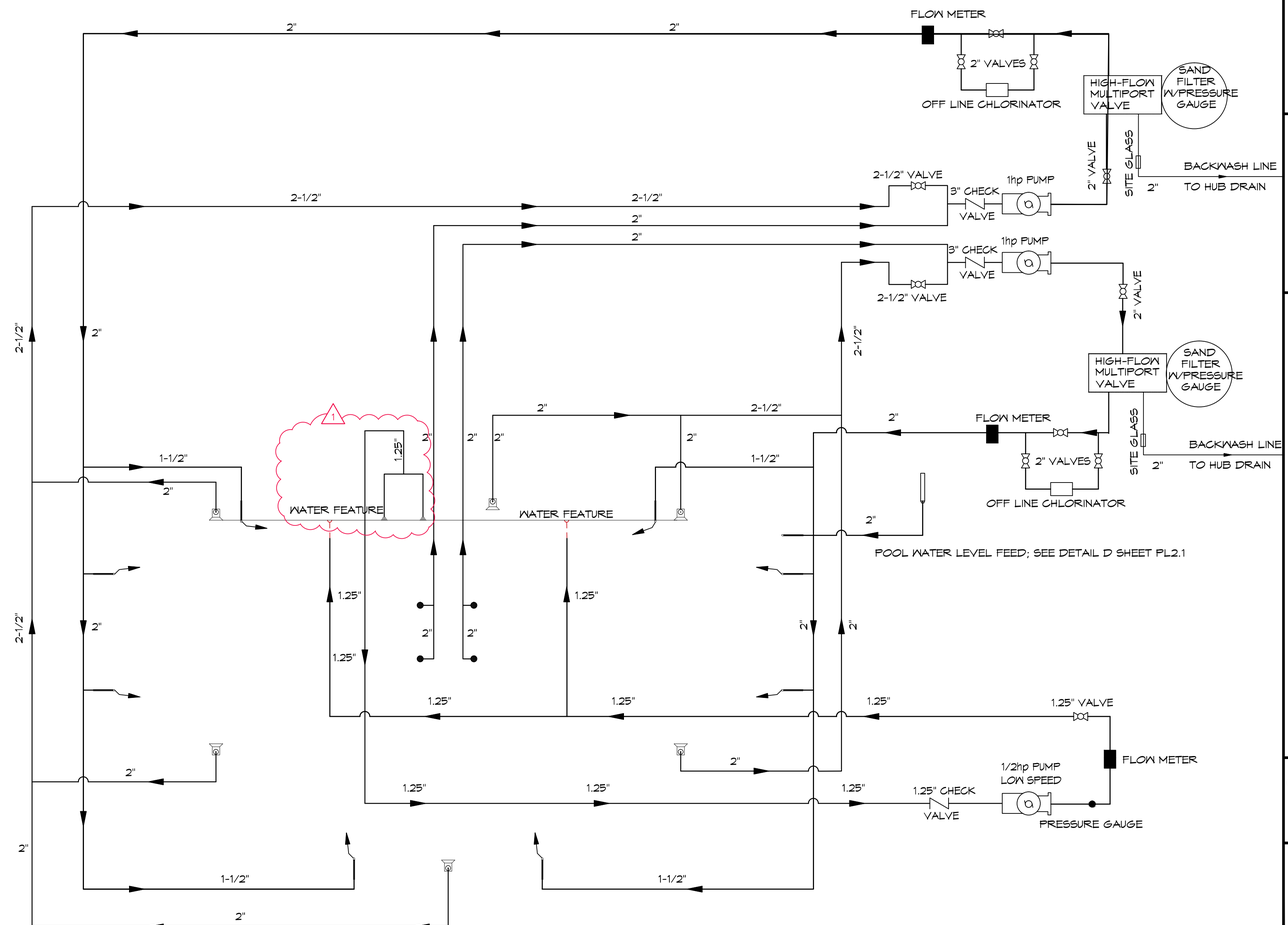

1 POOL ONE-LINE DIAGRAM
SCALE: 1/8" = 1'-0"

DAMMON ENGINEERING, INC.
LOUISIANA & MISSISSIPPI
www.dammonengineering.com
info@dammonengineering.com
PH: 985.649.5832
Chief Engineer: Brian Mistich, PE
554 Old Spanish Trail
Slidell, LA 70458

REVISIONS

#	DESCRIPTION	DATE
1	Revised Water Feature Suction	3/16/2018

SEAL:
STATE OF LOUISIANA
BRIAN A. MISTICH
License No. 30187
3/16/2018
PROFESSIONAL ENGINEER

NEW POOL
TERRABELLA POOL

JOB No: 2356 | DATE: 1/24/2018
DRAWN BY: DPD | CHECKED BY: BM

The plans, drawings and specifications, the ideas and designs incorporated therein as an instrument of service, are and shall remain the property of Dammon Engineering, Inc. and shall not be used in whole or in part for any other project without the written permission of Dammon Engineering, Inc. The visual contact with these plans shall constitute prima facie evidence of the acceptance of these restrictions. Any unauthorized use of these plans and specifications will be at the user's sole risk and without liability to Dammon Engineering, Inc. and the user shall indemnify and hold harmless Dammon Engineering, Inc. from all claims, damages, losses and expenses including attorney's fees arising out of or resulting therefrom.

SHEET TITLE:
ONE-LINE DIAGRAMS

DRAWING NUMBER:
PL-3.2

SHEET No: 6 of 6