


### 4 CHALLENGER HI-FLOW PUMP CURVE

SCALE: N.T.S.

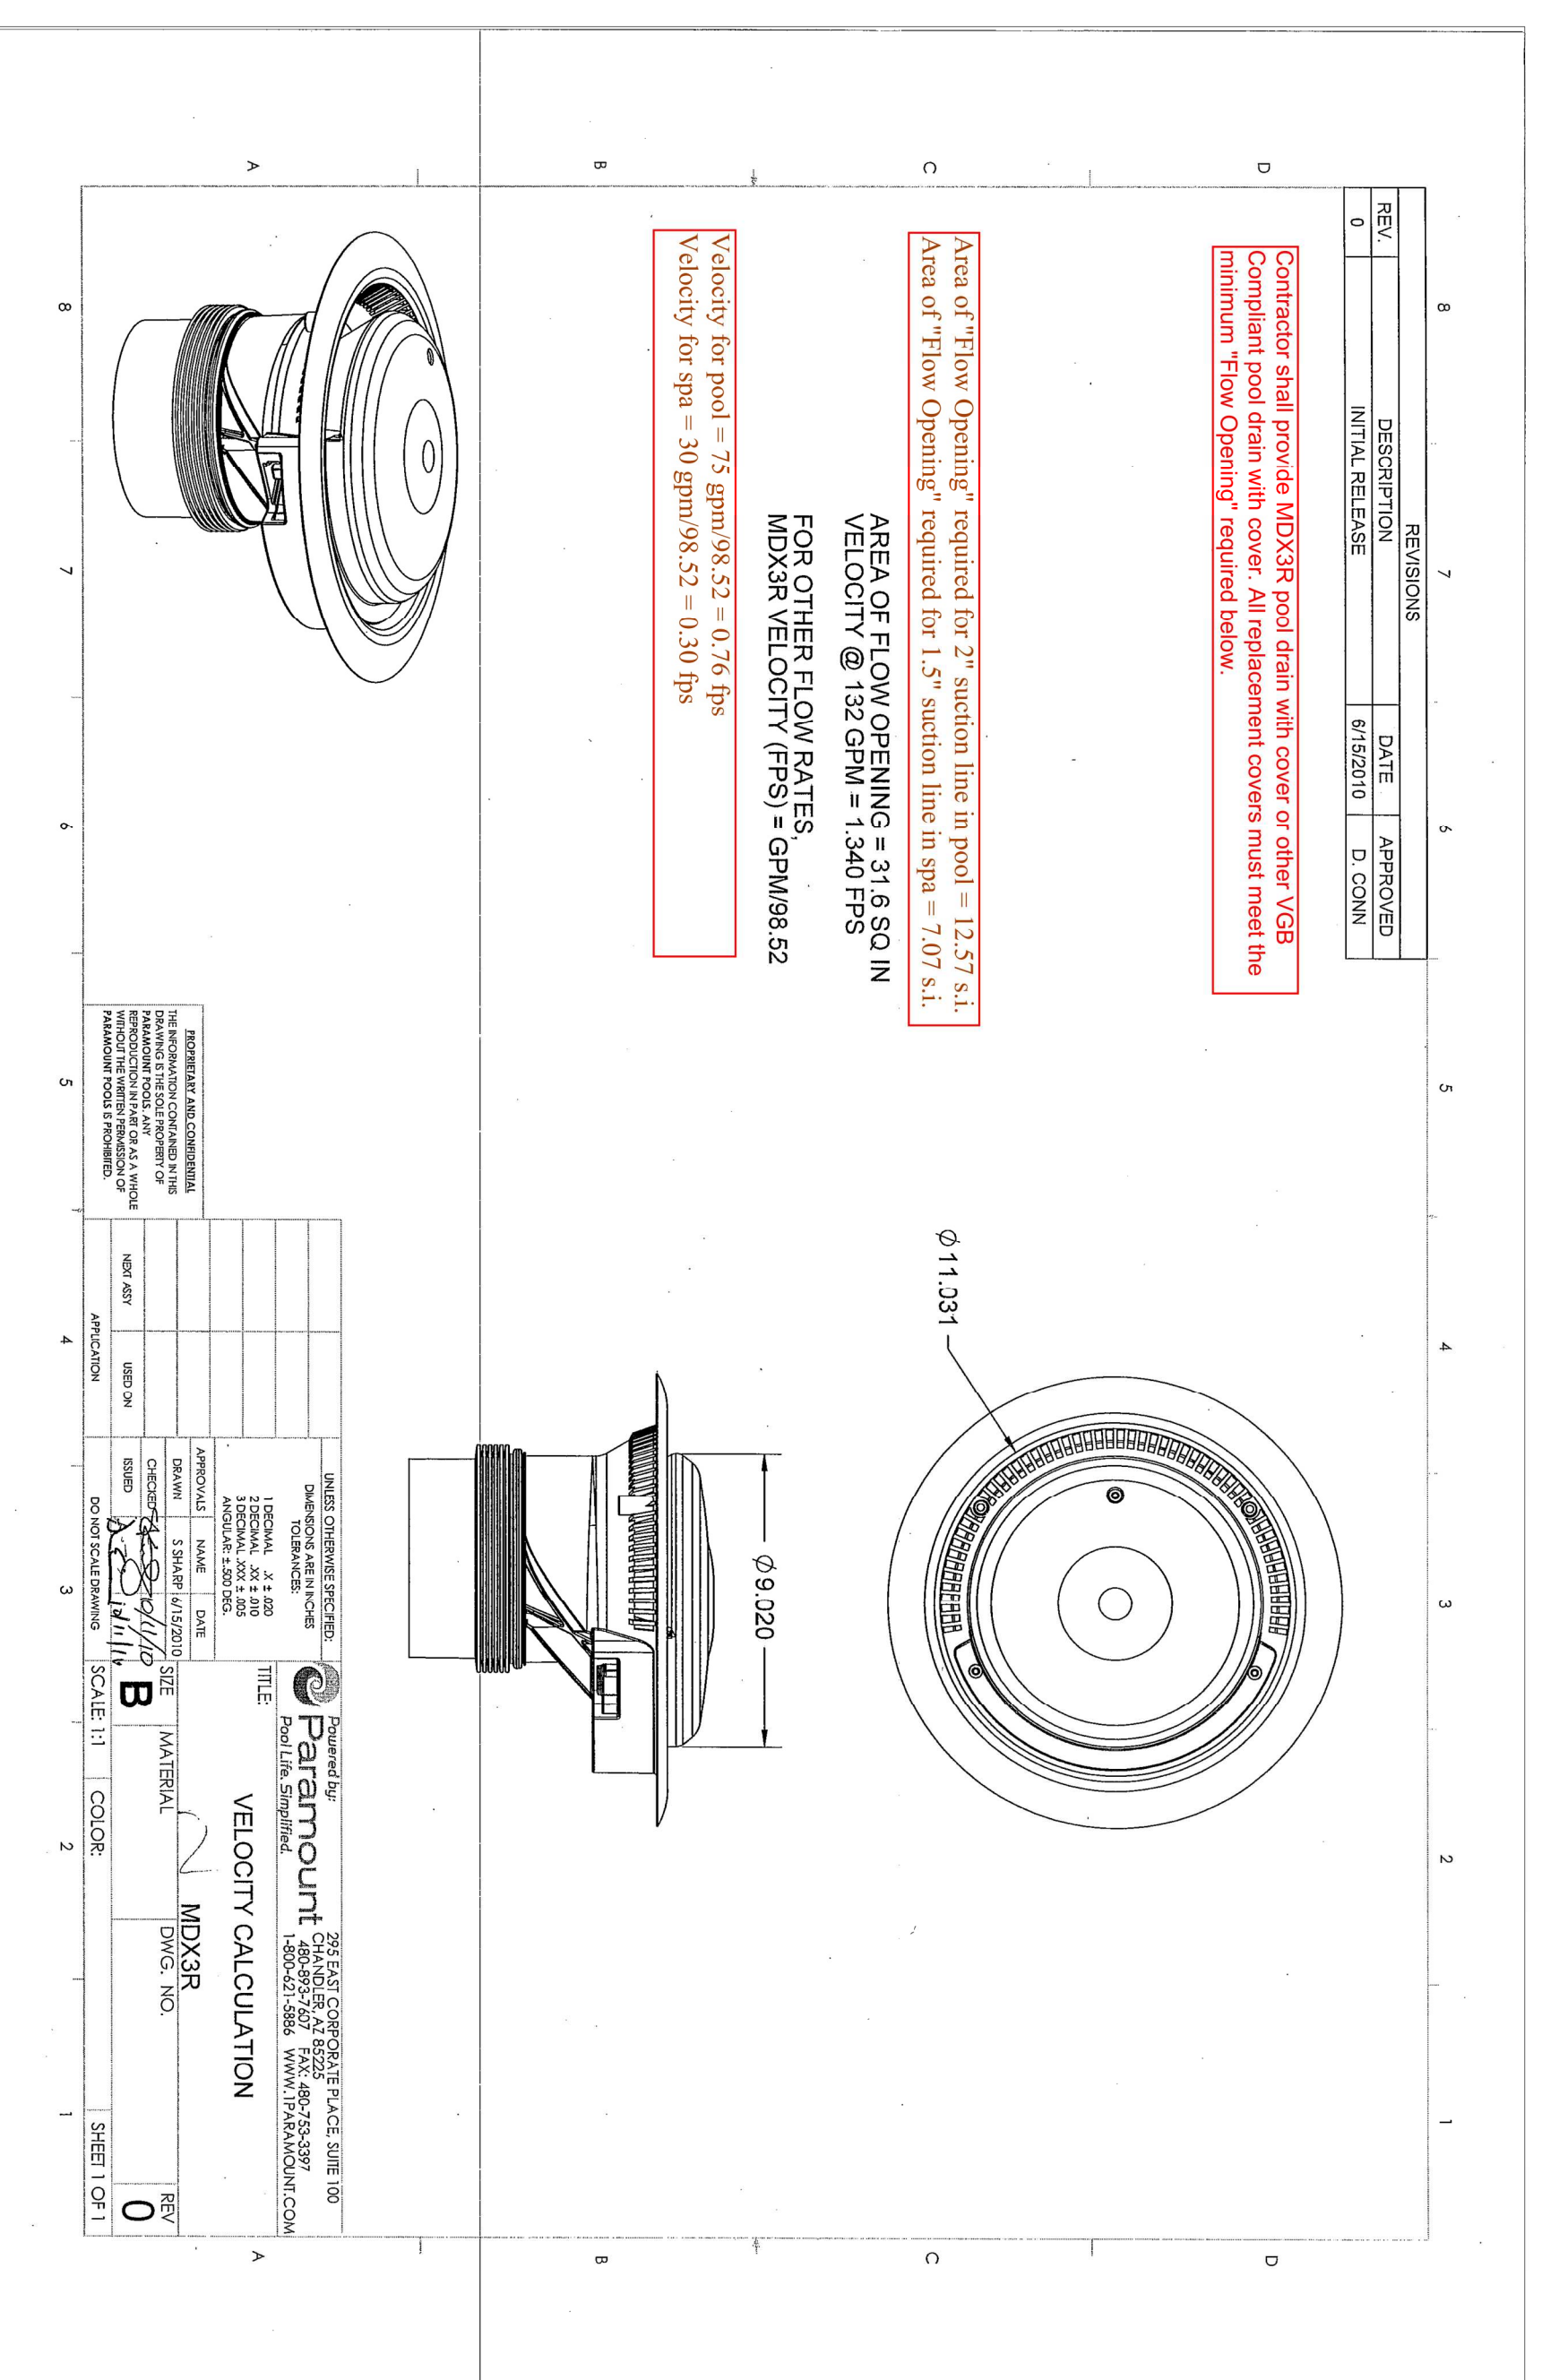

### POOL EQUIPMENT LEGEND

QTY	DESCRIPTION
1	CHALLENGER HP HI-FLOW PUMP
1	MAIN DRAIN SUMP AND GRATE ASSEMBLY
1	2" FLOW METER
1	2" FLOW METER
1	CHLORINATOR, JANDY MODEL 700
3	3/4" DIRECTIONAL EYEBALL
1	BALL VALVES FOR PIPE SIZE 2"
1	2" SCH 40 PIG PIPE FOR ALL SUCTION, RETURN, AND EQUIPMENT ROOM PIPING
1	STAINLESS STEEL LADDER (SEE METHODS OF TESTING FOR CHLORINE RESISTANT)
1	6"x6" WATERLINE TILE (SEE HARDSCAPE PLAN FOR COLOR AND STYLE)
1	2"x2" KEYSTONE TILE FOR STEPS AND UNDERWATER BENCHES (SEE HARDSCAPE PLAN)
1	WHITE PLASTER