




*BAM*

Lot 25

126.2ft

57' 3"


52'

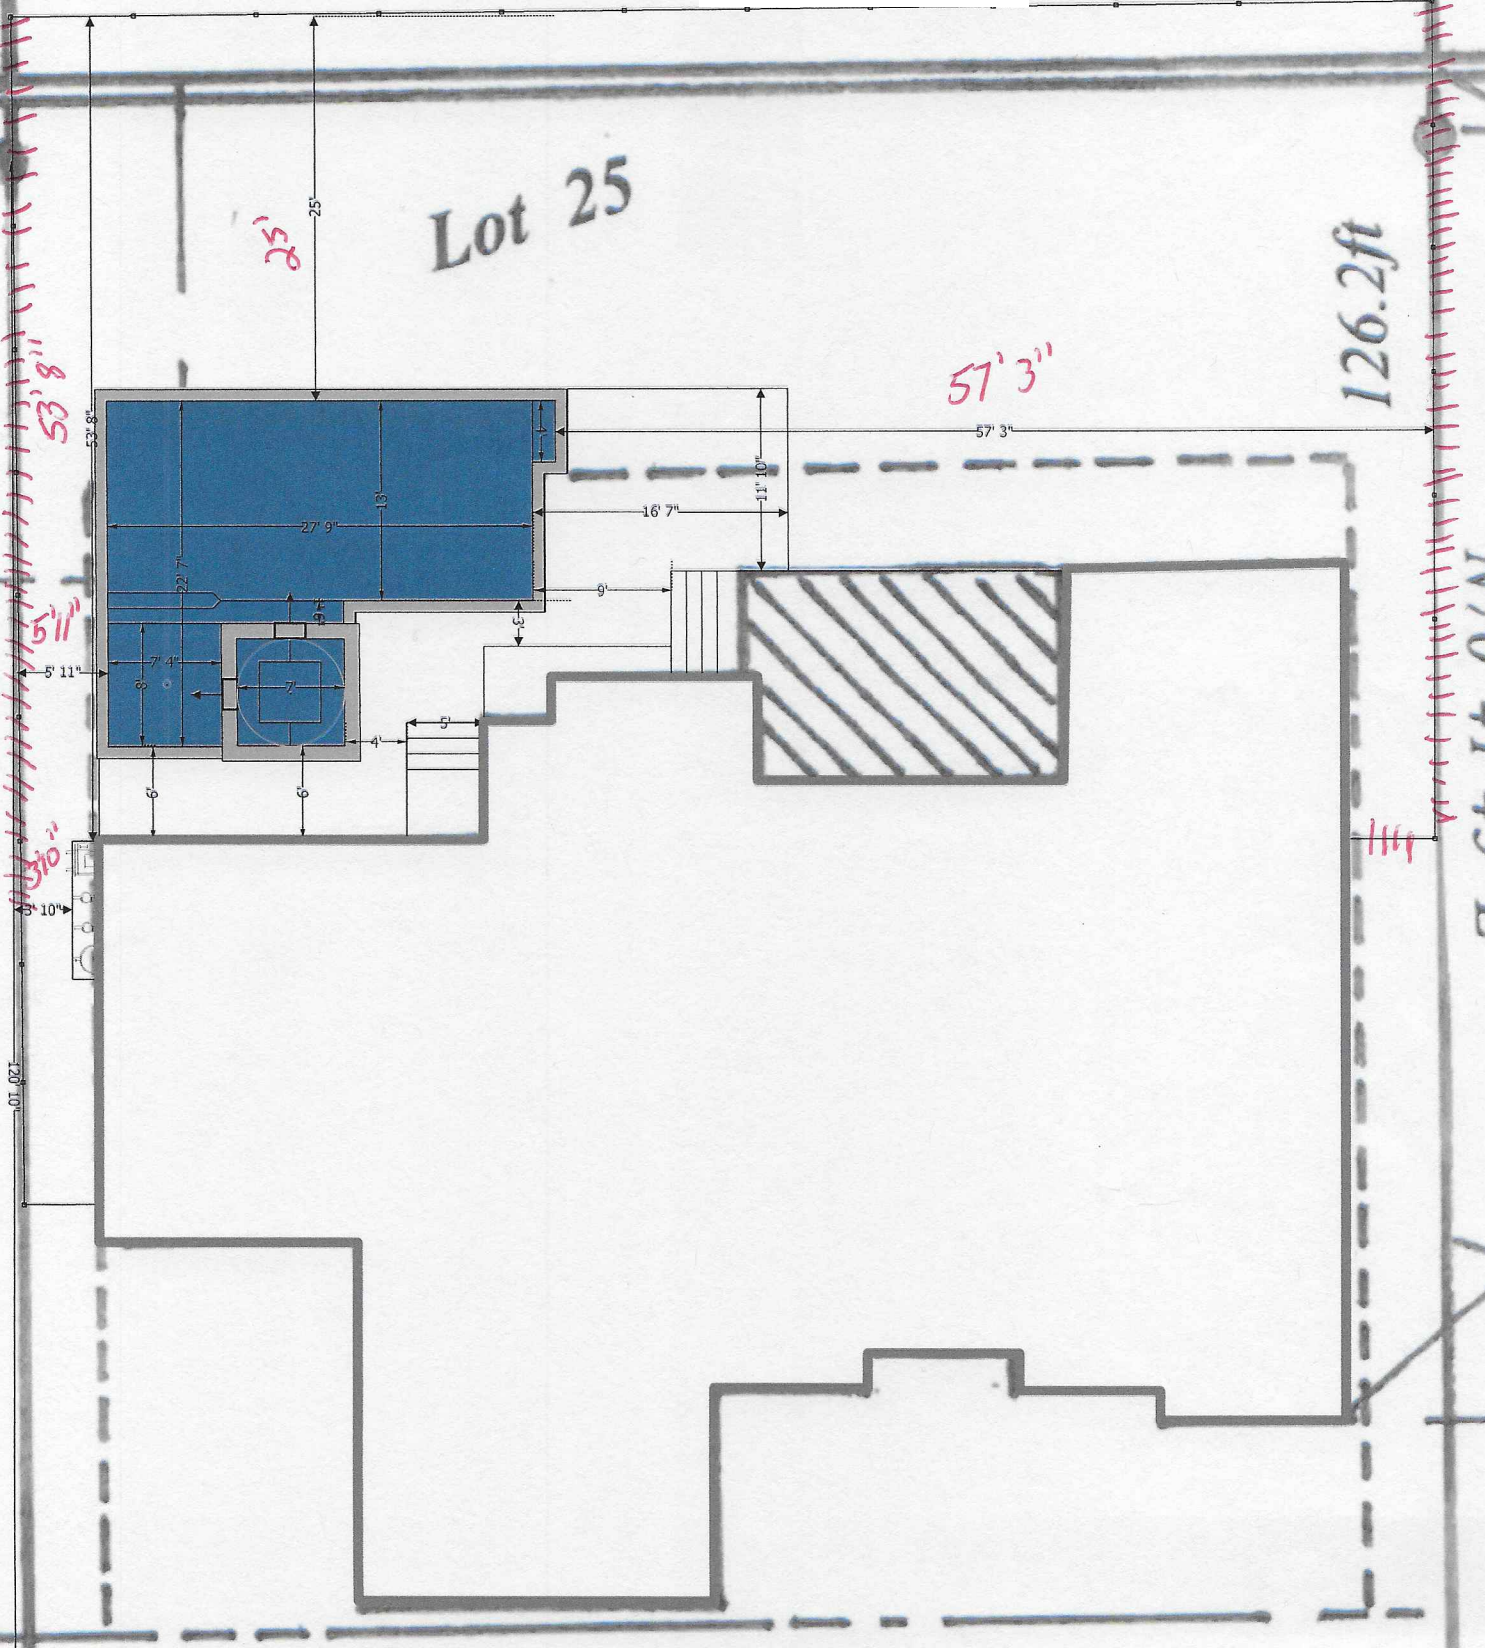

U C 4 1 4 0 / A



Lot 25

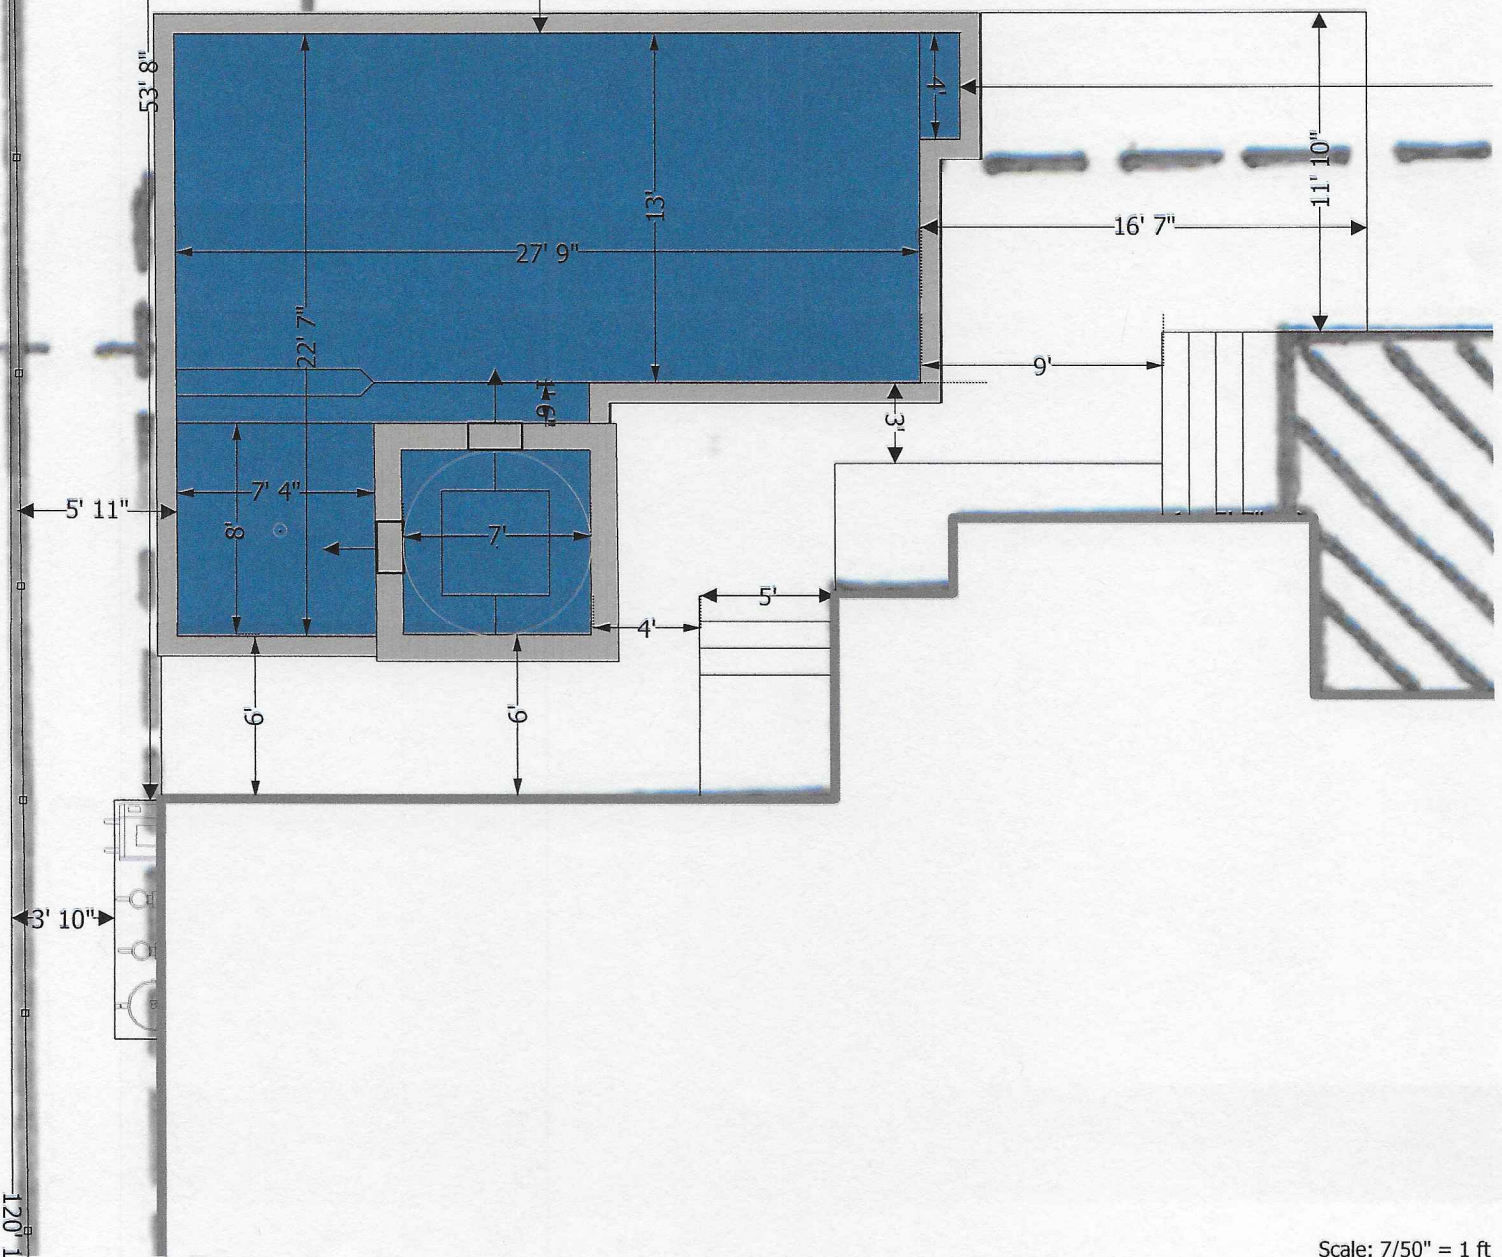

Scale: 7/50" = 1 ft

