


Steps

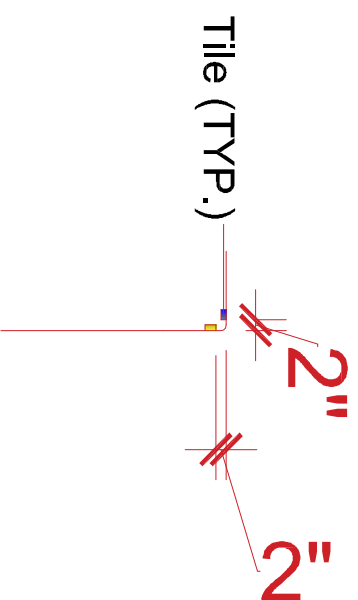

Bench