POOL EQUIPMENT LEGEND

QTY	DESCRIPTION
1	JANDY CL 340 CARTRIGE FILTER WITH PRESSURE GAUGE
1	PENTAIR SUPERFLO 3/4 HP PUMP
1	F-30200P BLUE-WHITE 2.0" PVC PIPE IMPACT FLOW METER WITH OPTIONAL FLOW SENSOR F300S
1	PENTAIR RAINBOW CHLORINATOR MODEL #300
1	LEVELOR - WATER LEVEL CONTROLLER MODEL K-1100
2	TRUE-UNION BALL VALVES FOR PIPE SIZE 3" AND SMALLER
1	6HPHA105 AQUASTAR 6INCH ROUND HOCKEY PUCK FLOOR DRAIN ASSEMBLY
	SCH 80 PVC PIPE FOR ALL SUCTION, RETURN, AND EQUIPMENT ROOM PIPING
1	HAYWARD SP1084; AUTOMATIC SURFACE SKIMMER
2	WATERWAY 640-3600V; SUCTION ASSEMBLY WITH SPC-3V VGB COMPLIANT COVER
2	AQUA STAR 1020TST01 RETURN INLETS USING ANGLE WALL ADAPTER
2	AQUA STAR 1020TST01 RETURN INLET WITHOUT EYEBALL FOR WATER LEVEL CONTROLLER
2	1.90" O.D. HANDRAIL DMS-102B DECK MOUNTED
1	TAYLOR TEST KIT K-2006 (DPD METHOD OF TESTING FOR CHLORINE RESIDUALS)
	6X6 DEPTH MARKERS, 4" BLACK LETTERING ON WHITE BACKGROUND (SLIP RESISTANT FINISH)
	6X6 INTERNATIONAL "NO DIVING" SYMBOL
	LIFE SAVING EQUIPMENT
1	12FT. LONG STRONG POLE WITH SHEPARD'S HOOK (LIFESAVING HOOK)
1	60 FT. THROWING ROPE AND RING BUOY
1	TELEPHONE WITH POSTED EMERGENCY NAMES AND NUMBERS.

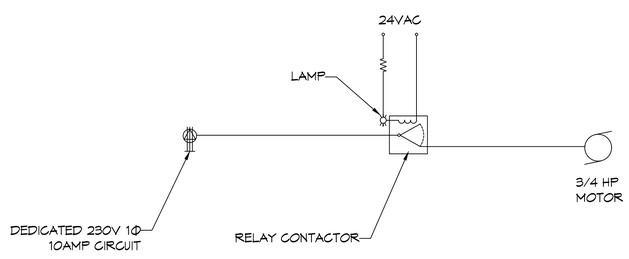

2 ELECTRICAL ONE-LINE DIAGRAM
SCALE: N.T.S.

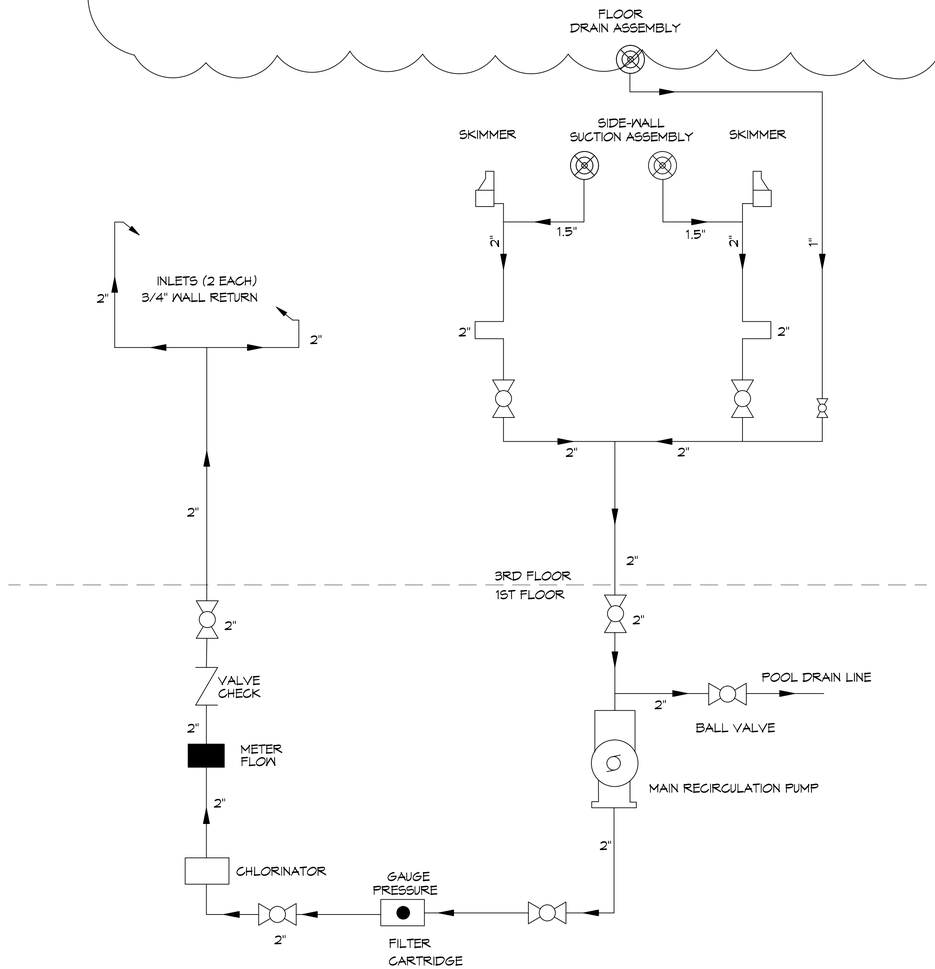

1 POOL PLUMBING ONE-LINE DIAGRAM
SCALE: N.T.S.

DAMMON ENGINEERING, INC.
LOUISIANA & MISSISSIPPI
www.dammonengineering.com
info@dammonengineering.com
PH: 985.649.5832
Chief Engineer: Brian Mistich, PE
554 Old Spanish Trail
Slidell, LA 70458

REVISIONS

#	DESCRIPTION	DATE
1	Revised Sidewall Drainage Piping	3/30/2017
2	Revised Floor Drain Assembly	4/13/2017

SEAL:

STATE OF LOUISIANA
BRIAN A. MISTICH
License No. 30187
4/13/2017
PROFESSIONAL ENGINEER

NEW POOL
WAX MUSEUM
CONDOS
917 Conti Street
New Orleans, Louisiana

JOB No: 2308 DATE: February 20, 2017
DRAWN BY: DPD CHECKED BY: BM

SHEET TITLE:
PLUMBING ONE-LINE DIAGRAMS

DRAWING NUMBER:
PL-3.1

SHEET No: 5 of 5