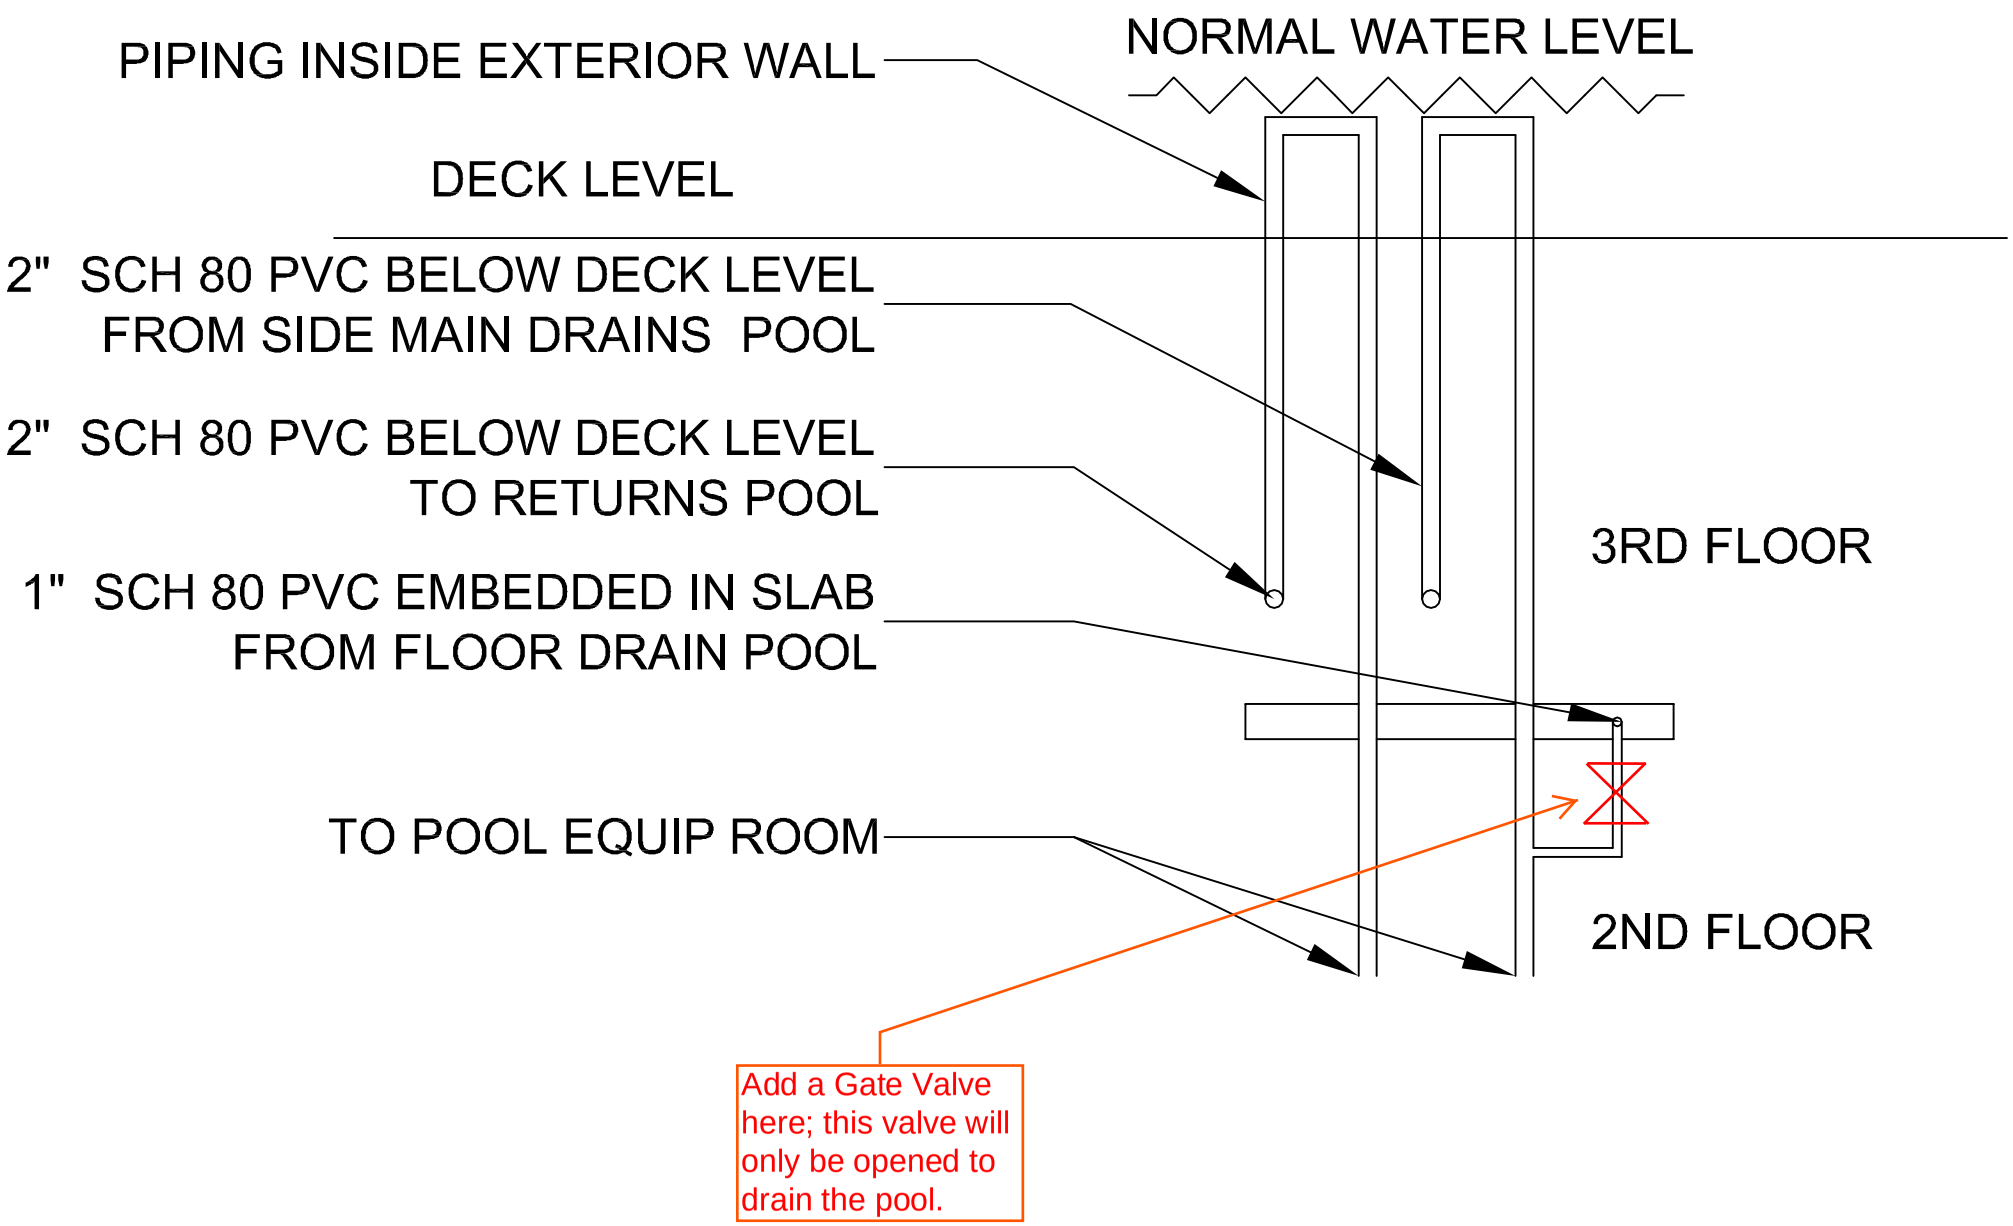
NORMAL WATER LEVEL
PIPING INSIDE EXTERIOR WALL
DECK LEVEL
2" SCH 80 PVC BELOW DECK LEVEL
FROM SIDE MAIN DRAINS POOL
2" SCH 80 PVC BELOW DECK LEVEL
TO RETURNS POOL
1" SCH 80 PVC EMBEDDED IN SLAB
FROM FLOOR DRAIN POOL
3RD FLOOR
TO POOL EQUIP ROOM
2ND FLOOR
Add a Gate Valve here; this valve will only be opened to drain the pool.