

LOT 8




LOTS 7A & 6A

LOT 5 A/K/A
PARCEL A

REFERENCE: SURVEY BY
J.V. BURKES &
ASSOCIATES, INC.
SURVEY NO. 1020729
DATED: 3/20/2002

REFERENCE: SURVEY BY
JOHN E. BONNEAU
SURVEY NO. 88070
DATED: 2/29/1988

REFERENCE: SURVEY BY
J.V. BURKES &
ASSOCIATES, INC.
SURVEY NO. 1044625
DATED: 12/22/2004

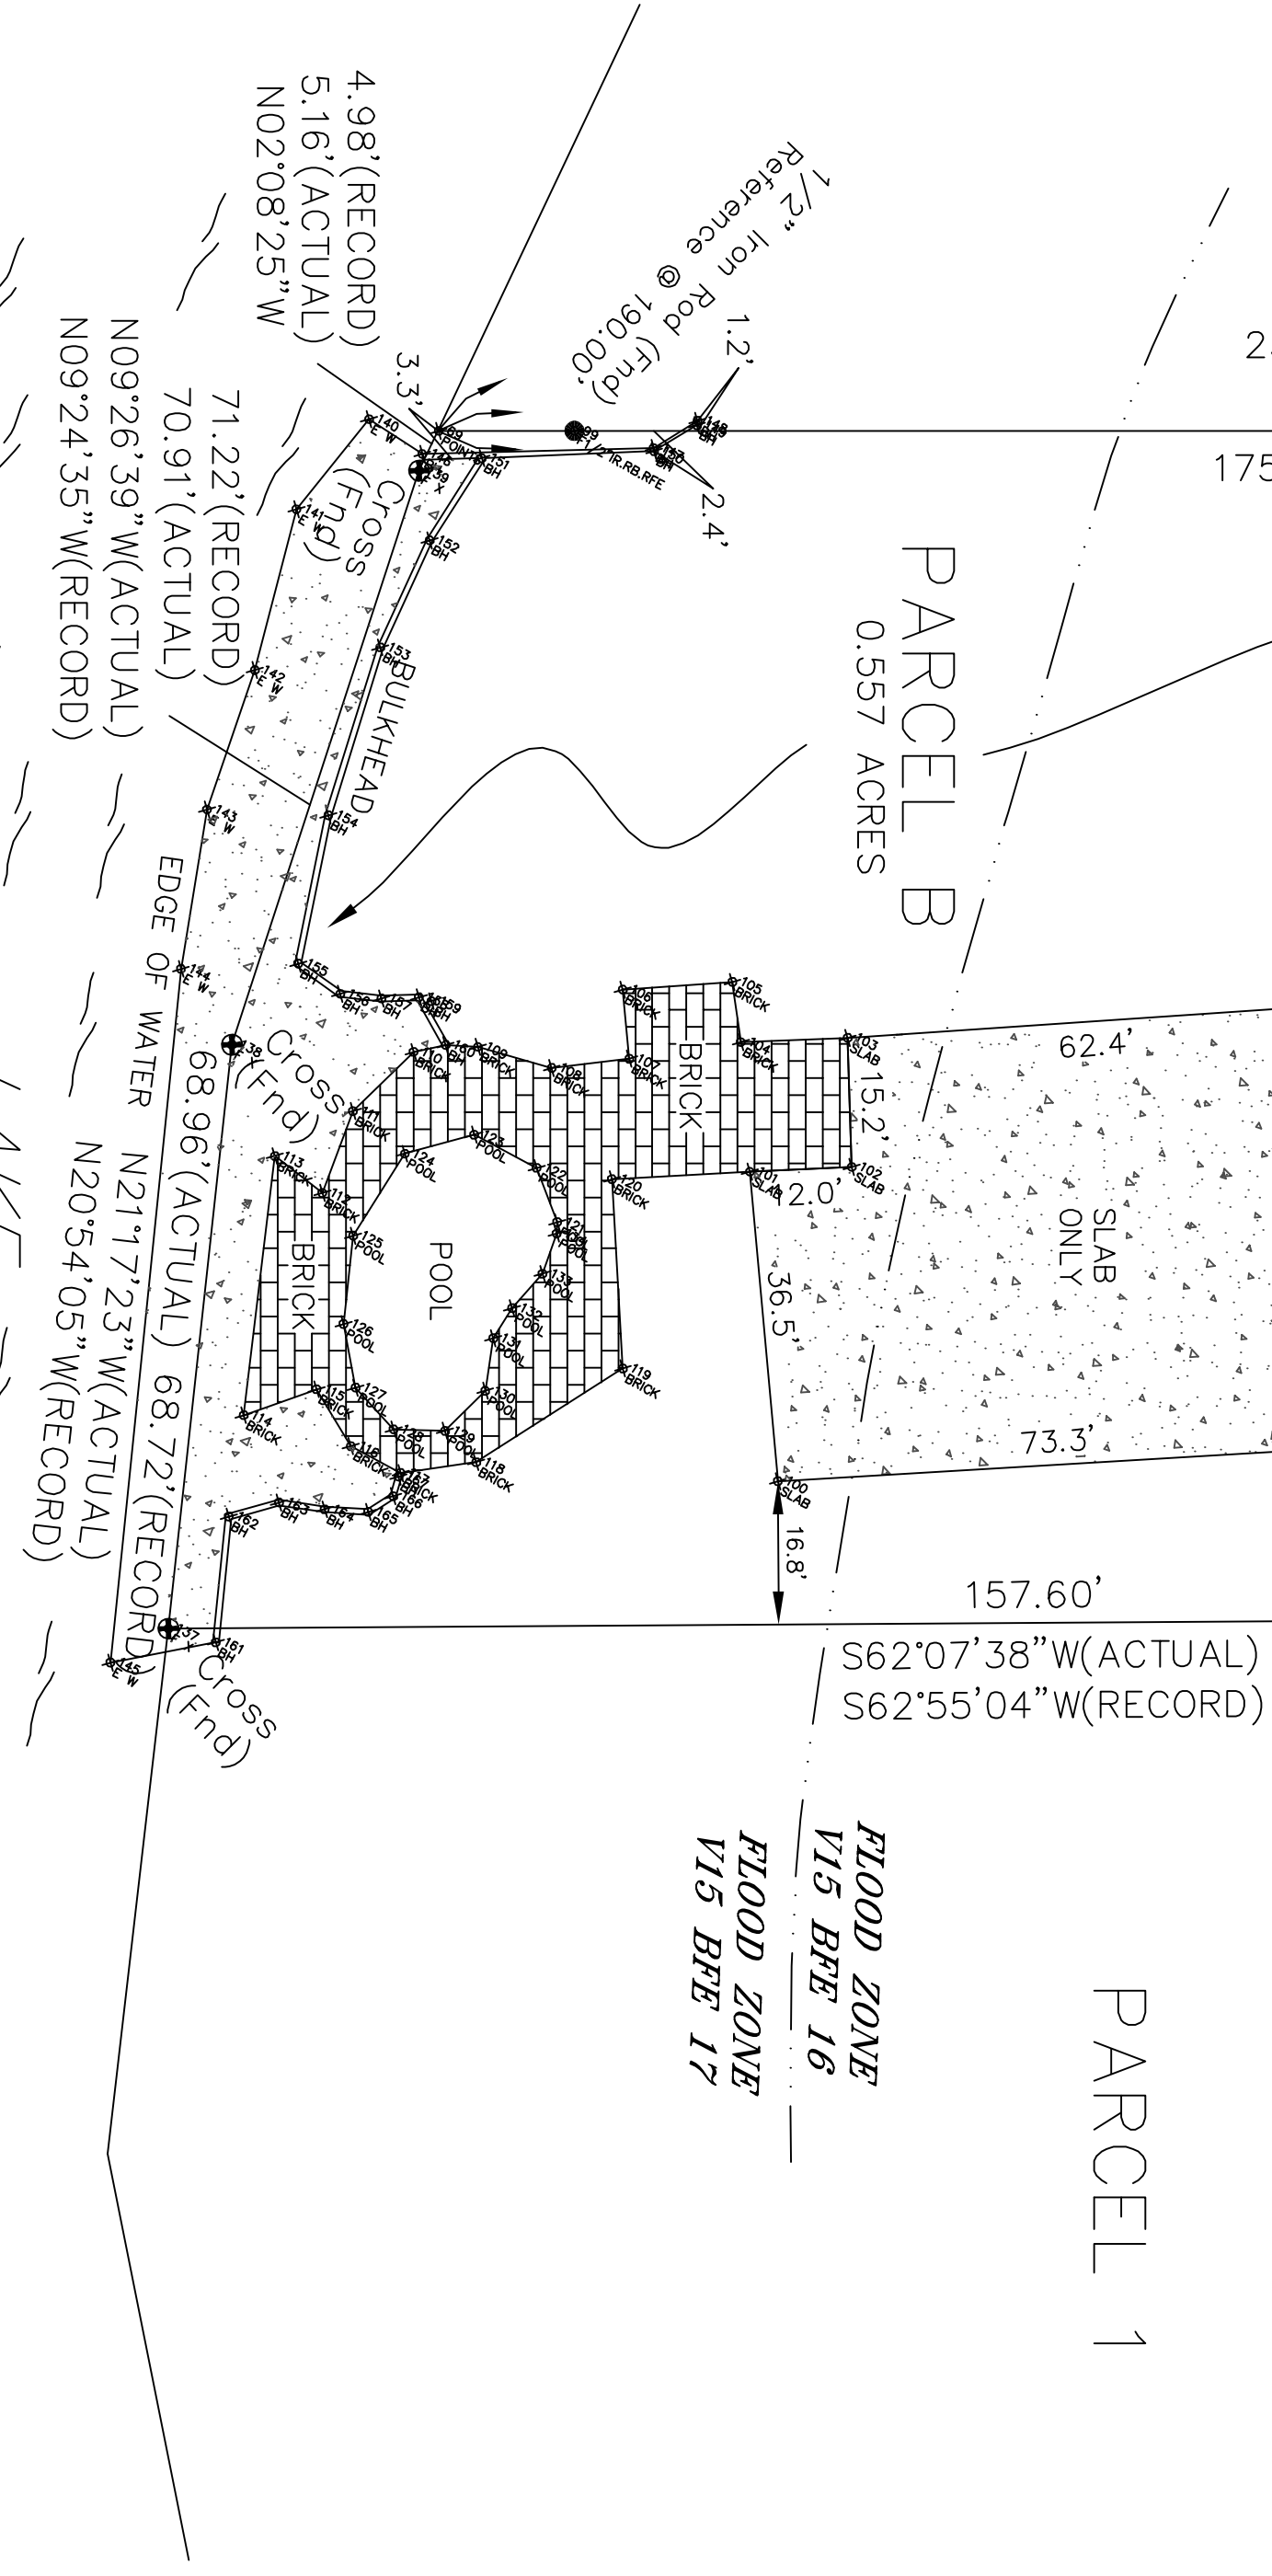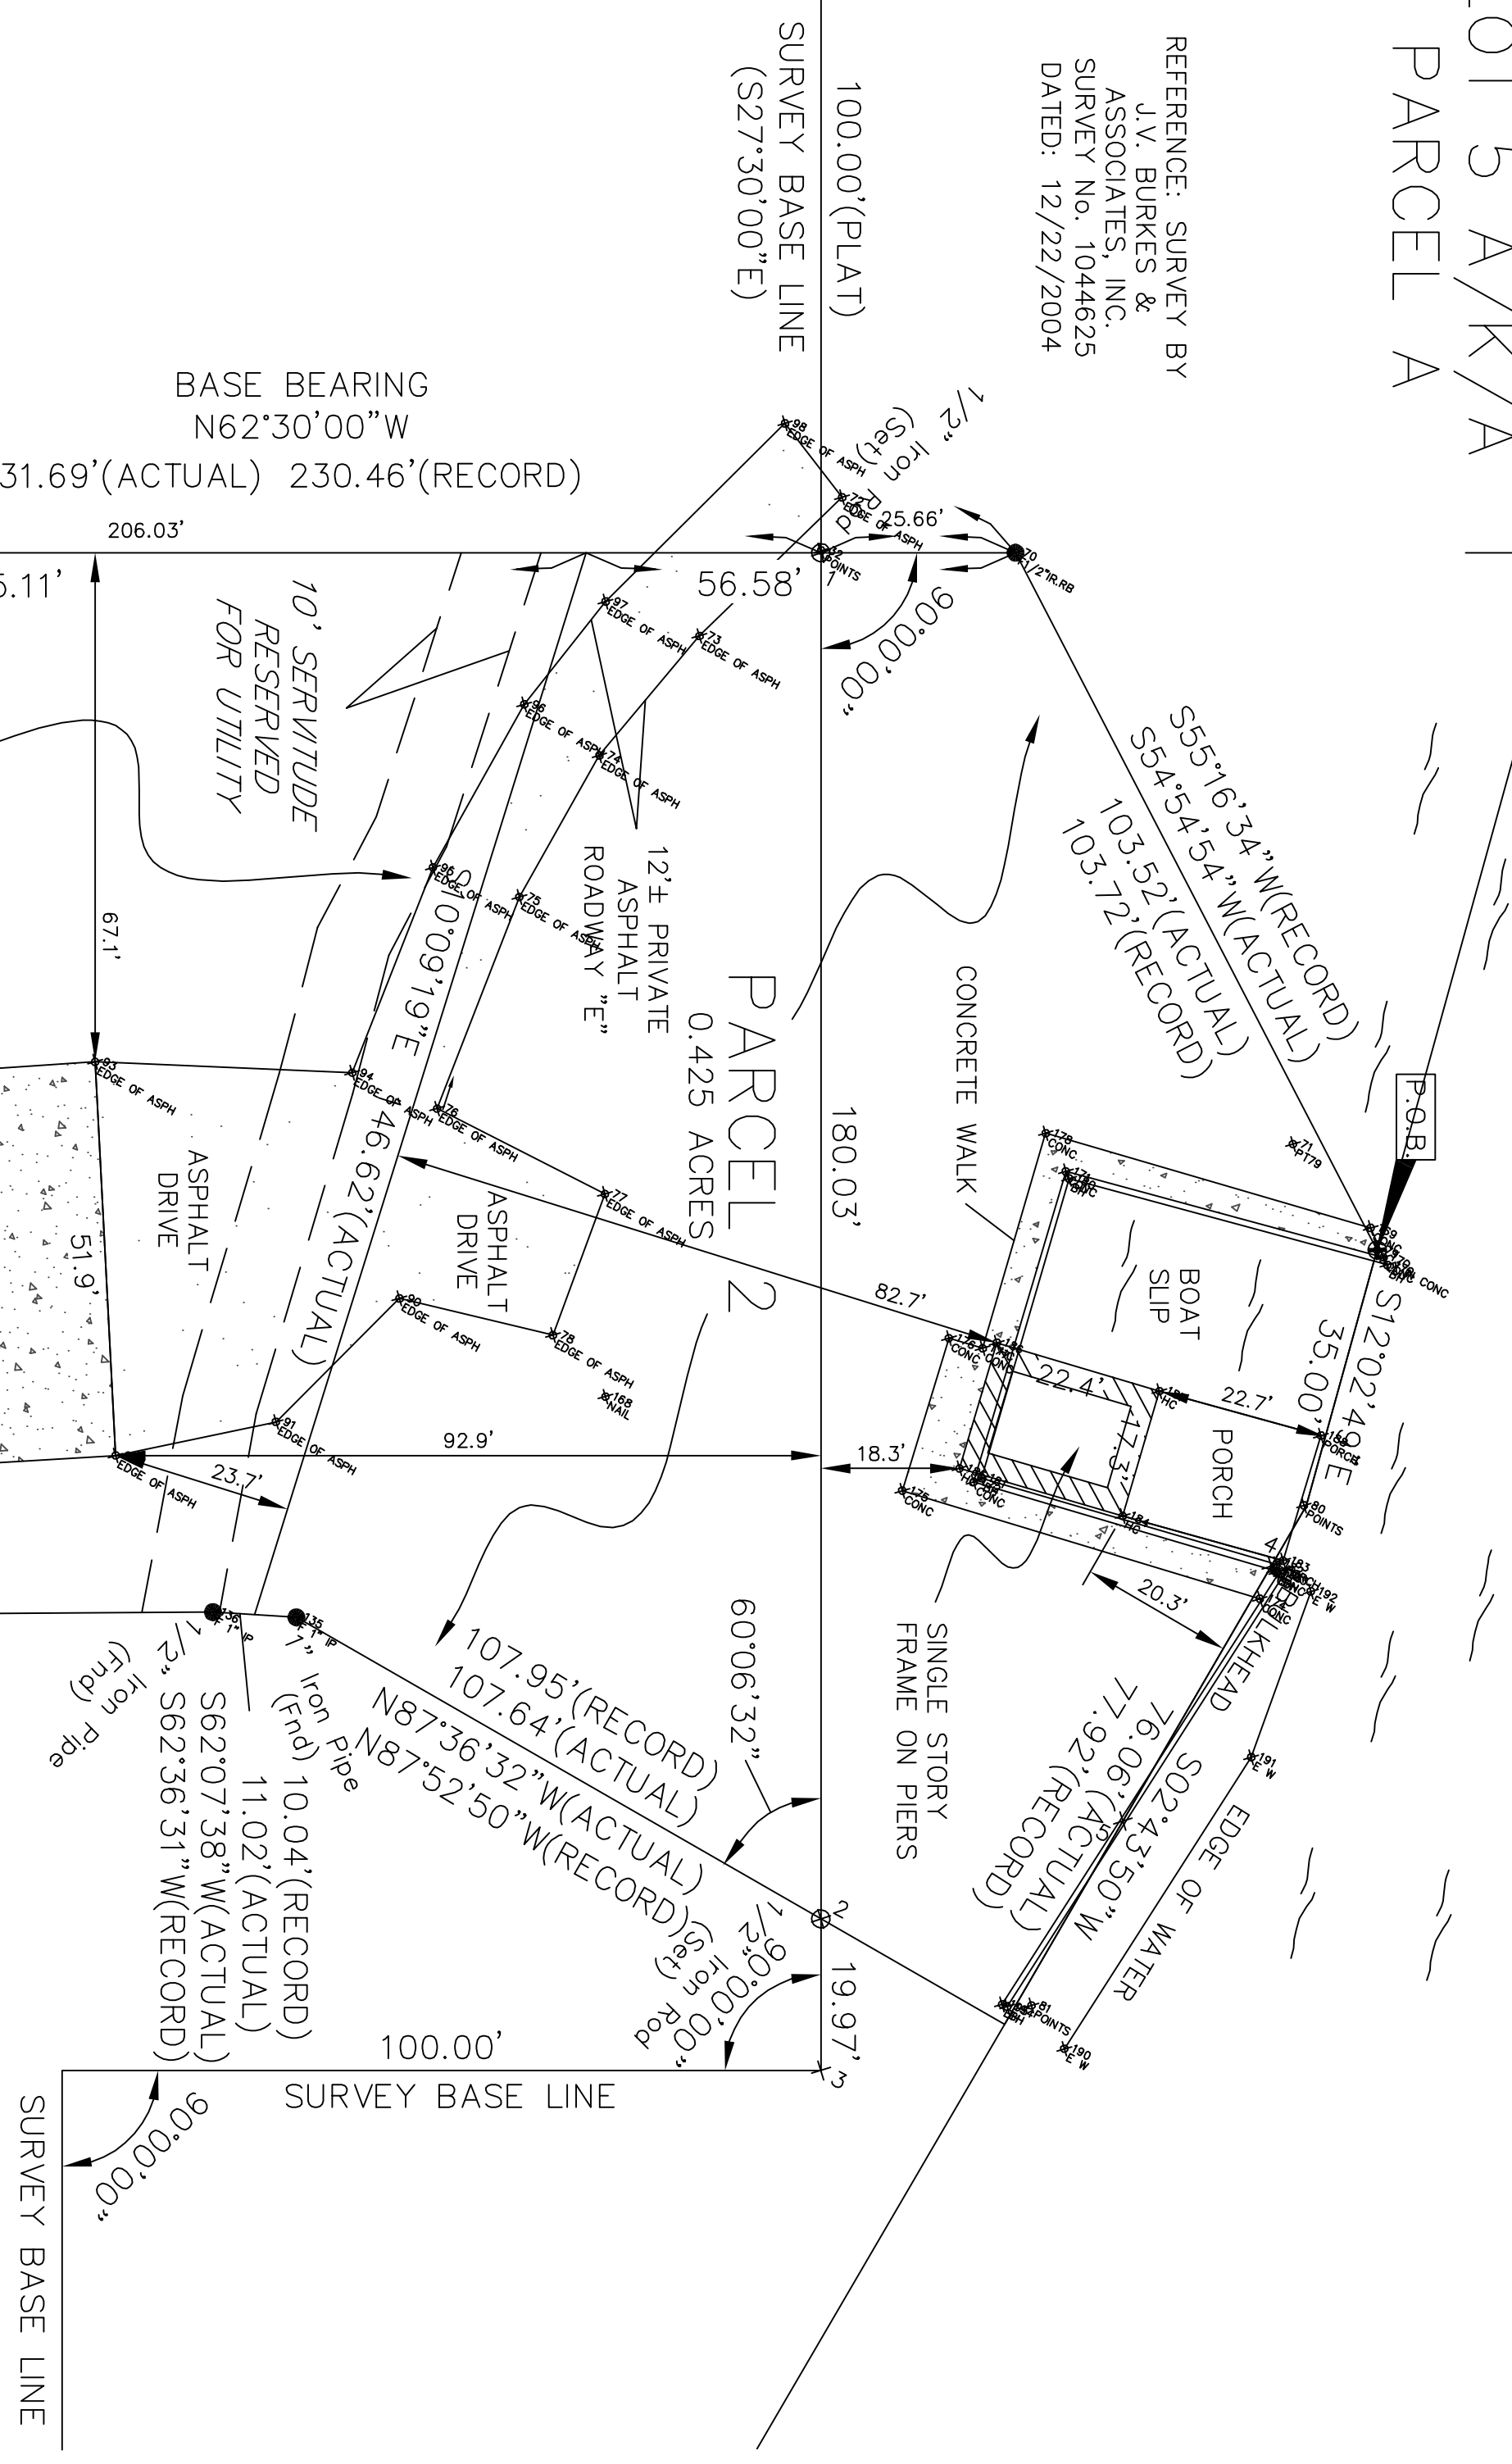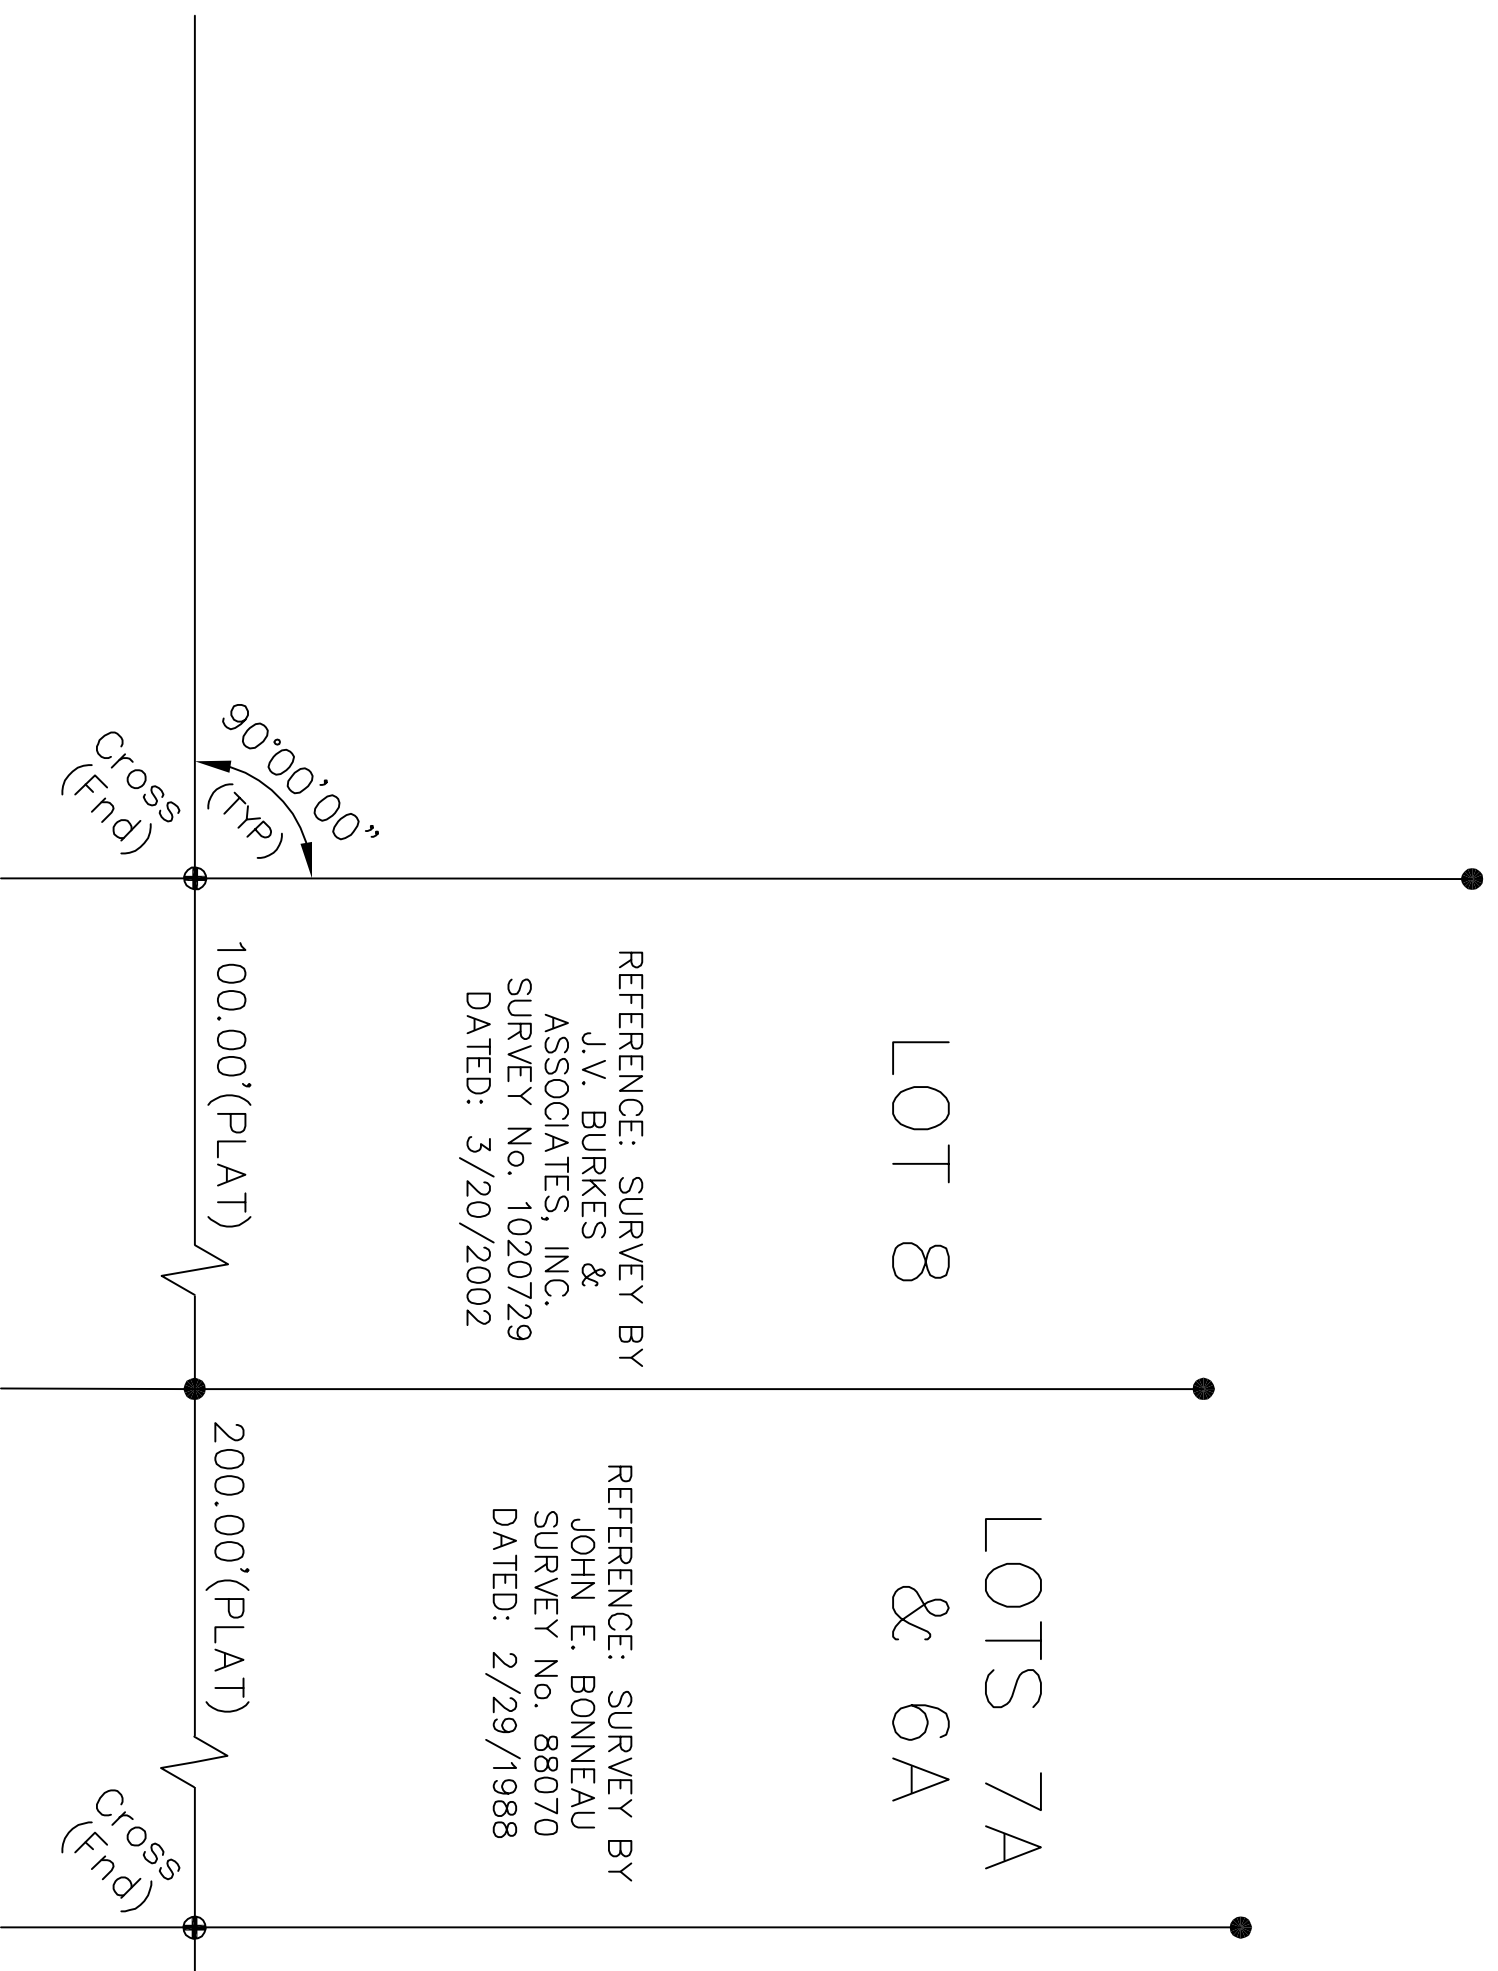

PONCHARTRAIN LAKE

PRIVATE CANAL "B"

FLOOD ZONE
V15 BFE 16

FLOOD ZONE
V15 BFE 17